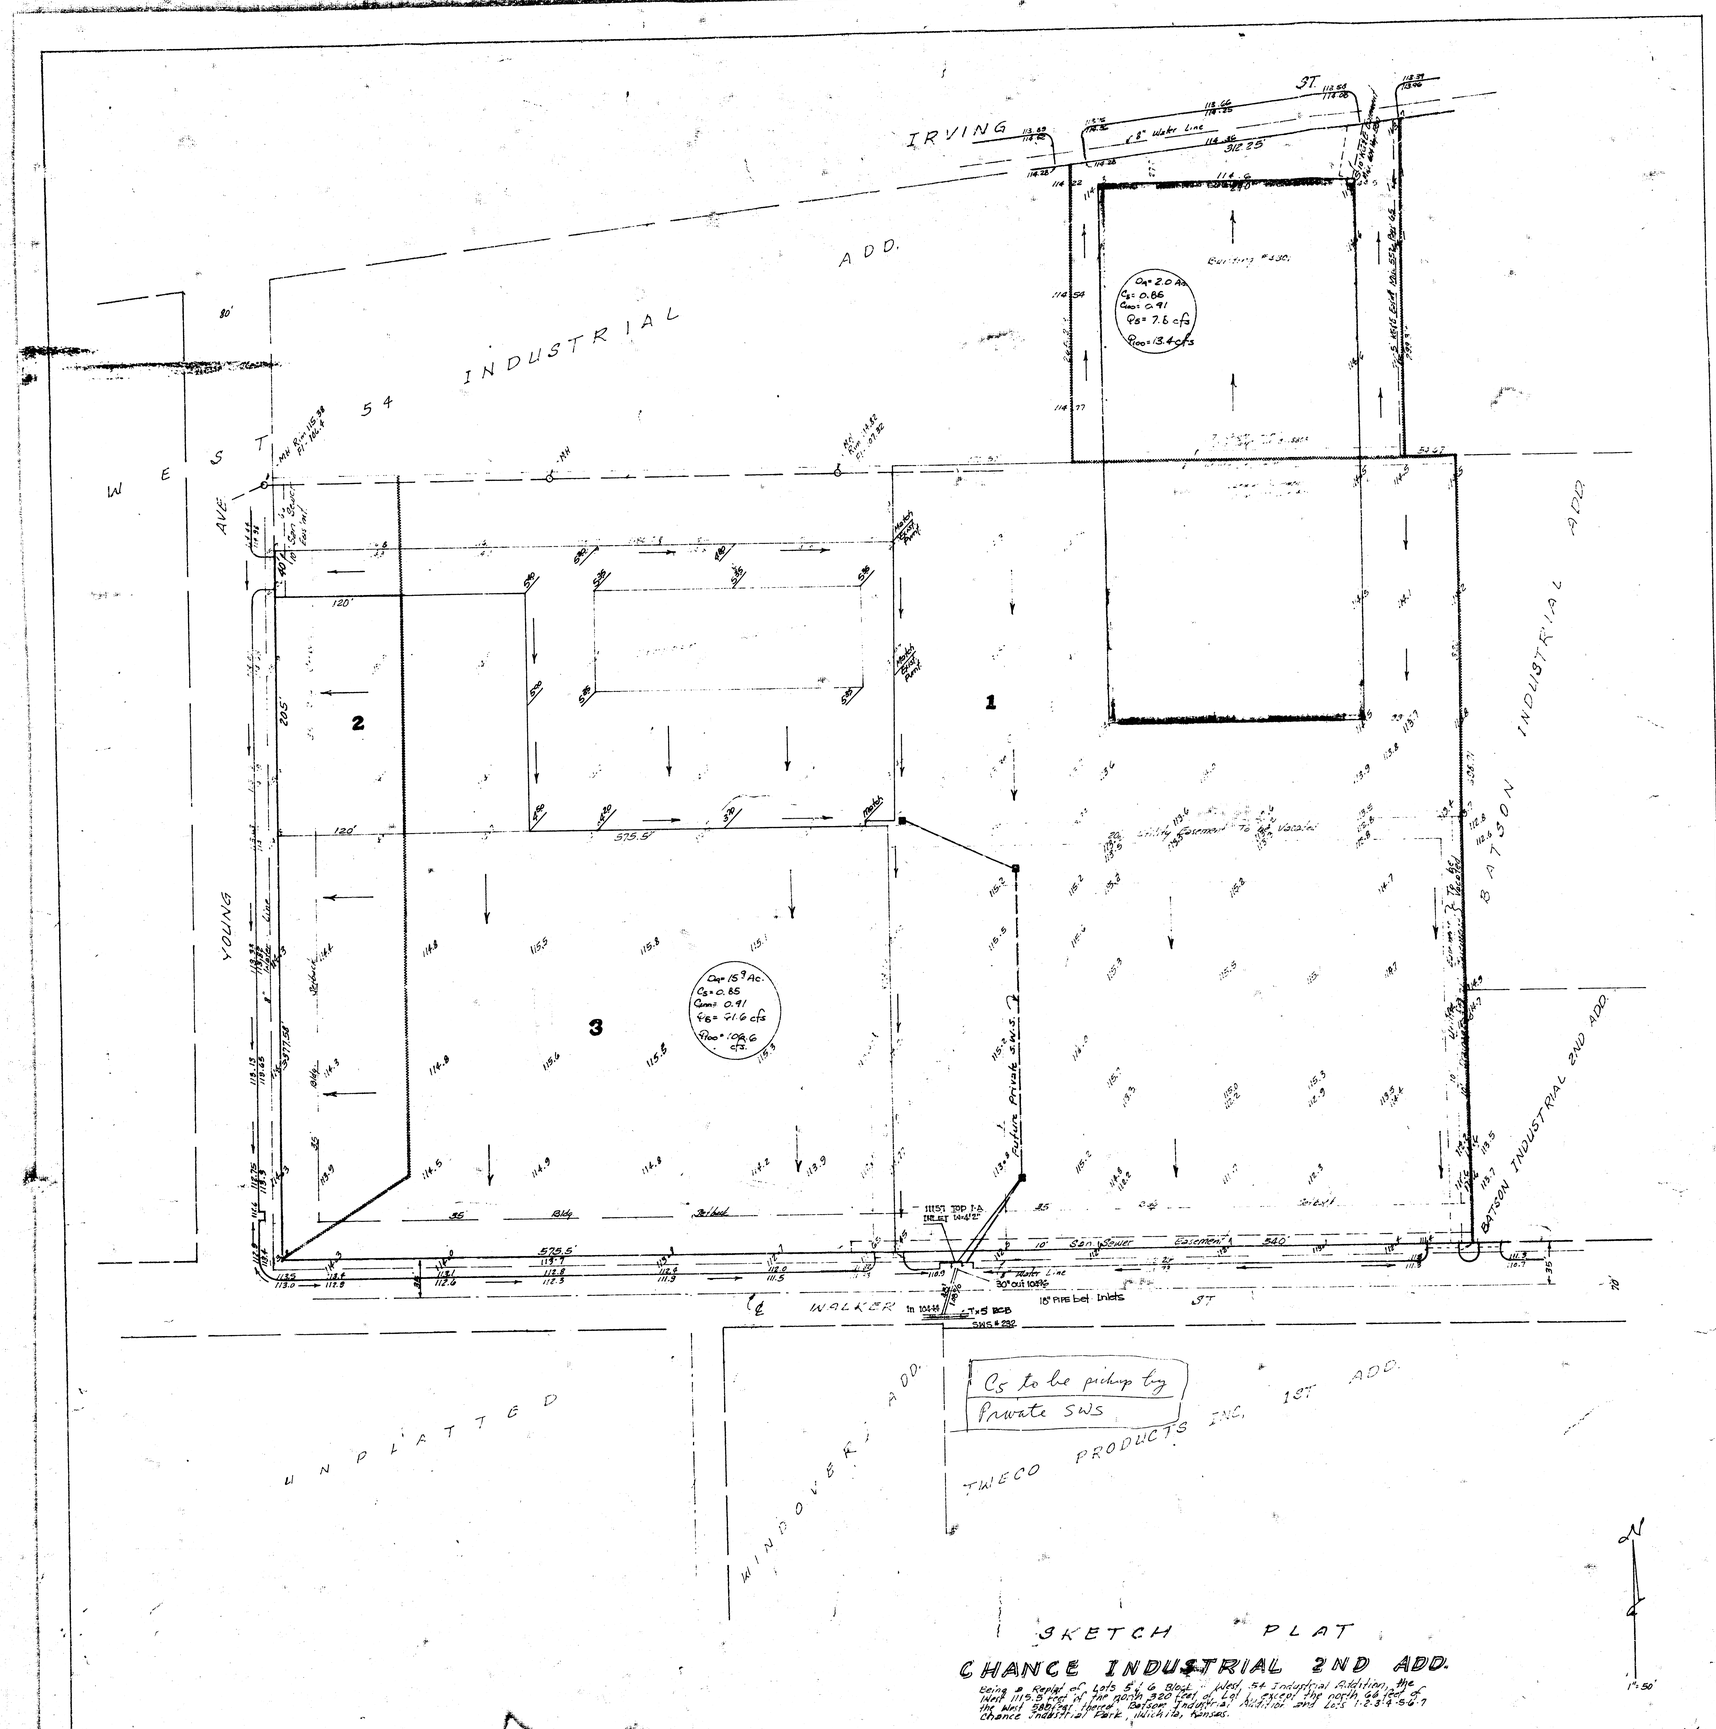


SKETCH PLAT

CHANCE INDUSTRIAL 2ND ADD.


CHANCE PROPERTIES - CITY OF WICHITA **DRAINAGE PLAN** 10/26/81 12-17-81