
Chapman's Replat.
(Drainage)

PRELIMINARY PLAT

CHAPMAN 'S REPLAT

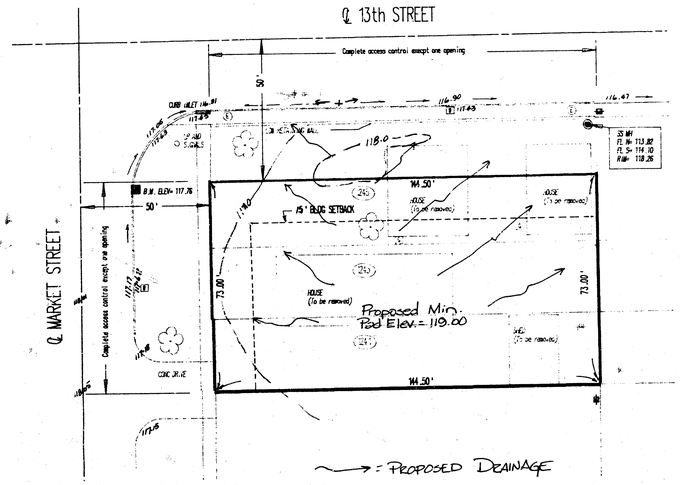

SCALE: 1"=20'

LEGEND

- TREE
- POWERPOLE
- SANITARY SEWER MANHOLE
- ELECTRICAL MANHOLE
- WATER METER
- GAS METER


AREA - 0.242 Acres

ZONING - LC

OWNER - Patrick Chapman
1601 N. Woodlawn
Wichita, Kansas

ENGINEER - Dobler-Surveying & Engineering
702 E. 21st Street
Wichita, Kansas

SURVEYED - 4/28/88

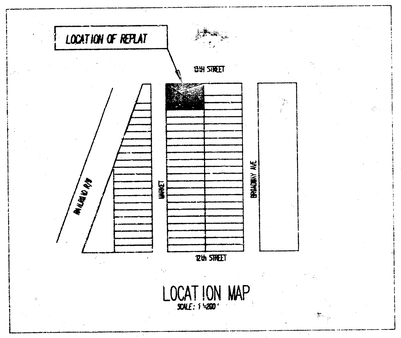

LOCATION MAP
SCALE: 1"=200'

May 19, 1988

DOBLER
SURVEYING & ENGINEERING
Wichita - KANSAS - Hamilton