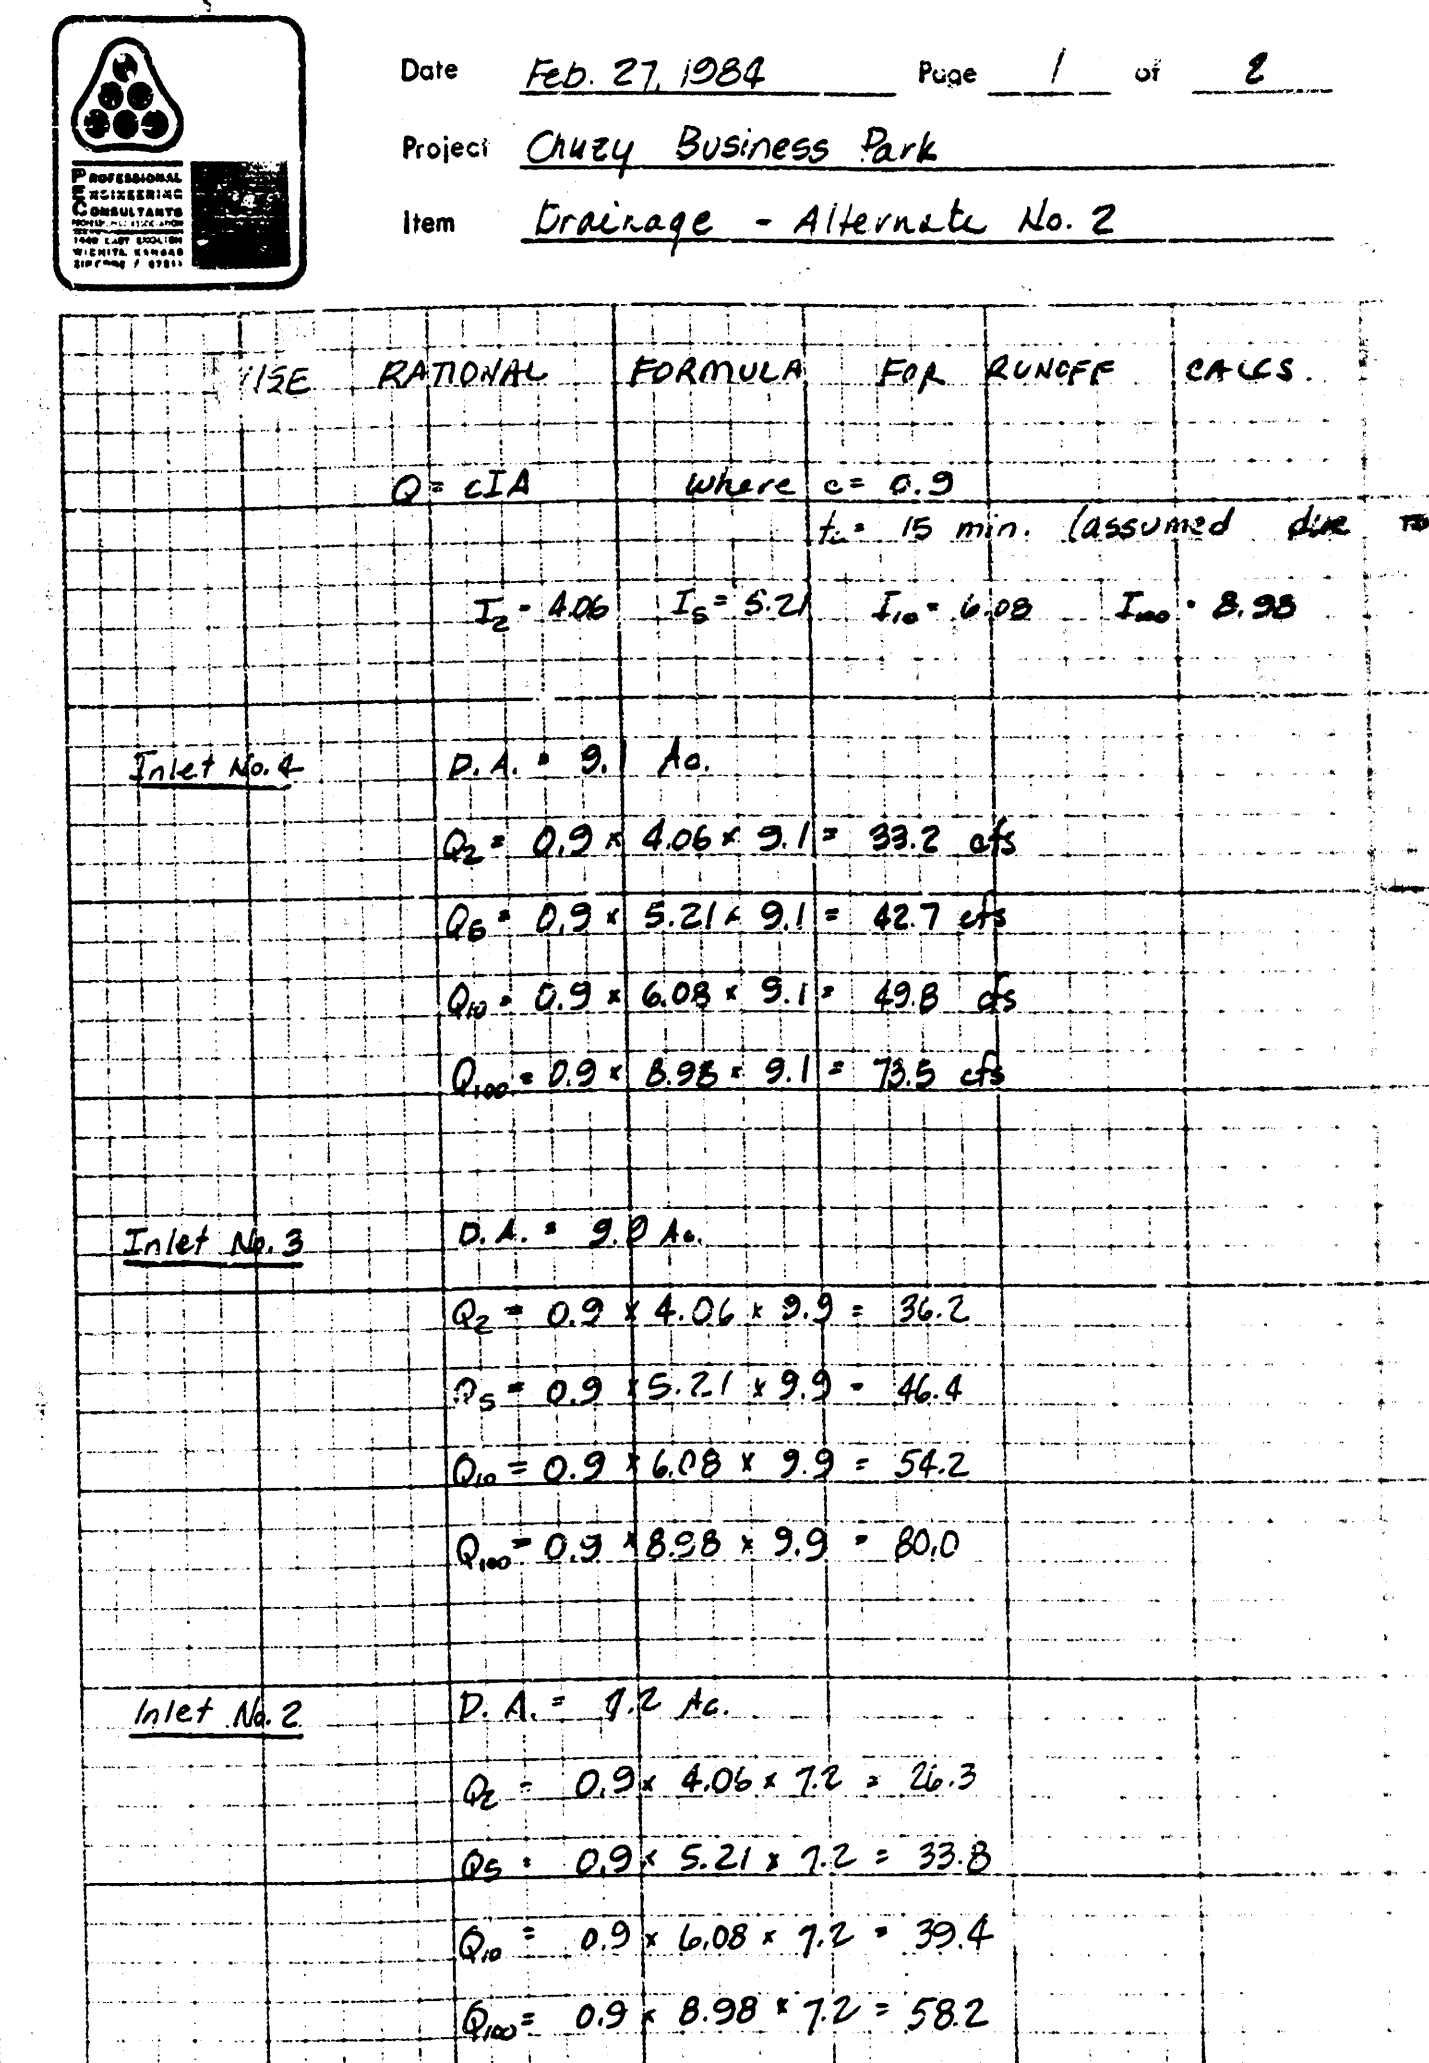
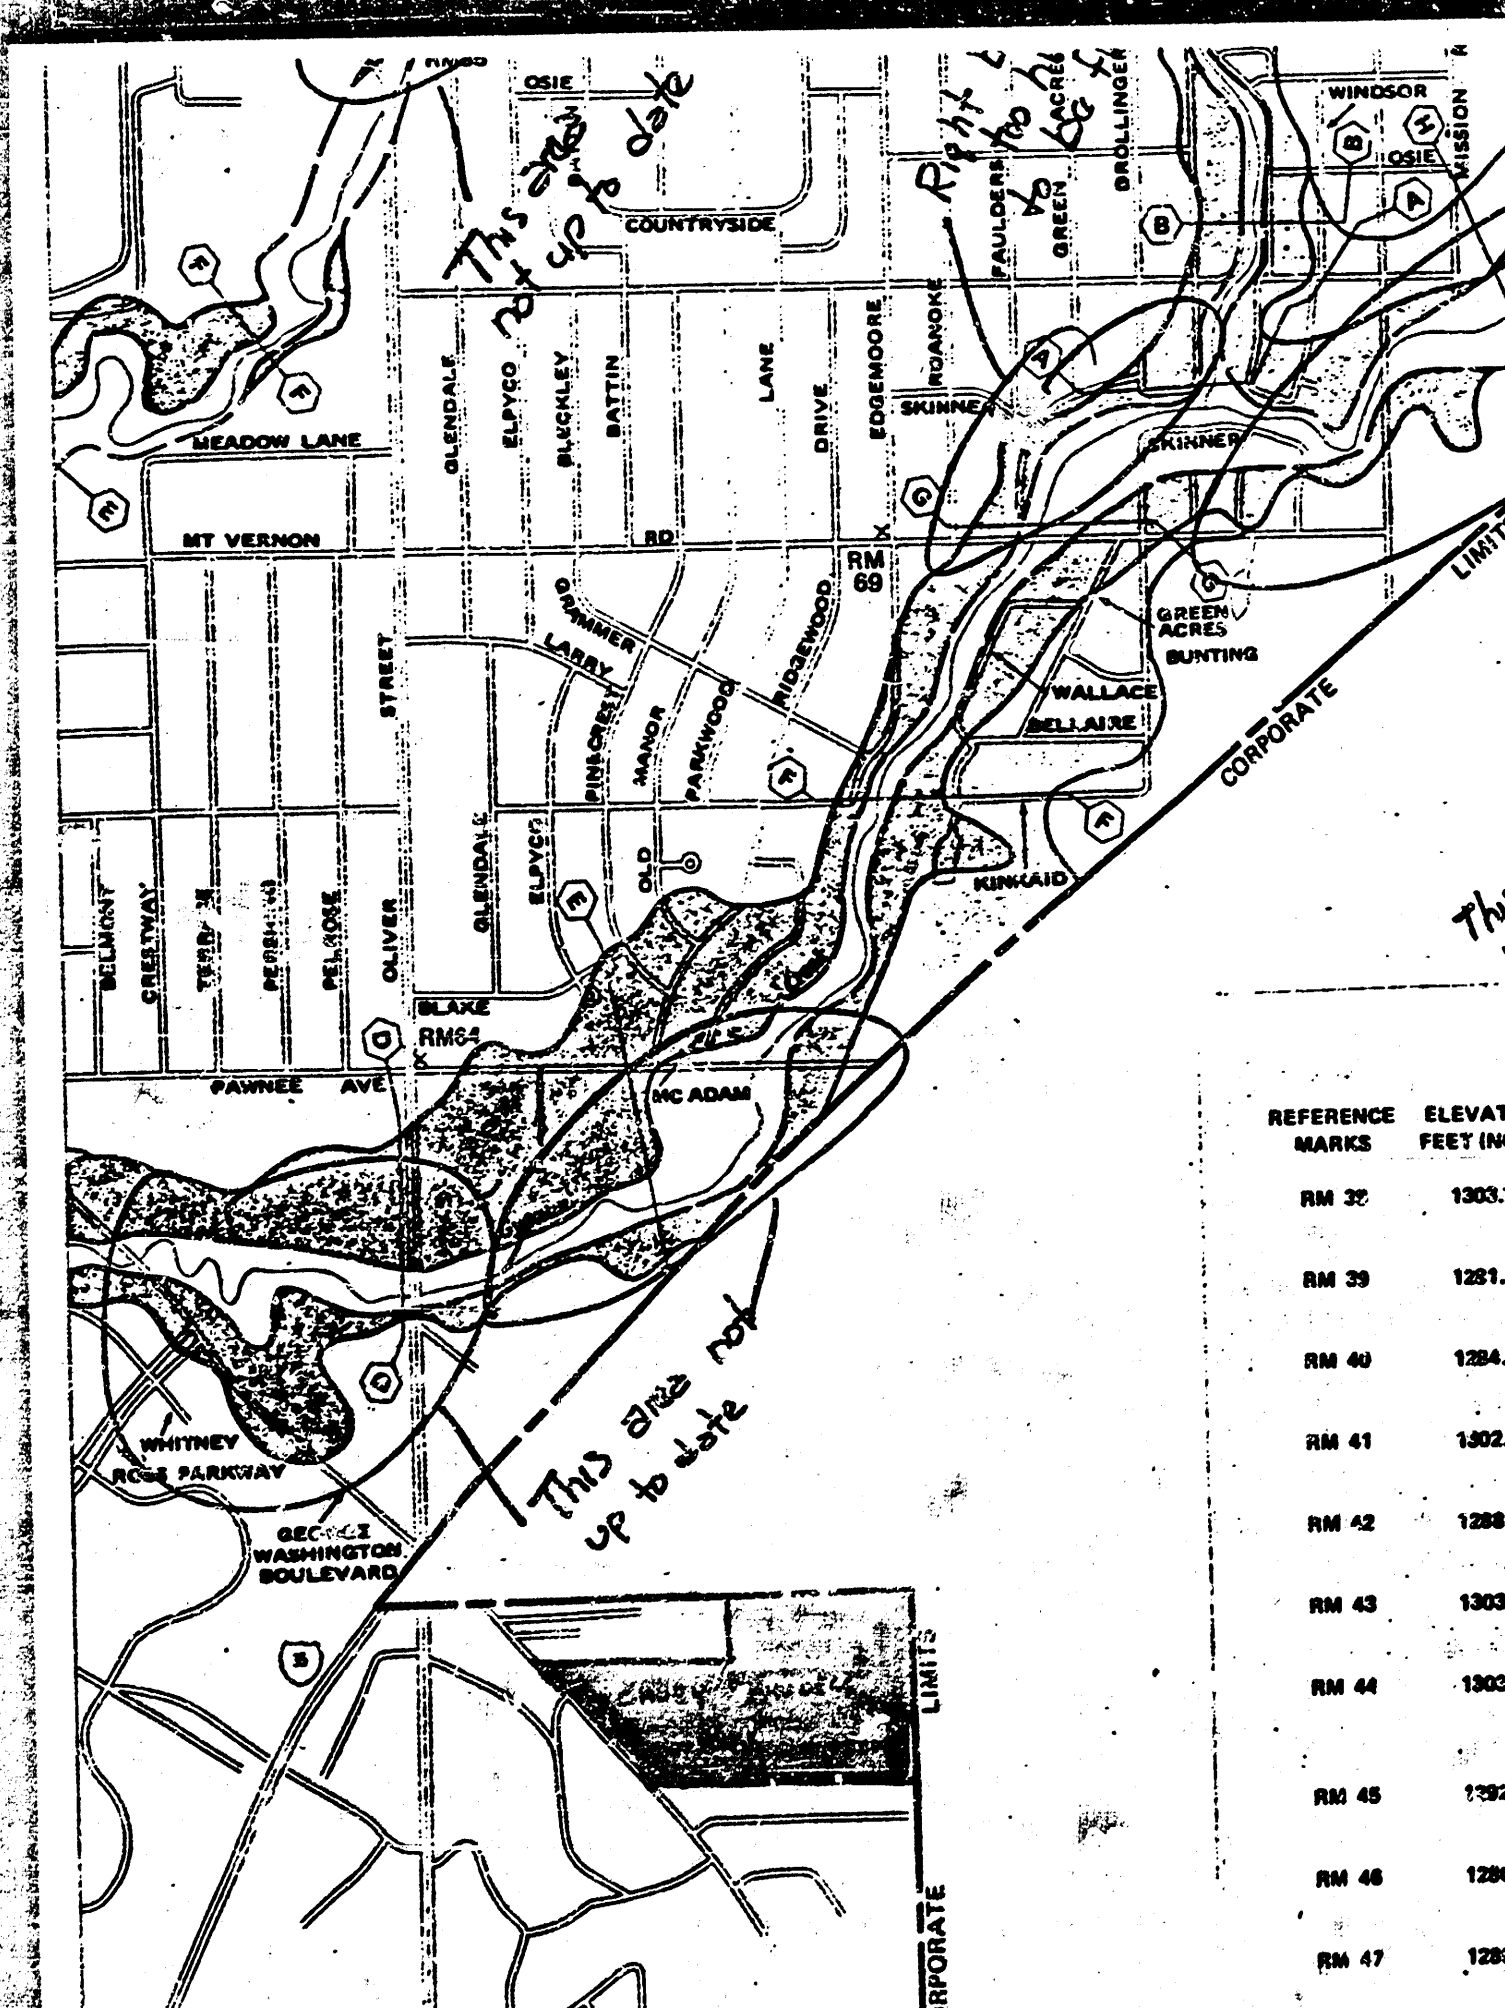


Transmitted herewith are two copies of the Drainage Plan and supporting calculations for the proposed Chazy Business Park Addition to Wichita.

The Preliminary Plat will be submitted to MAPD on March 2, 1984, for hearing by MAPC Subdivision Committee on March 15, 1984.

If you have any questions or need any additional information, please advise.

[illegible][illegible][illegible][illegible]


 Date Feb. 27, 1984 Page 1 of 1
 Project Chazy Business Park
 Item Drainage

Check Capacity of Existing Box RCB @ George Washington Blvd.
 Inlet Control Height of Box (D) = 3'
 Allowable HW elev. = 133.8'
 R Box = 129.36
 HW = 133.8 - 129.36 = 4.44' say 4.5
 R_{in} D = 4.5/3 = 1.5
 From Chart 1 attached, Q/B = .83 cfs/foot
 Total capacity = 22.5/foot x B' = 184 cfs

