COLEMAN ACRES
(Drainage)

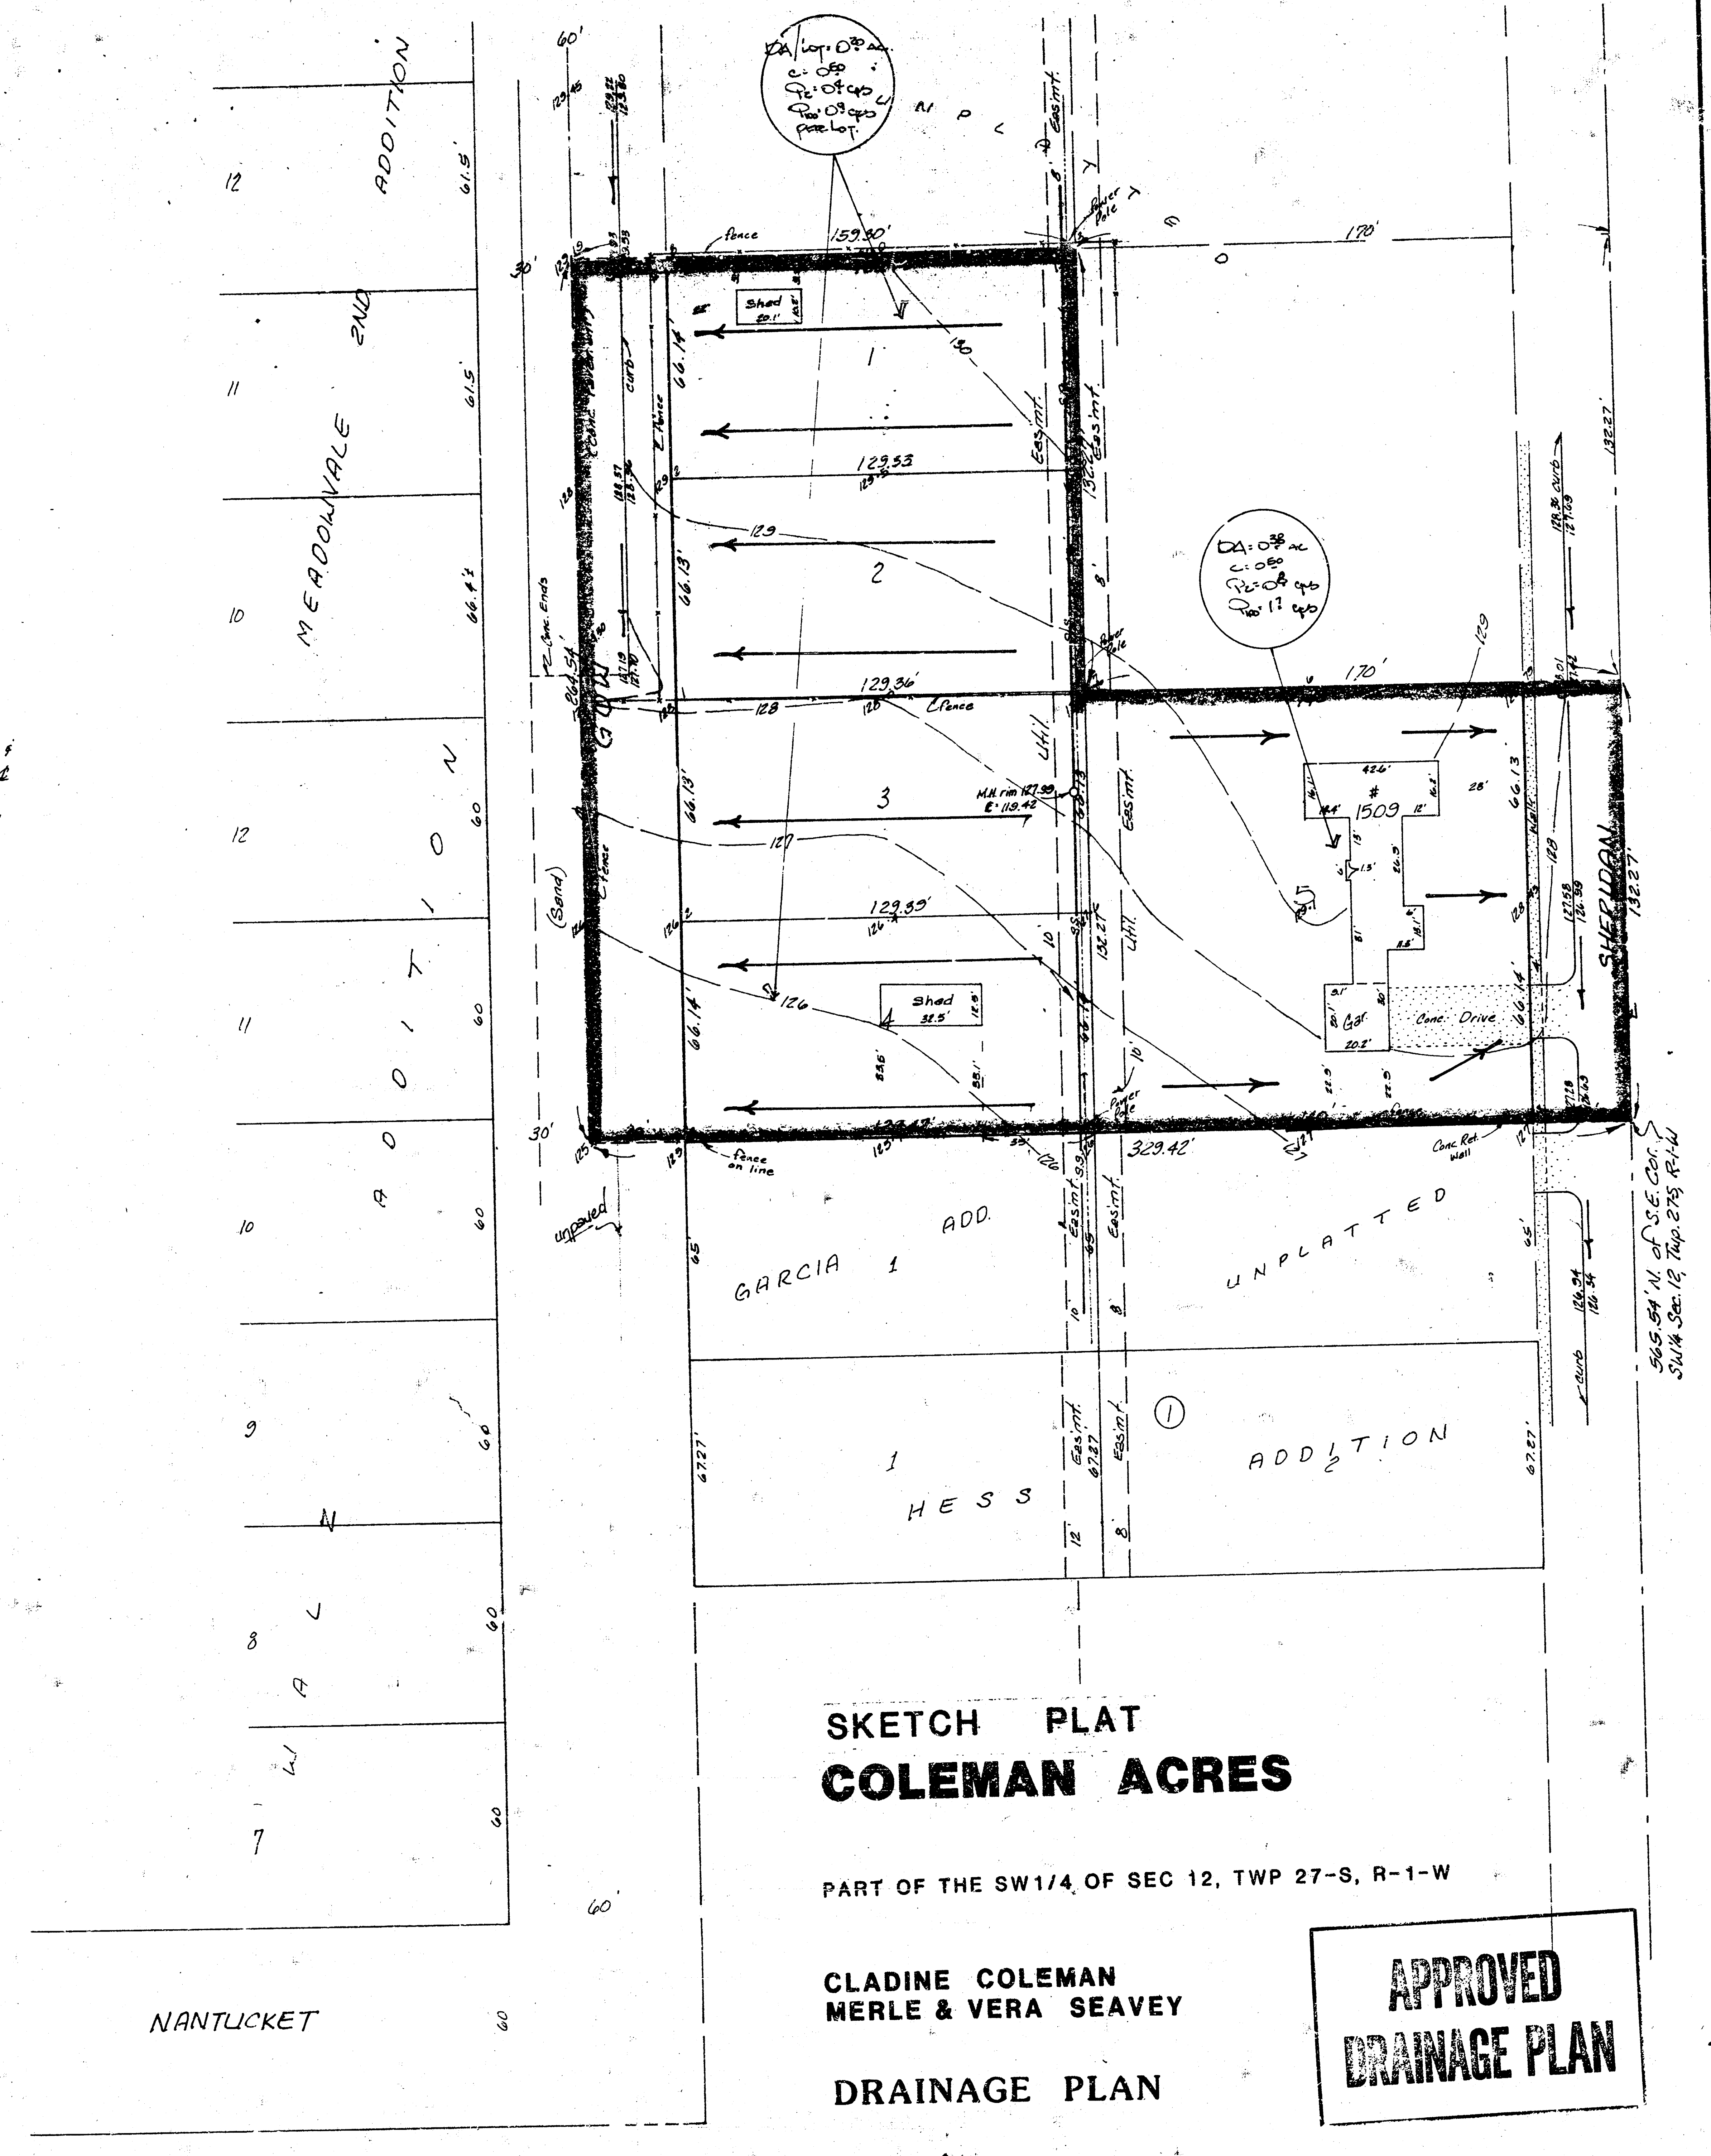
MEADOWVALE 2ND ADDITION
GARCIA 1 ADD.
UNPLATTED
HESS ADDITION
SHERIDAN
NANTUCKET
1
2
3
4
Shed
1509
Conc. Drive
Gar.
159.80'
170'
129.33'
129.36'
129.35'
329.42'
Easmt.
Fence
Power Pole
unpaved
60'
30'
12
11
10
9
8
7

N

1" = 30'
Elev. = City Datum

BENCH MARK:
City Standard Disc. 29.5' east &
23.5' south of intersection of ℄
Sheridian & ℄ of 13th St. No.
Elevation = 125.72 City Datum

SKETCH PLAT
COLEMAN ACRES

PART OF THE SW1/4 OF SEC 12, TWP 27-S, R-1-W

CLADINE COLEMAN
MERLE & VERA SEAVEY

DRAINAGE PLAN

APPROVED
DRAINAGE PLAN

BAUGHMAN COMPANY, P.A.
SURVEYING & ENGINEERING
316/262-7271 · 330 LAURA · WICHITA, KANSAS 67211

25 MAY 86

FILMED FROM THE BEST
AVAILABLE COPY