


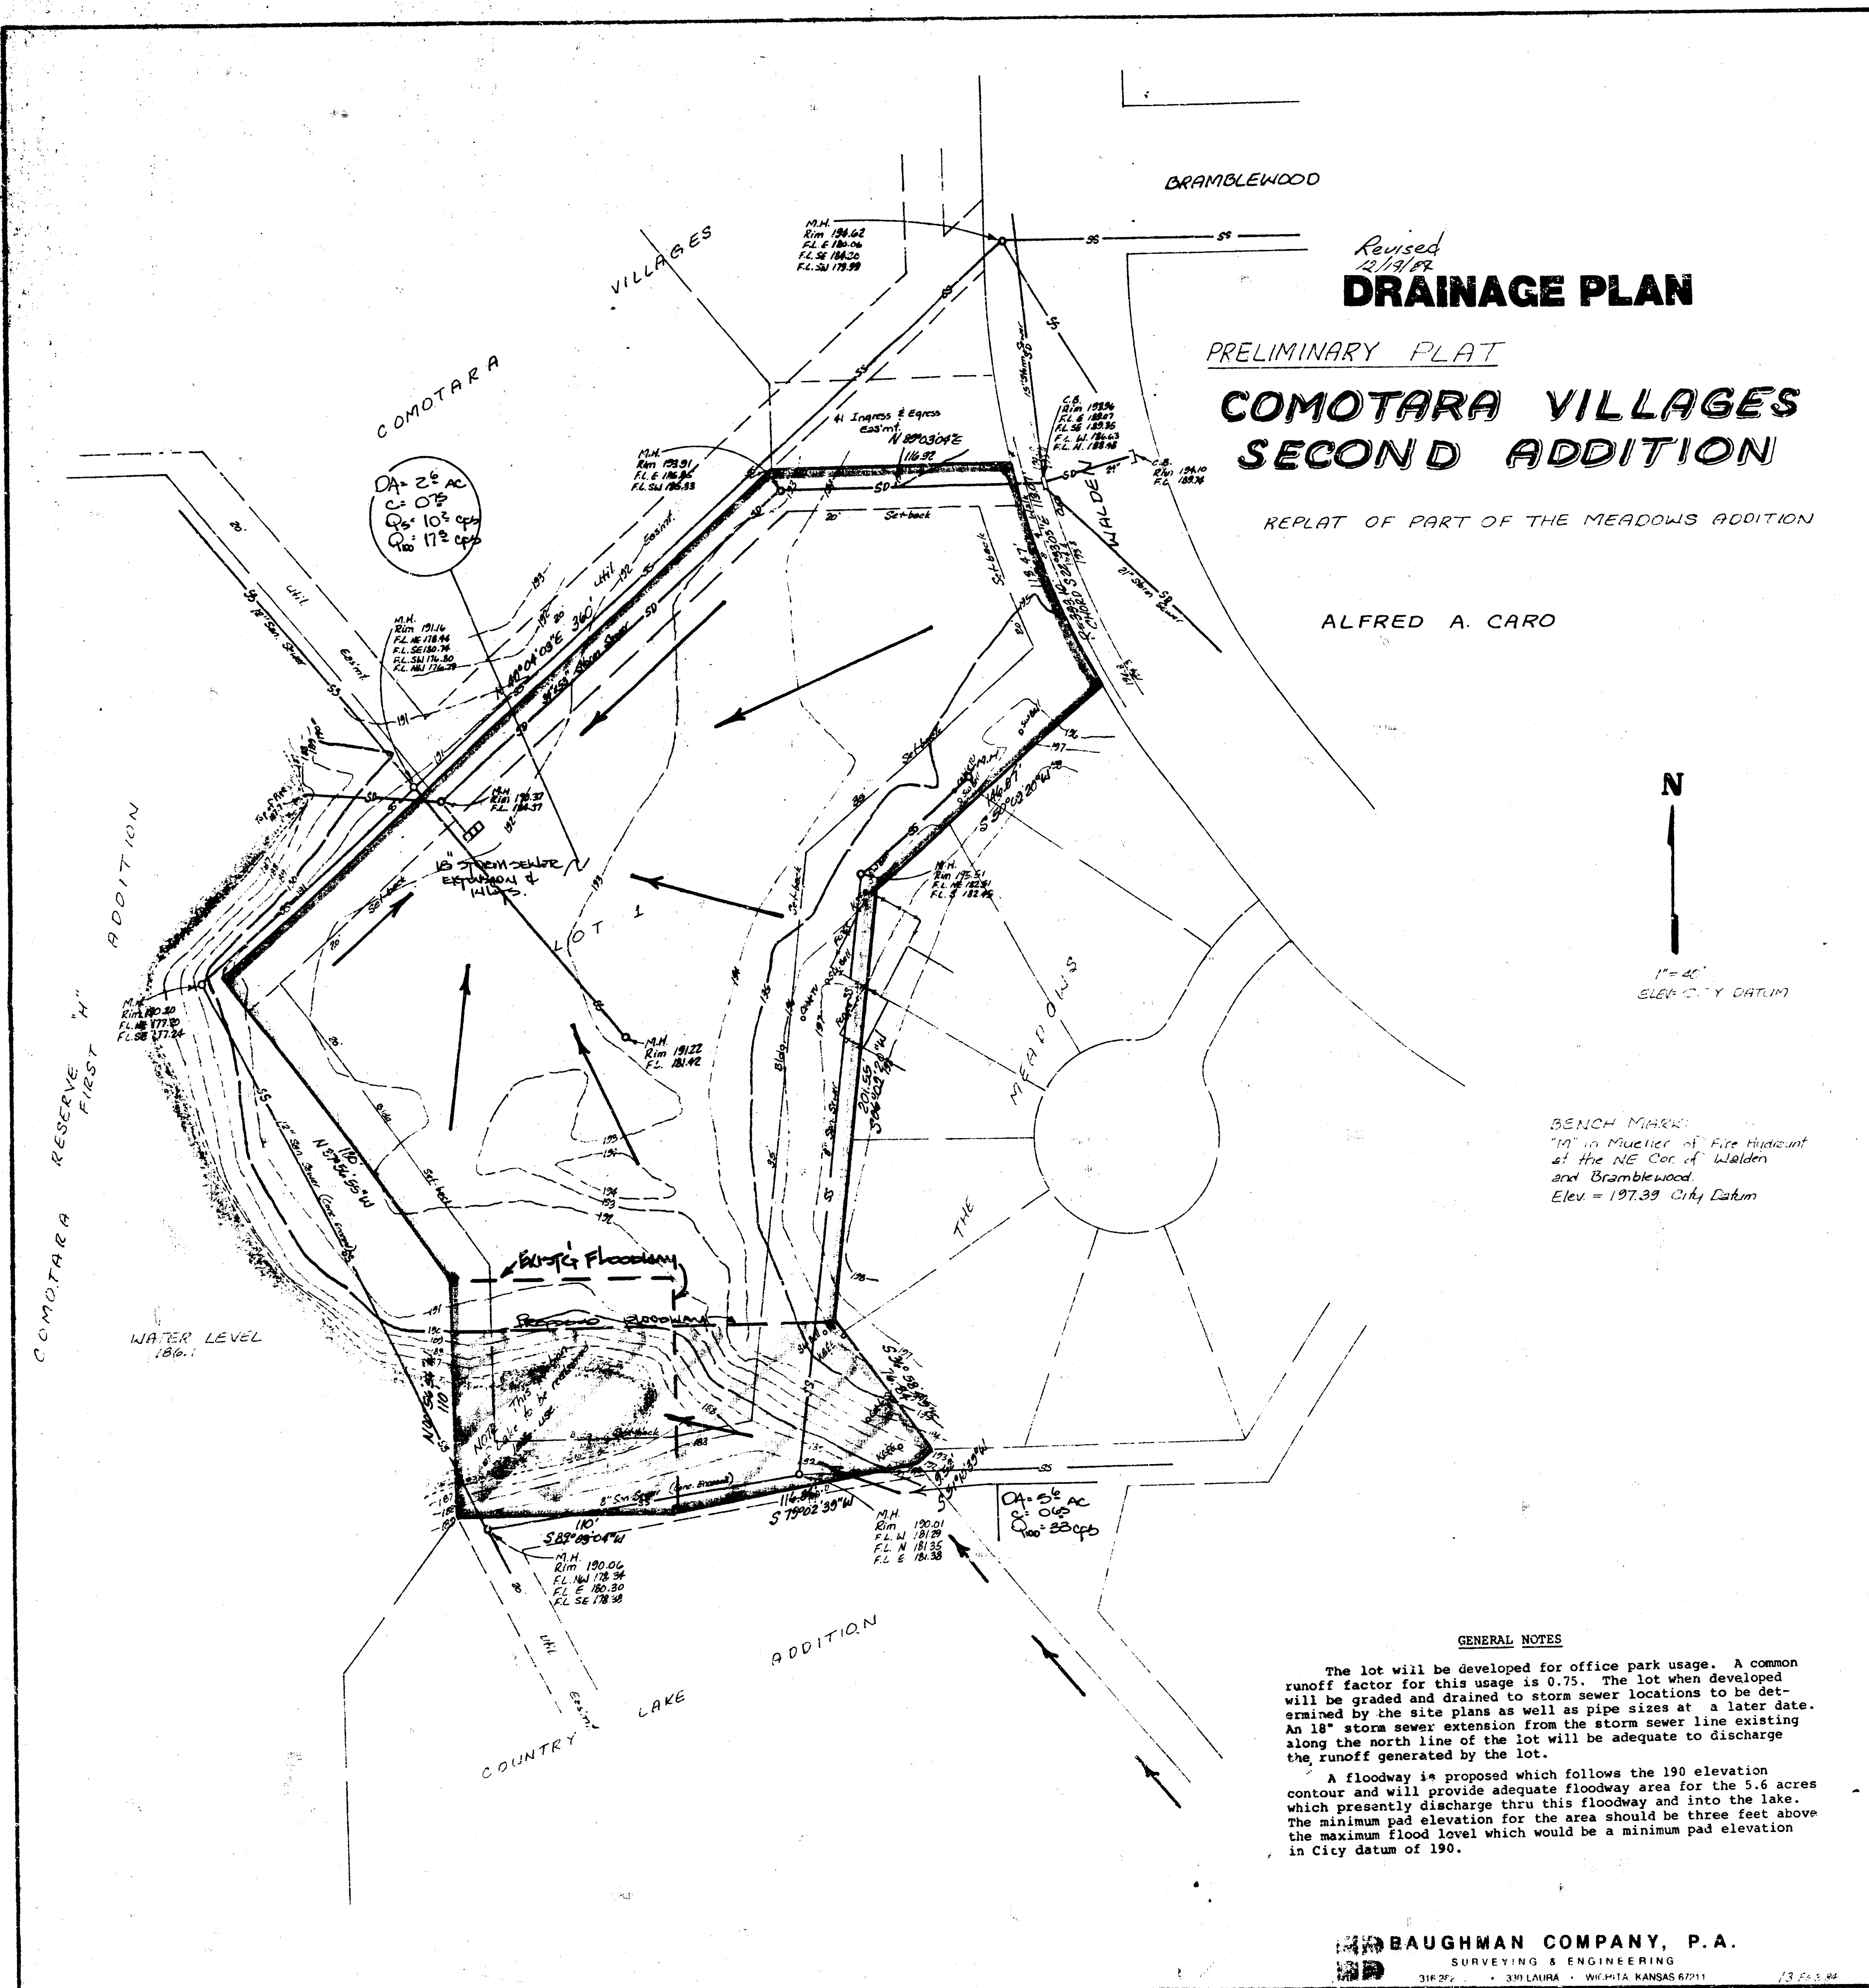

FILMED FROM THE BEST
AVAILABLE COPY