


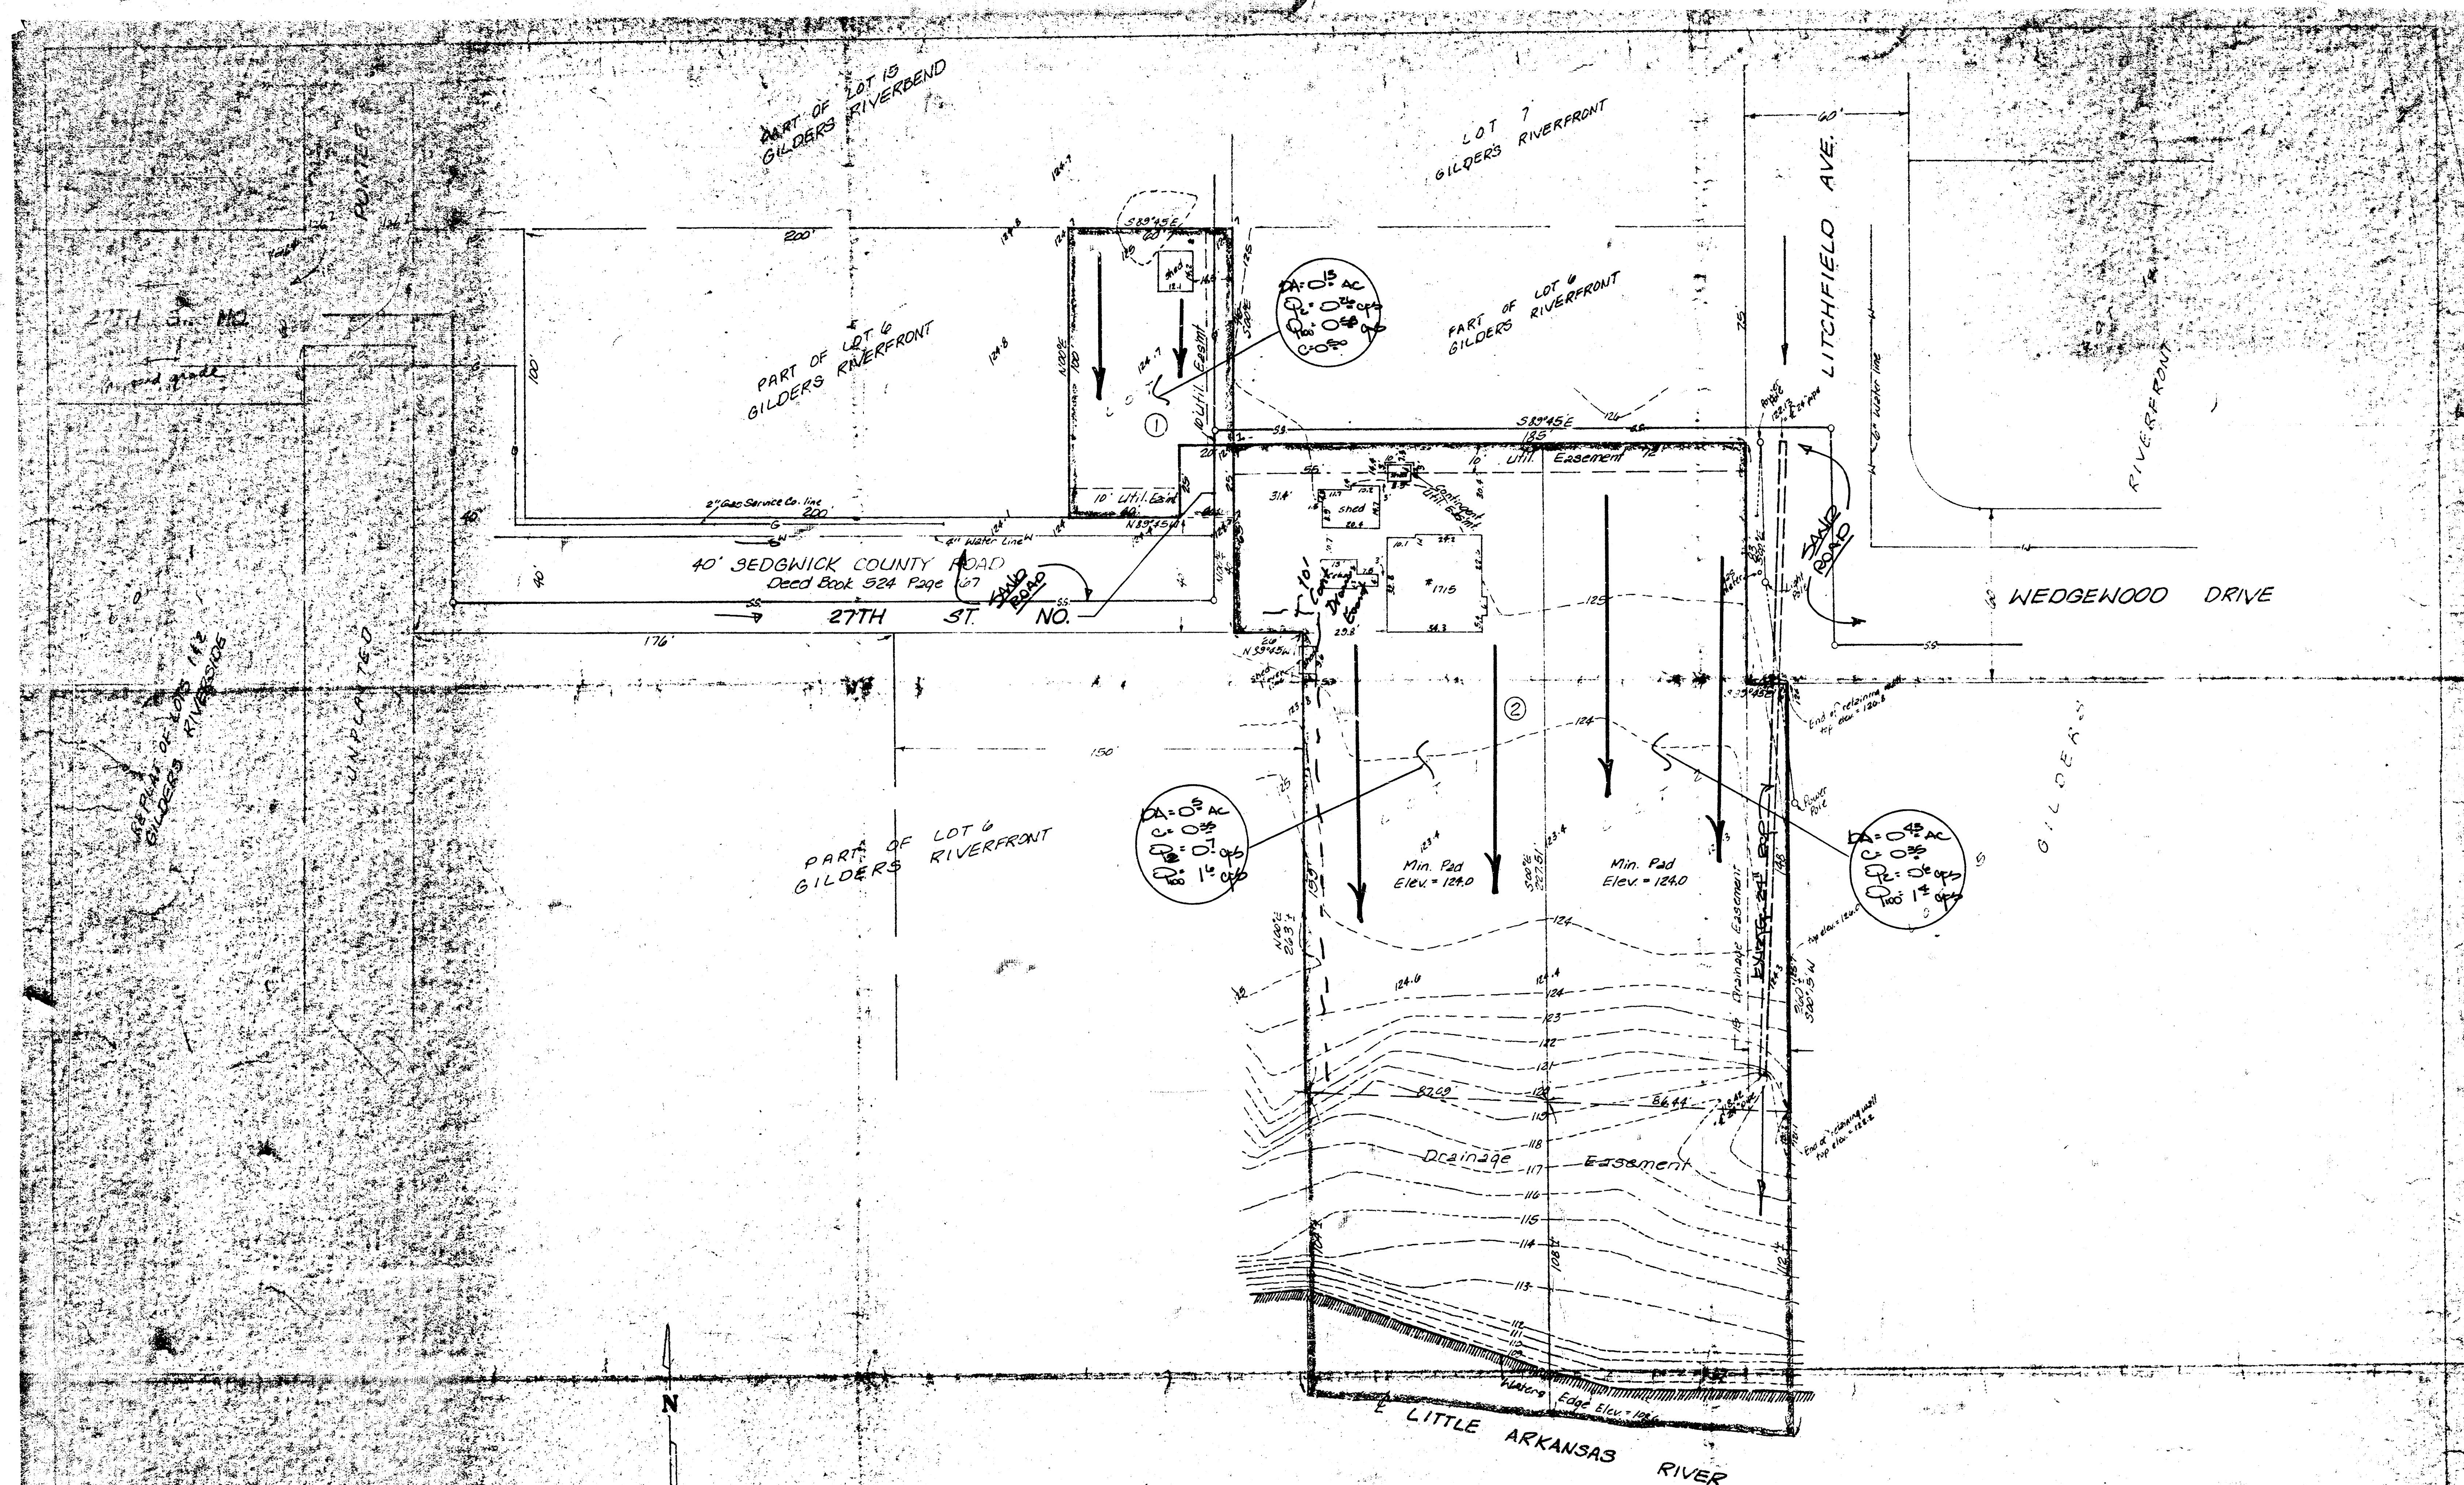

Bench mark:
City disc. 44.5 feet south &
40.8 feet west of centerlines of
27th St. No. & Armiton
Elev. = 127.22 City Datum

NOTE - Lots will be graded and filled
as necessary to drain south to
the river.
Runoff factors for Lots 1 & 2.
Lot 2 will be 0.35. Lot 1 will
be 0.50.

DRAINAGE PLAN

SKETCH PLAT

~~WANDA'S ADDITION~~ FRED COOK ADDITION

PART OF LOT 6, GILDERS RIVERFRONT
ADDITION, SEDGWICK COUNTY, KANSAS

OWNER
WANDA COOK

FILMED FROM THE BEST
AVAILABLE COPY

BAUGHMAN COMPANY, P.A. Revised April 27, 1964
316/240, 317/240, 320/240, 321/240, 322/240, 1000/240