


CORRIGAN ADDITION
(DRAINAGE)


[illegible]

WICHITA, SEDGWICK COUNTY, KANSAS

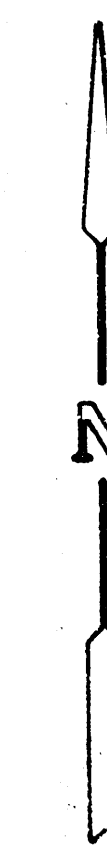

SCALE: 1" = 30'

ORLINES:
BRIAN E & MARY ANN CORRIGAN
6318 LEGION
WICHITA, KS. 67204

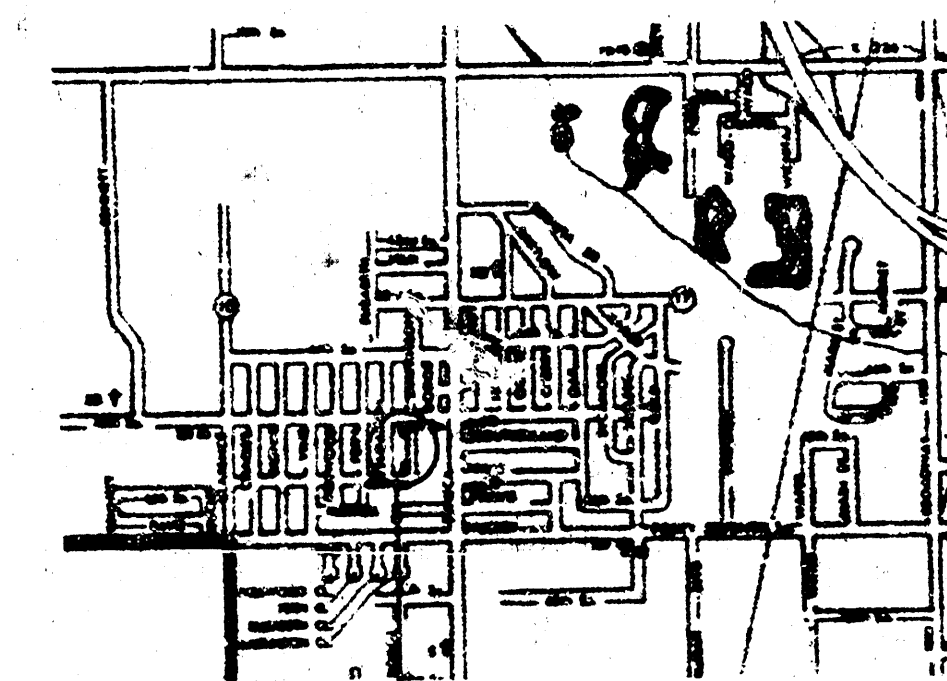

— CORRIGAN ADDITION

UTILITIES:
OVERHEAD ELECTRIC AND UNDERGROUND
TELEPHONE LOCATED IN IL UTILITY
EASEMENT, BLOCK 24, PURCELL'S 11TH ADDITION

SAN SEWER

MANHOLE #1 - RING 8725

OUT - EAST	73.73
IN - WEST	73.77
IN - NORTH	75.27
IN - SOUTH	75.36

MANHOLE #2 RING - 86.59
MANHOLE UNDER FENCE UNABLE TO
OPEN

MANHOLE #3 RING - 86.44
NOT SHOWN OUT-NORTH 82.18
65' SOUTH OF IN-EAST 82.39
MANHOLE #2

TOPOGRAPHIC SURVEY - 5/27/83
BENCH MARK - CITY DISC. 47TH ST 30' SENECA
ELEV = 873.3'

PREPARED BY:
AIR CAPITOL LAND SURVEYORS
Bldg. 41, 21st St.
Wichita, KS 67203

**FILMED FROM THE BEST
AVAILABLE COPY.....**