


SKETCH PLAT DANKA ADDITION

WICHITA, SEDGWICK COUNTY, KANSAS

NORTHEAST EXPRESSWAY RIGHT-OF-WAY
(FROM S11, PAGE 732)

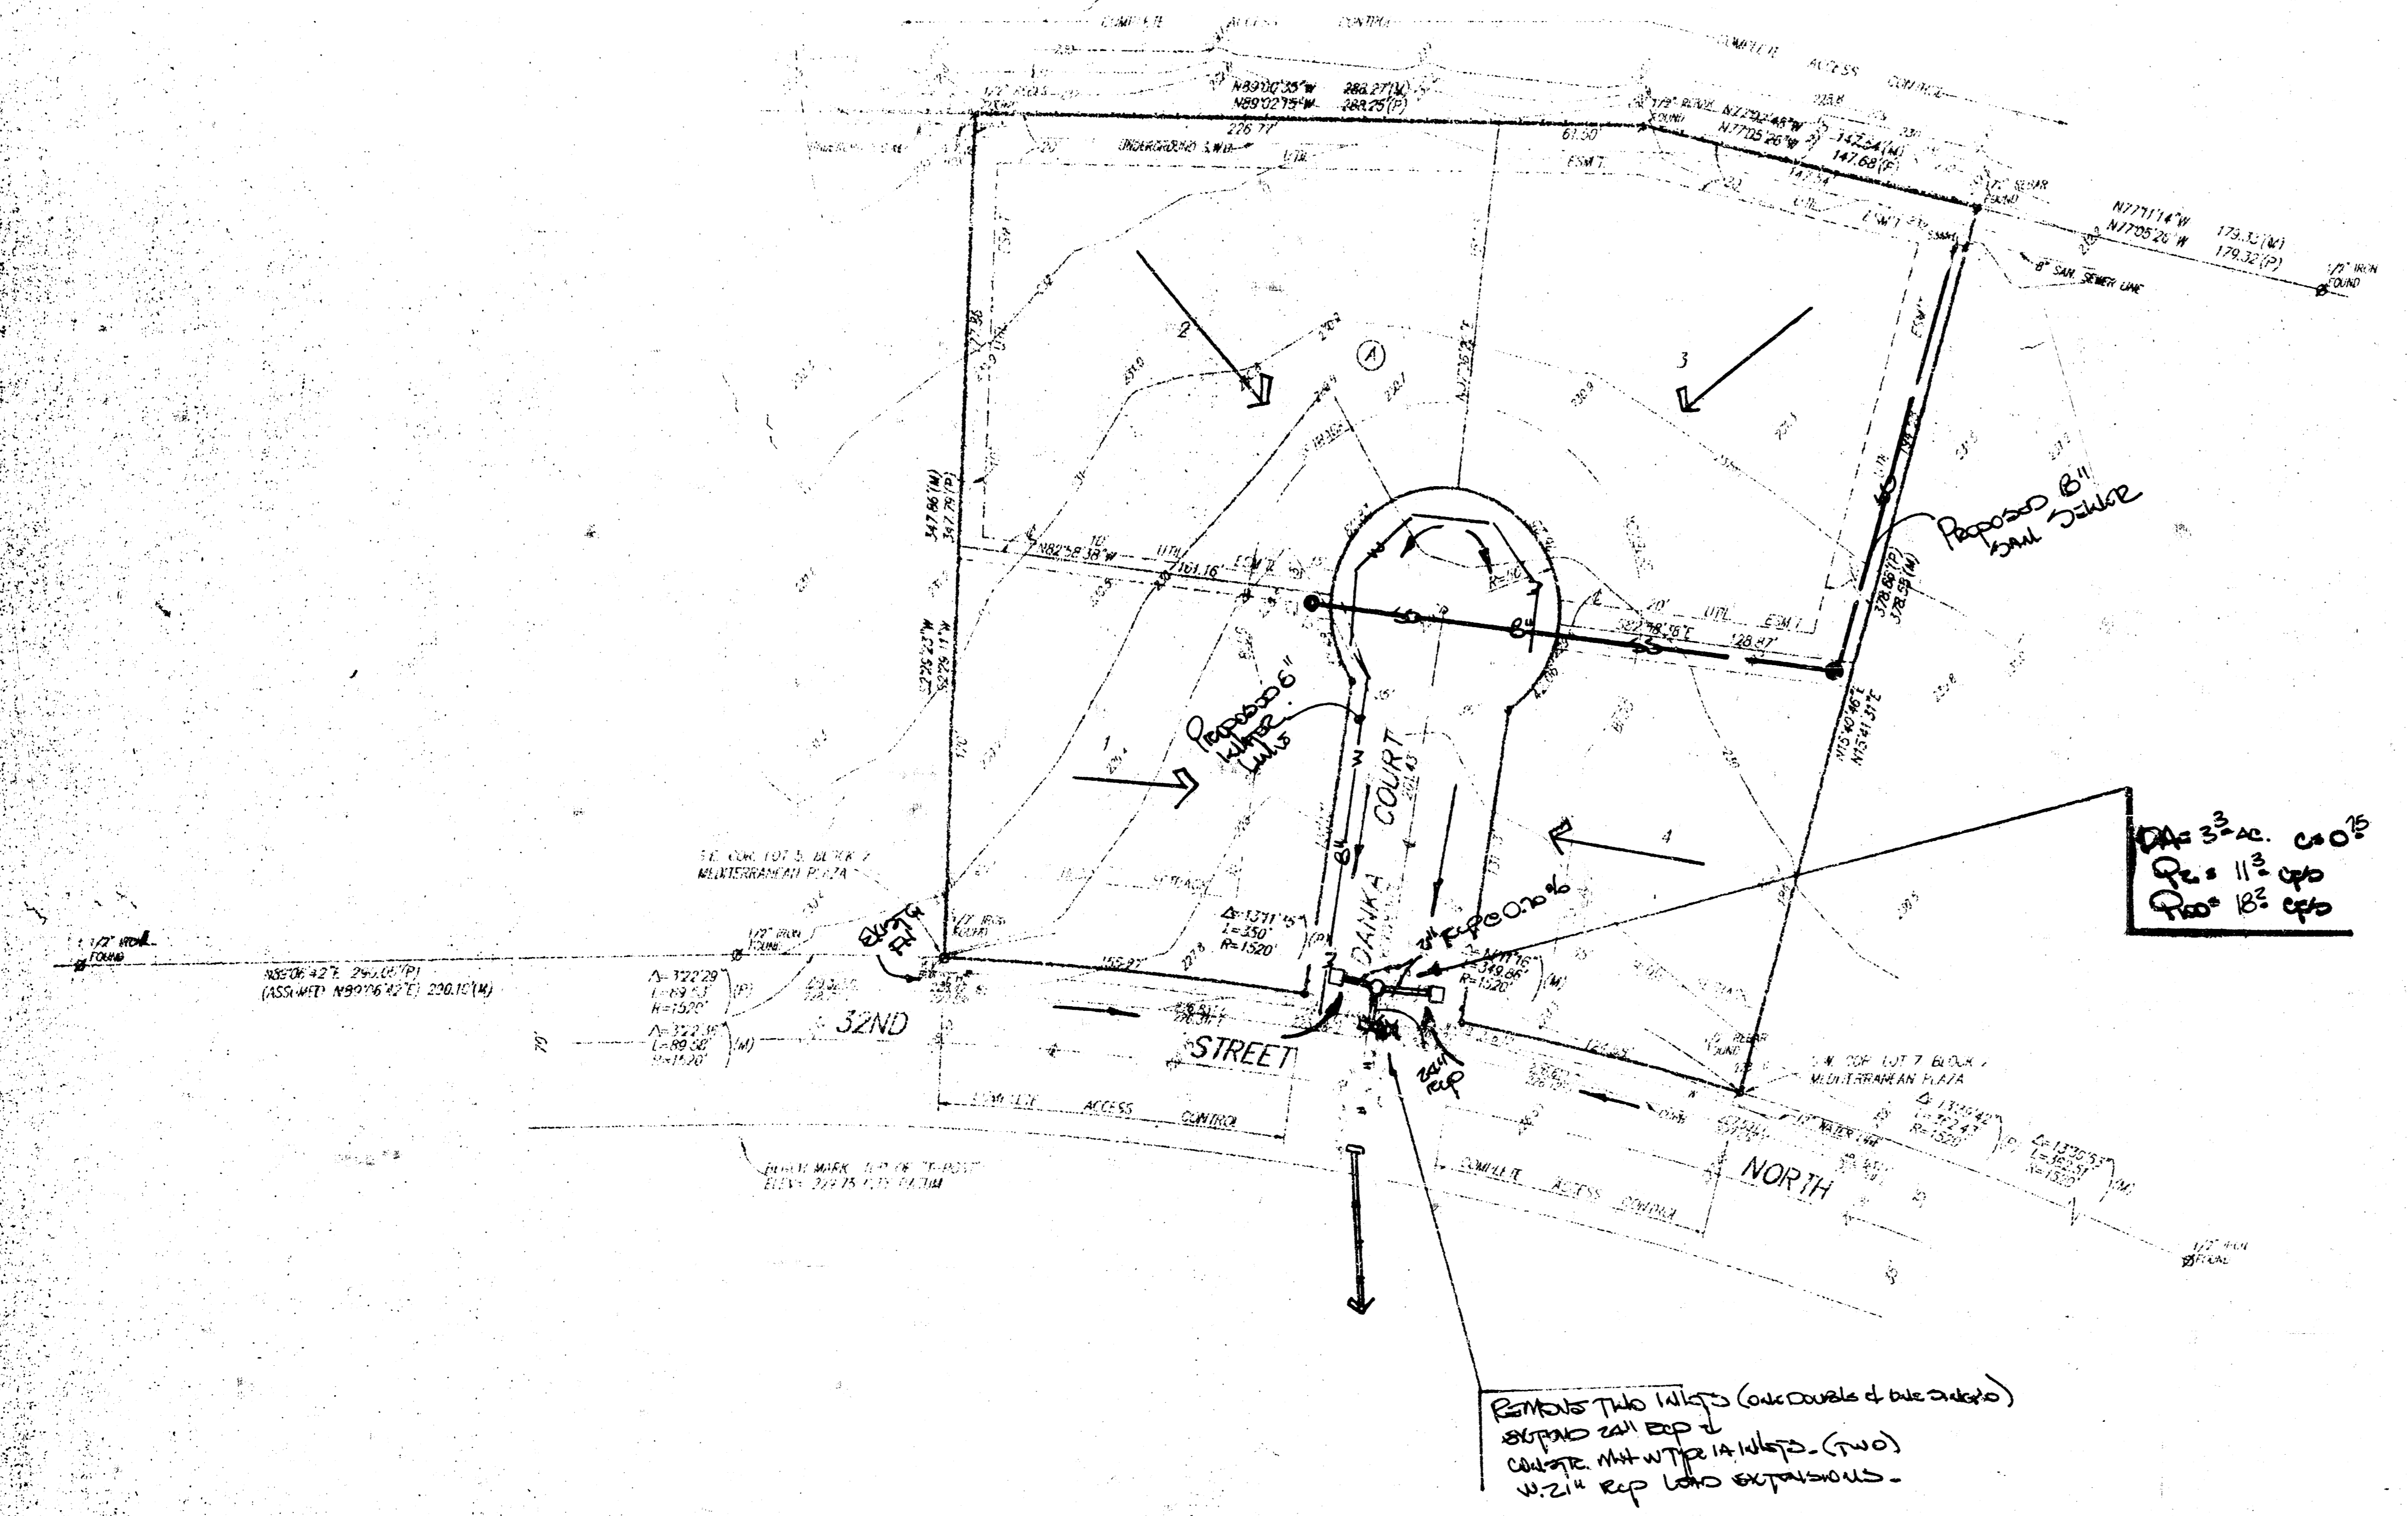

FOUND CORNERS ARE IN UNDEVELOPED
ORIGIN UNLESS IDENTIFIED ON SKETCH

(P) = PLATTED
(M) = MEASURED
BEARING BASE = ASSUMED


- = 1/2" REBAR W/ "RANGEMAN" CAP (P)
- ◻ = 1/2" IRON (FOUND)
- ▲ = 1/2" REBAR (FOUND)

OWNER:
M. E. DARGER & ASSOCIATES, INC.
5565 NORTH STREET NORTH
P. O. BOX 2244
ST. PETERS, MO. 65751-2244
PH: 613-821-5421

LEGAL DESCRIPTION:


ELEV. = 229.75 (1977 DATUM)

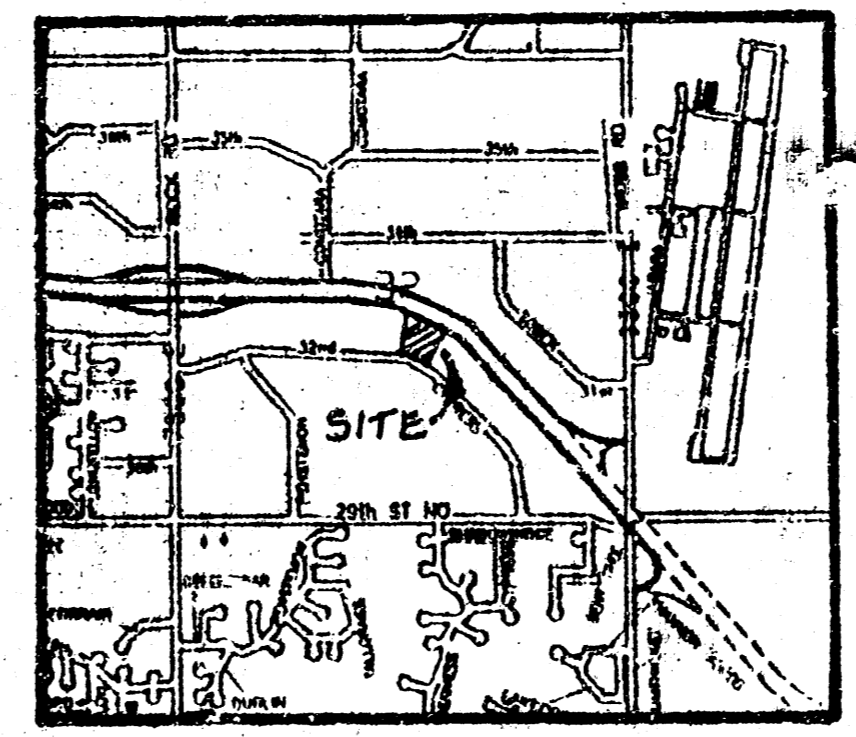

VICINITY MAP

DRAINAGE PLAN UTILITY PLAN