
SKETCH PLAT

DANKA ADDITION

WICHITA, SEDGWICK COUNTY, KANSAS

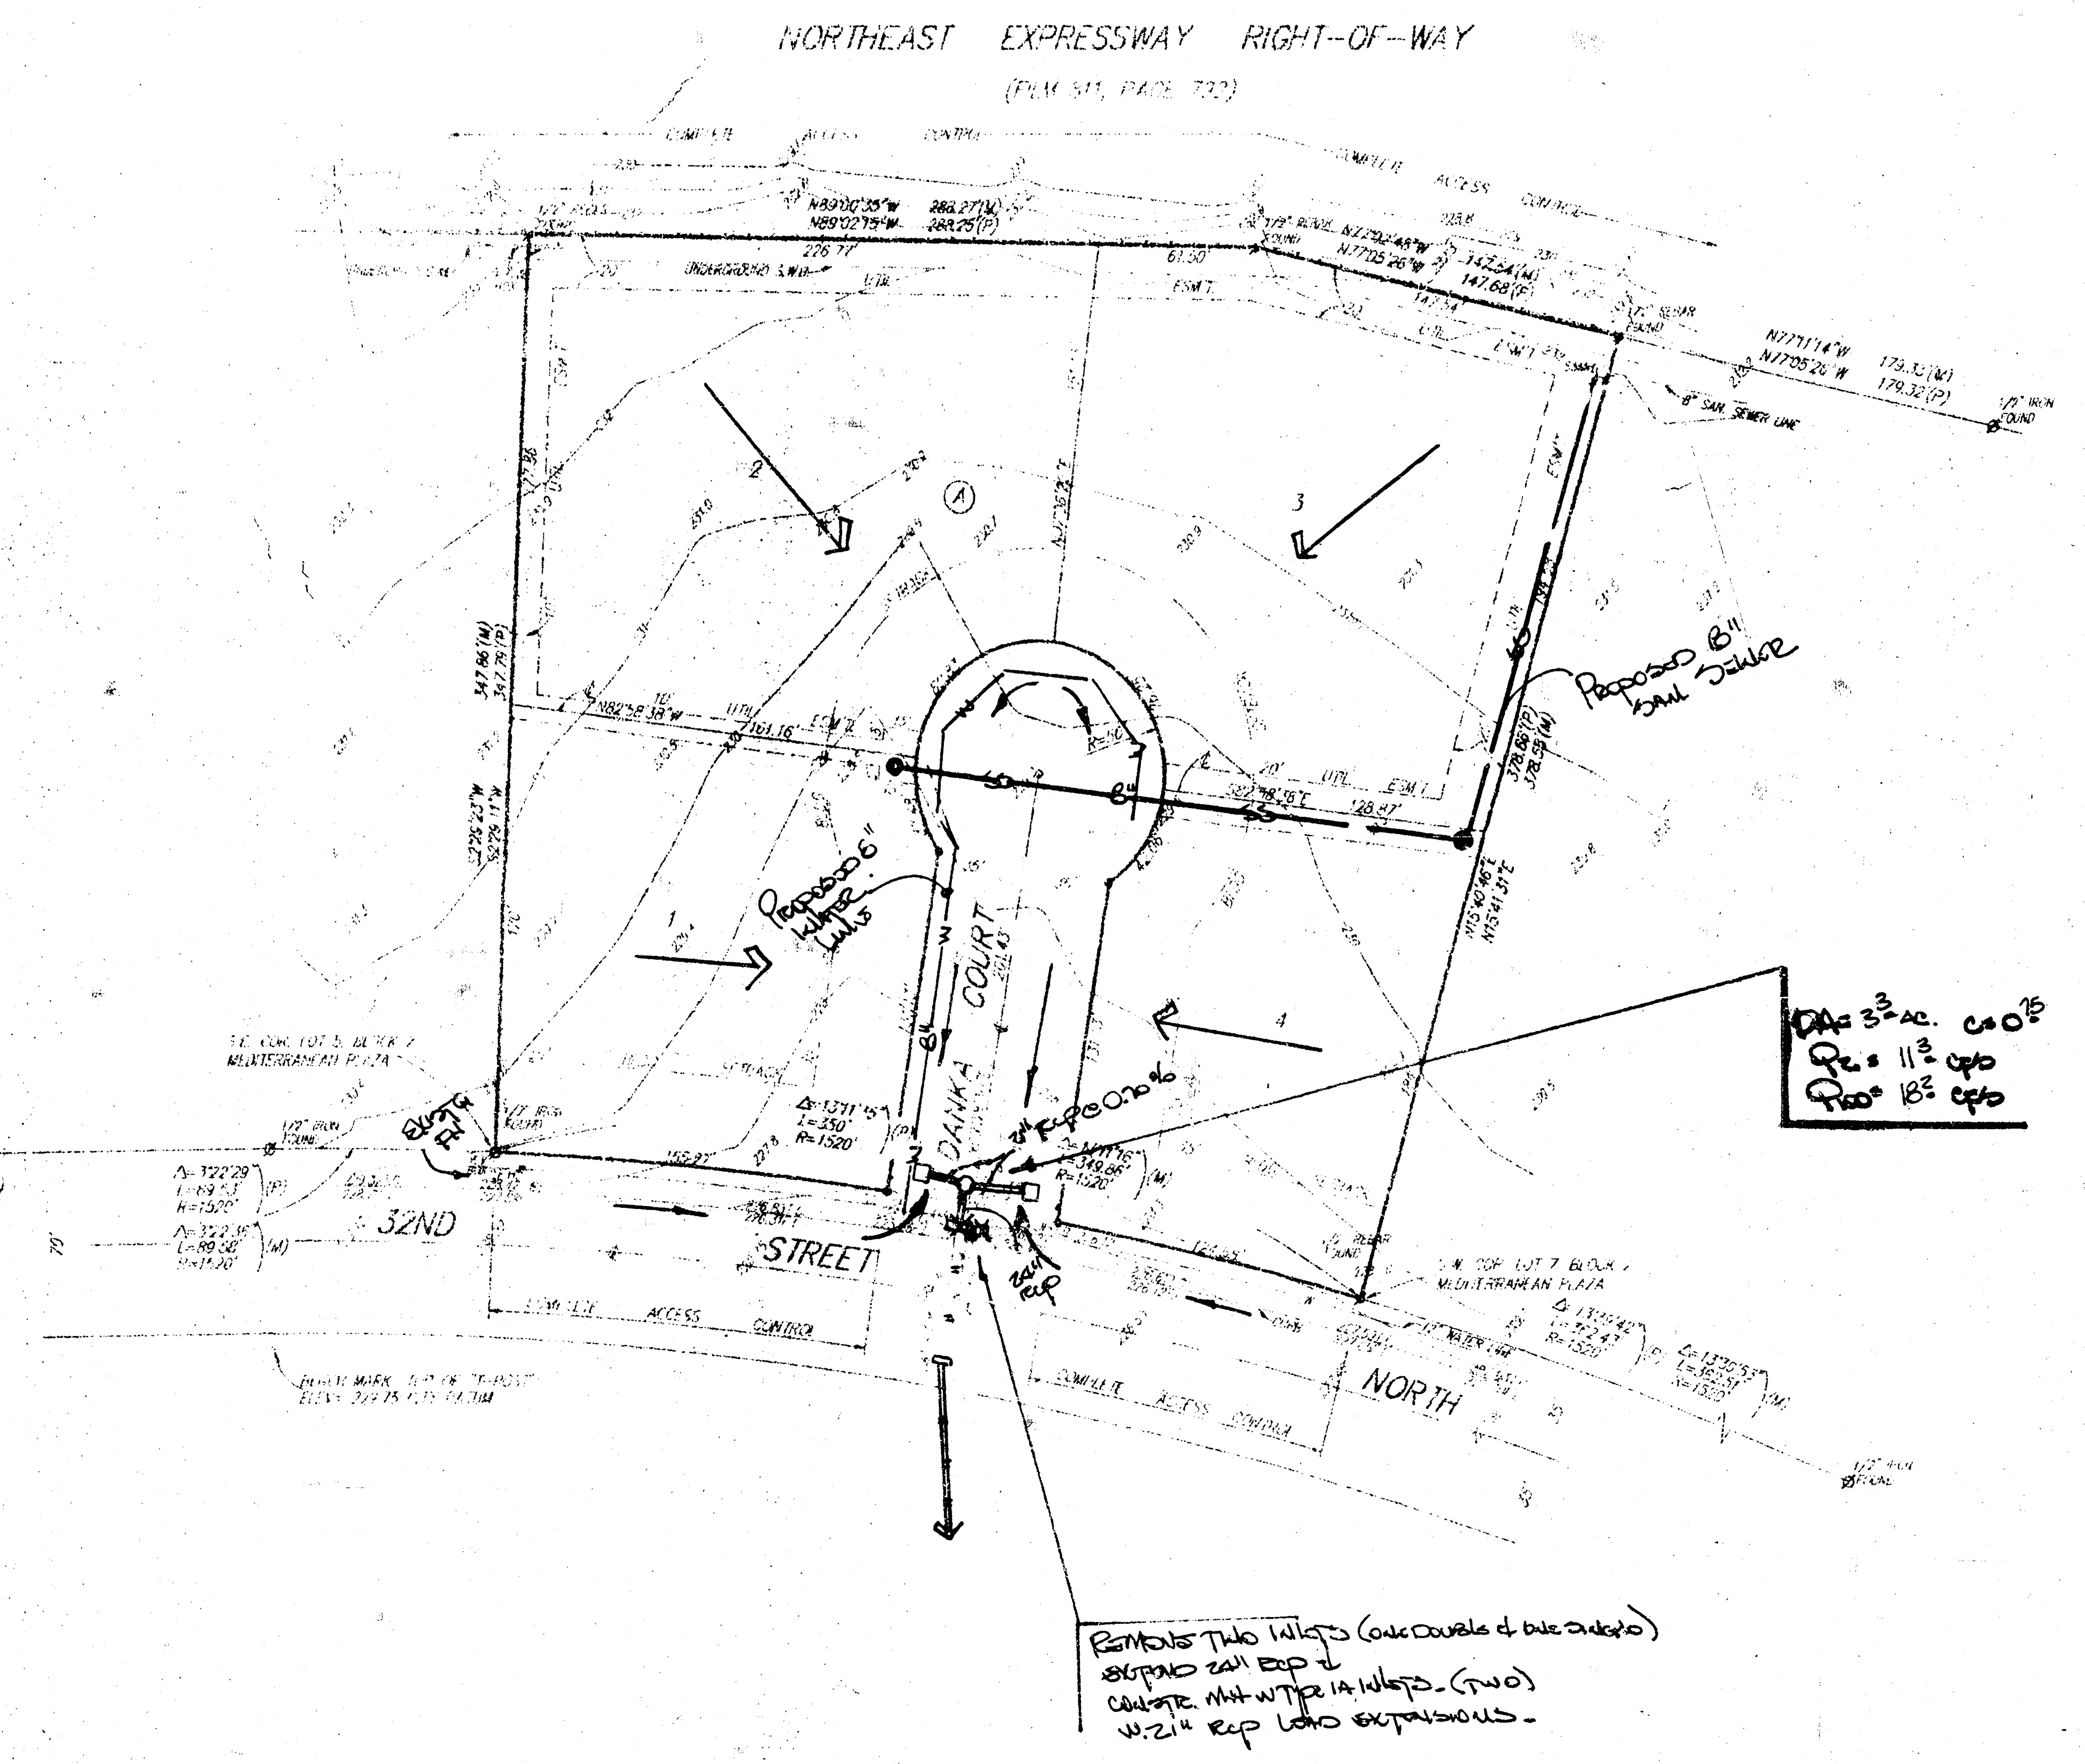

1" = 50'

FOUND CORNERS ARE OF UNIDENTIFIED ORIGIN UNLESS IDENTIFIED ON SKETCH

(P) = PLATTED
(M) = MEASURED
BEARING BASE = ASSUMED


• = 1/2" REBAR W/ "BAUGHMAN" CAP (SET)
ø = 1/2" IRON (FOUND)
ø = 1/2" REBAR (FOUND)

OWNER:
M. E. BARGER & ASSOCIATES, INC.
5565 NINTH STREET NORTH
P. O. BOX 2244
ST. PETERSBURG, FL 33731-2244
PH: 813-821-5421

LEGAL DESCRIPTION:
A REPLAT OF LOT 6, BLOCK 2, MEDITERRANEAN PLAZA, AN ADDITION TO WICHITA, SEDGWICK COUNTY, KANSAS

BENCHMARK:
"[]" CUT, TOP OF NORTH CURB ON 32nd STREET NORTH, BETWEEN LOTS 4 & 5, BLOCK 2, MEDITERRANEAN PLAZA
ELEV. = 229.42 CITY DATUM

TOP OF "T" POST, 88.1' W. & 74.1' S. OF THE S.W. COR. LOT 6, BLOCK 2, MEDITERRANEAN PLAZA
ELEV. = 229.75 CITY DATUM

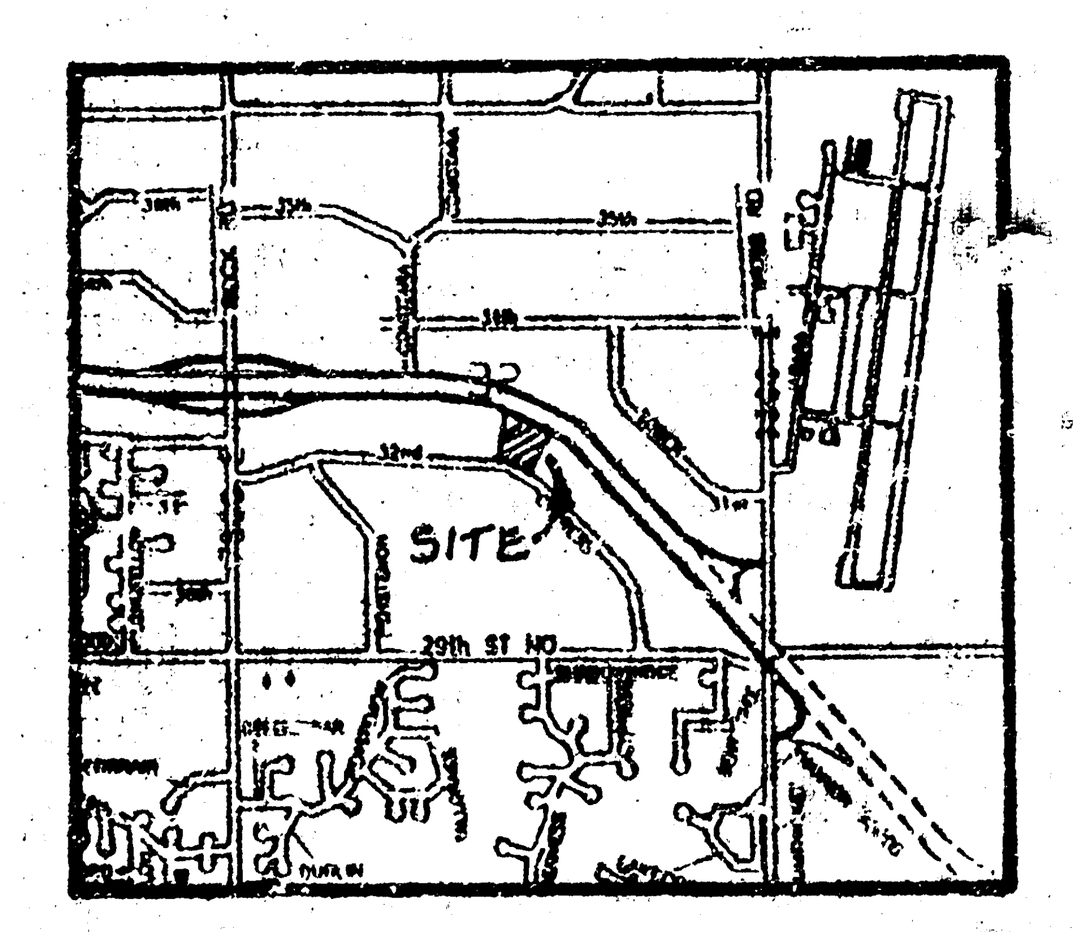

VICINITY MAP

DRAINAGE PLAN
UTILITY PLAN

BAUGHMAN COMPANY P. A.
SURVEYING & ENGINEERING
316/262-7271 • 315 ELLIS • WICHITA, KANSAS 67211

25 OCT 1993