


drainage plan

11-14-83

KANSAS TURNPIKE AUTHORITY
CASE A-55770

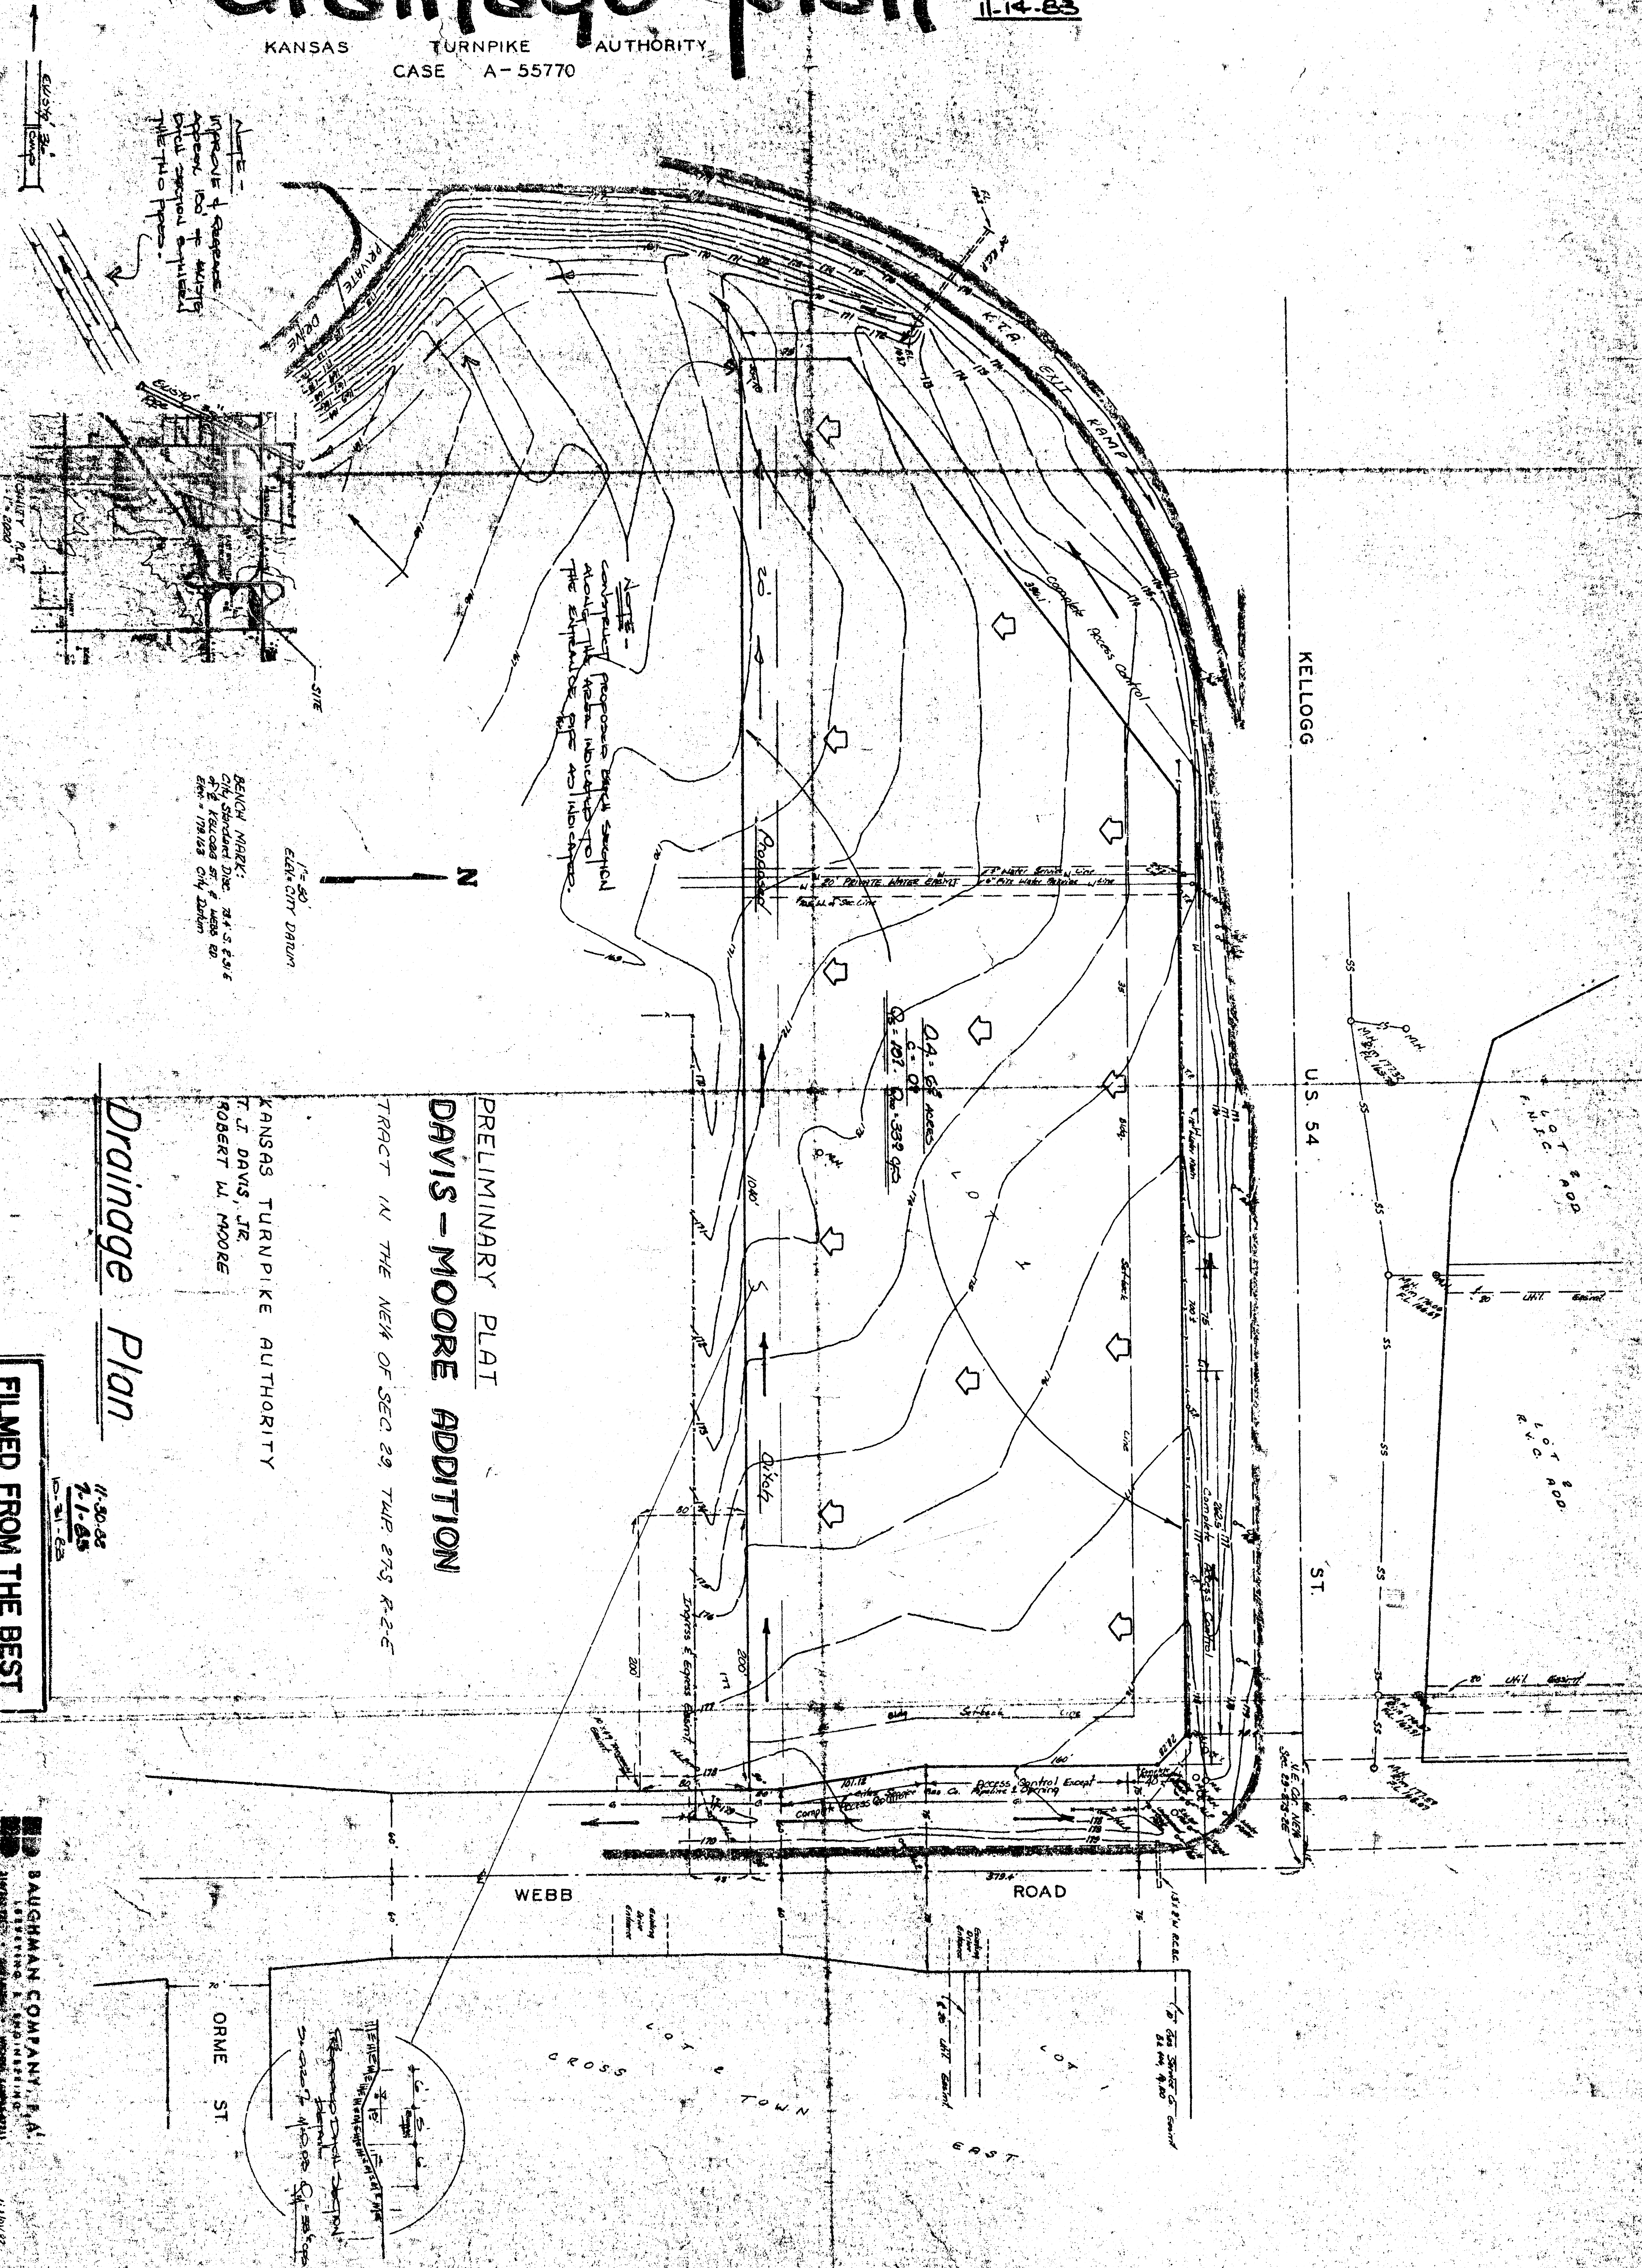

PRELIMINARY PLAT DAVIS - MOORE ADDITION

TRACT IN THE NE1/4 OF SEC. 29 T4R R-2-E

KANSAS TURNPIKE AUTHORITY
T. J. DAVIS, JR.
ROBERT W. MOORE

Drainage Plan

11-30-82
7-1-83

FILMED FROM THE BEST
AVAILABLE COPY

BAUGHMAN COMPANY, P.A.
SURVEYING & ENGINEERING

DAVIS-MOORE ADDITION
(DRAINAGE)