DAVIS MOORE 4TH ADDITION
(Drainage)

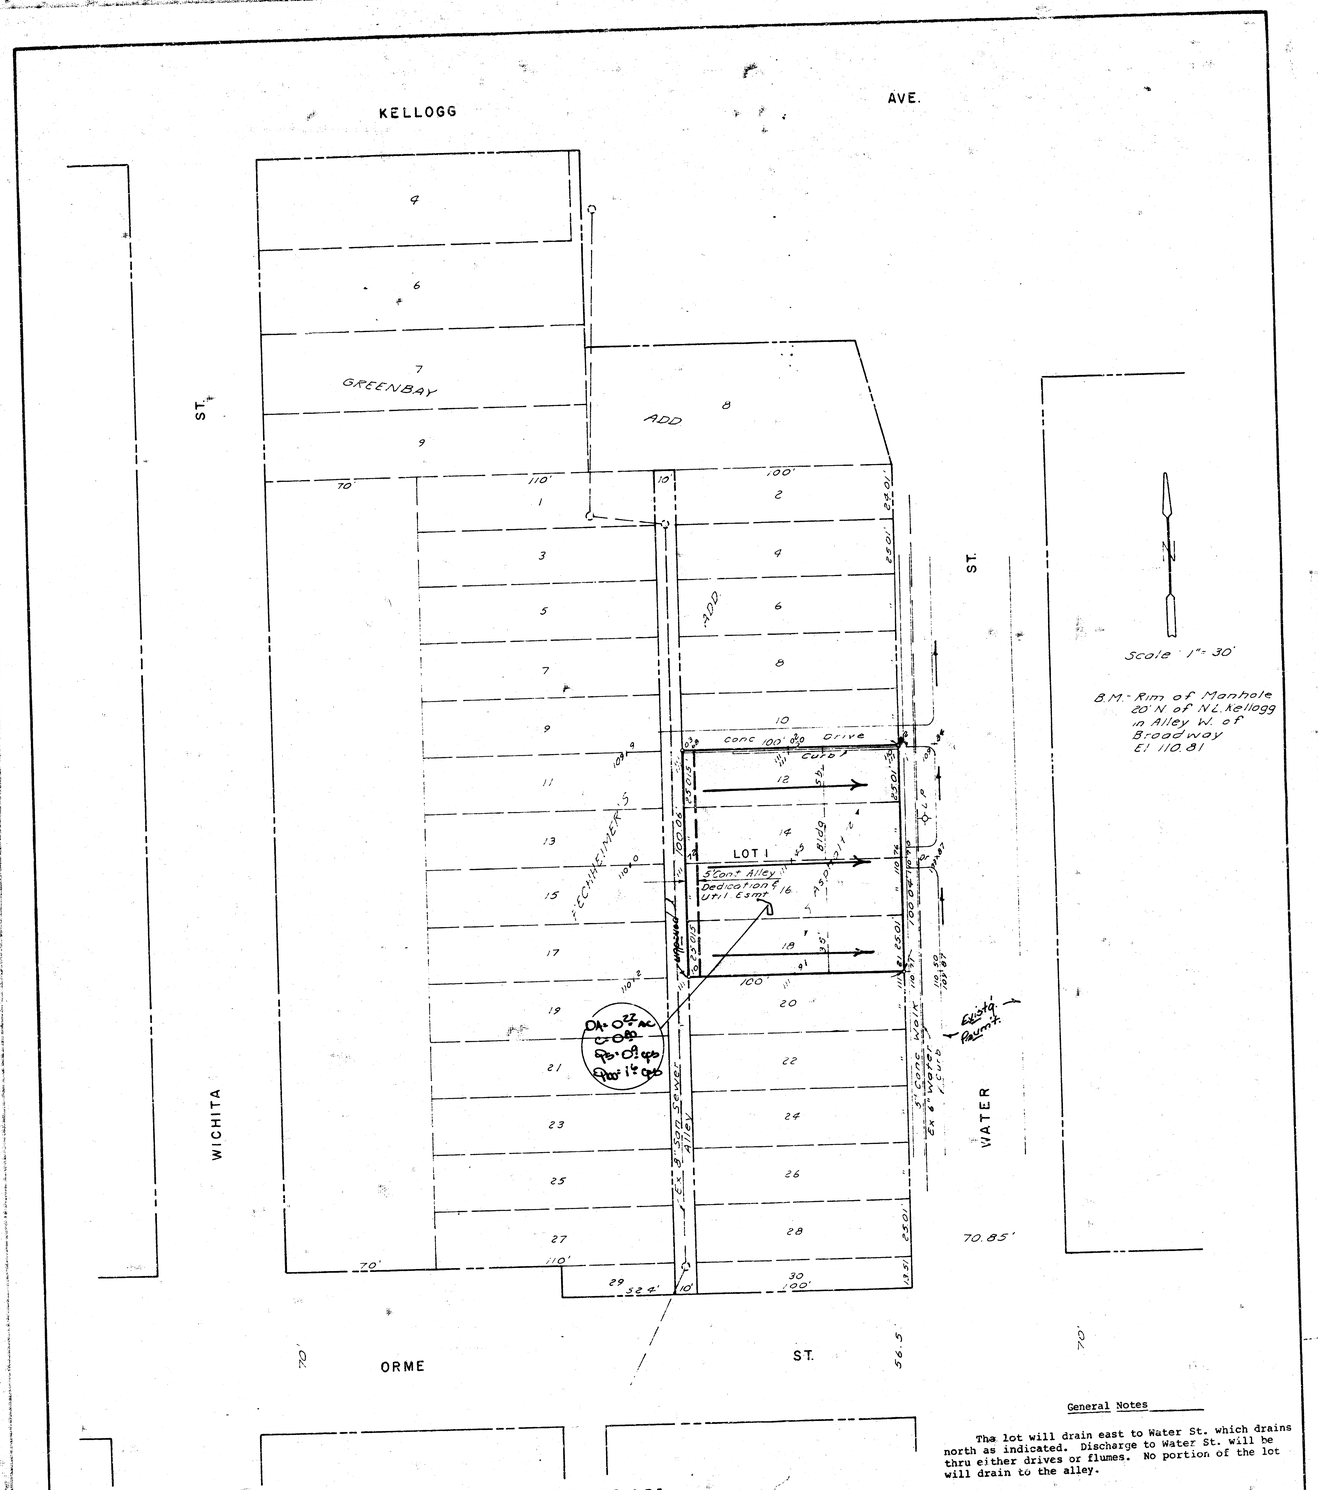

General Notes

The lot will drain east to Water St. which drains north as indicated. Discharge to Water St. will be thru either drives or flumes. No portion of the lot will drain to the alley.

Nov 21, 1985

BAUGHMAN COMPANY, P.A.
SURVEYING & ENGINEERING
316/262-7271 • 330 LAURA • WICHITA, KANSAS 67211

DRAINAGE PLAN

DAVIS MOORE 4TH ADDITION

A REPLAT OF LOTS 12, 14, 16 & 18 & E. 1/2 VACATED ALLEY, FECHHEIMER'S ADD.

FILMED FROM THE BEST AVAILABLE COPY