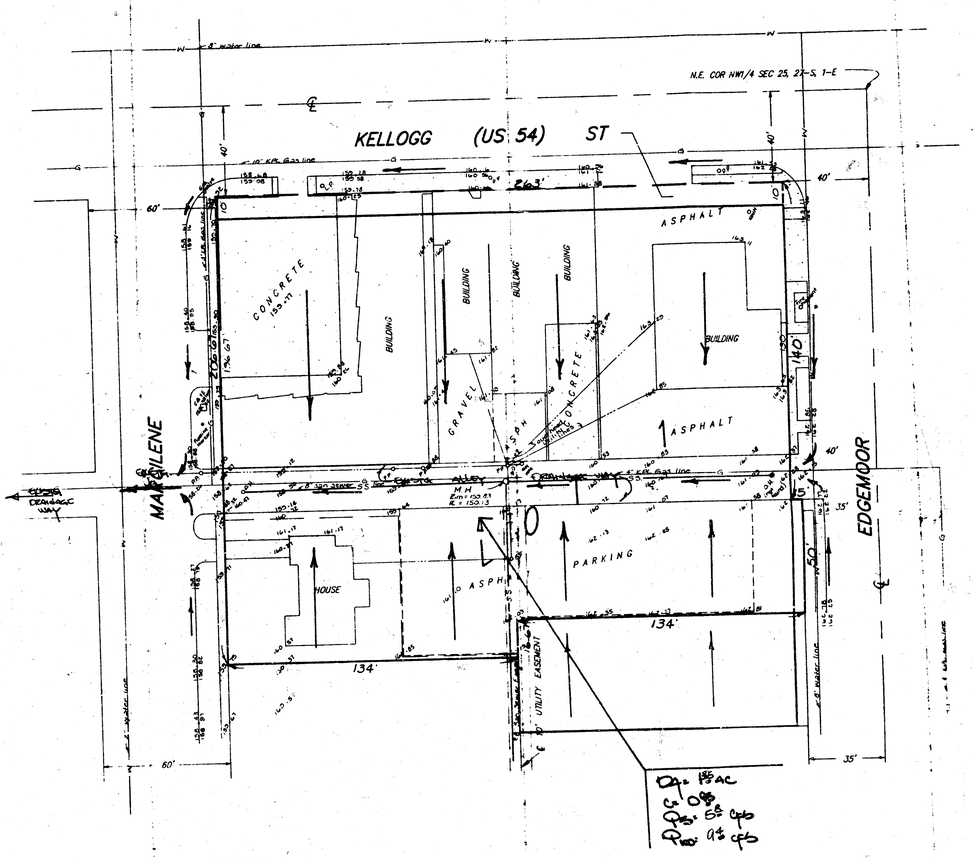


1" = 30'
ELEV = CITY DATUM

BENCH MARK:
SQUARE CUT TO OF CURB AT S. END OF S. CURB RETURN OF ALLEY ON THE E. SIDE OF BEVERLEY DR. AND S. OF KELLOGG ST. AT THE N.W. COR OF LOT 12, BLK 2, BEVERLEY MANOR
ELEVATION = 1341.47 M.S.L. (154.07 CITY DATUM)

SKETCH PLAT

DAVIS-MOORE 8TH ADDITION

WICHITA, SEDGWICK COUNTY, KANSAS.

Lot 1, 2, 3, 4, 5, 6, 7, 8, 9, 10, 11, and the north 16.67 feet of Lot 12 and Lot 28, Block 1, Beverley Manor, Sedgwick County, Kansas.

T. G. DAVIS, JR.

Note 2 - THE EXISTING COMMERCIAL LOT WILL BE CONVERTED TO PARKING LOT. DRAINAGE WILL CONTINUE AS IT PRESENTLY DOES.

APPROVED
DRAINAGE PLAN

DRAINAGE PLAN

BAUGHMAN COMPANY P. A.
SURVEYING & ENGINEERING
316/262-1279 • 315 ELLIS • WICHITA, KANSAS 67211

25 FEB 91

FILMED FROM THE BEST AVAILABLE COPY