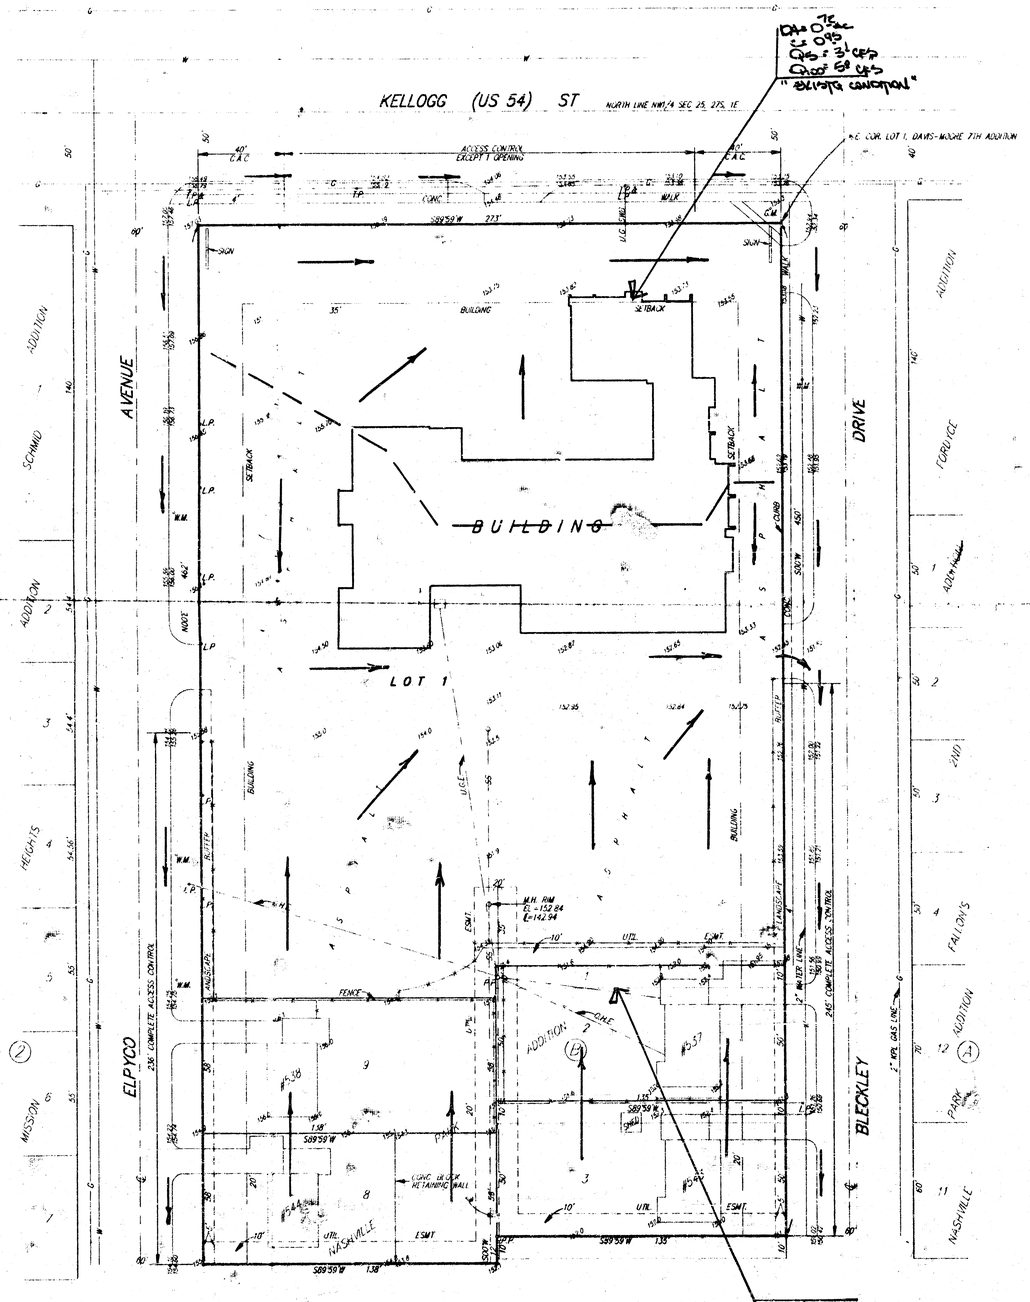

SKETCH PLAT
DAVIS-MOORE 11TH ADDITION

WICHITA, SEDGWICK COUNTY, KANSAS

LOT 1, DAVIS-MOORE 7TH ADDITION, WICHITA, SEDGWICK COUNTY, KANSAS; TOGETHER WITH THE SOUTH 10 FEET OF LOT 1 AND THE NORTH 50 FEET OF LOT 2, THE SOUTH 10 FEET OF LOT 2 AND THE NORTH 50 FEET OF LOT 3, LOT 8, AND LOT 9, ALL IN BLOCK B, NASHVILLE PARK ADDITION, WICHITA, SEDGWICK COUNTY, KANSAS.

T. G. DAVIS, JR.
P. O. BOX 780047
~~WICHITA, KANSAS 67278~~
PH: 685-0211

S.A. = 30'
• = 1/2" REBAR W/ "BAUGHMAN" CAP (SET)
DRAWING BY & = ASSUMED
C.A. = COMPLETE ACCESS CONTROL
B.M. = X SPIKE IN NORTH FACE OF P.P. 2' NORTH OF SOUTH LINE OF KELLOGG & 4' WEST OF EAST LINE OF PIN. ELEV. = 154.33 CITY DATUM

"DRAINAGE PLAN"

BAUGHMAN COMPANY P. A.
SURVEYING & ENGINEERING
316/262-7271 • 315 ELLIS • WICHITA, KANSAS 67211

20 FEB 1993