


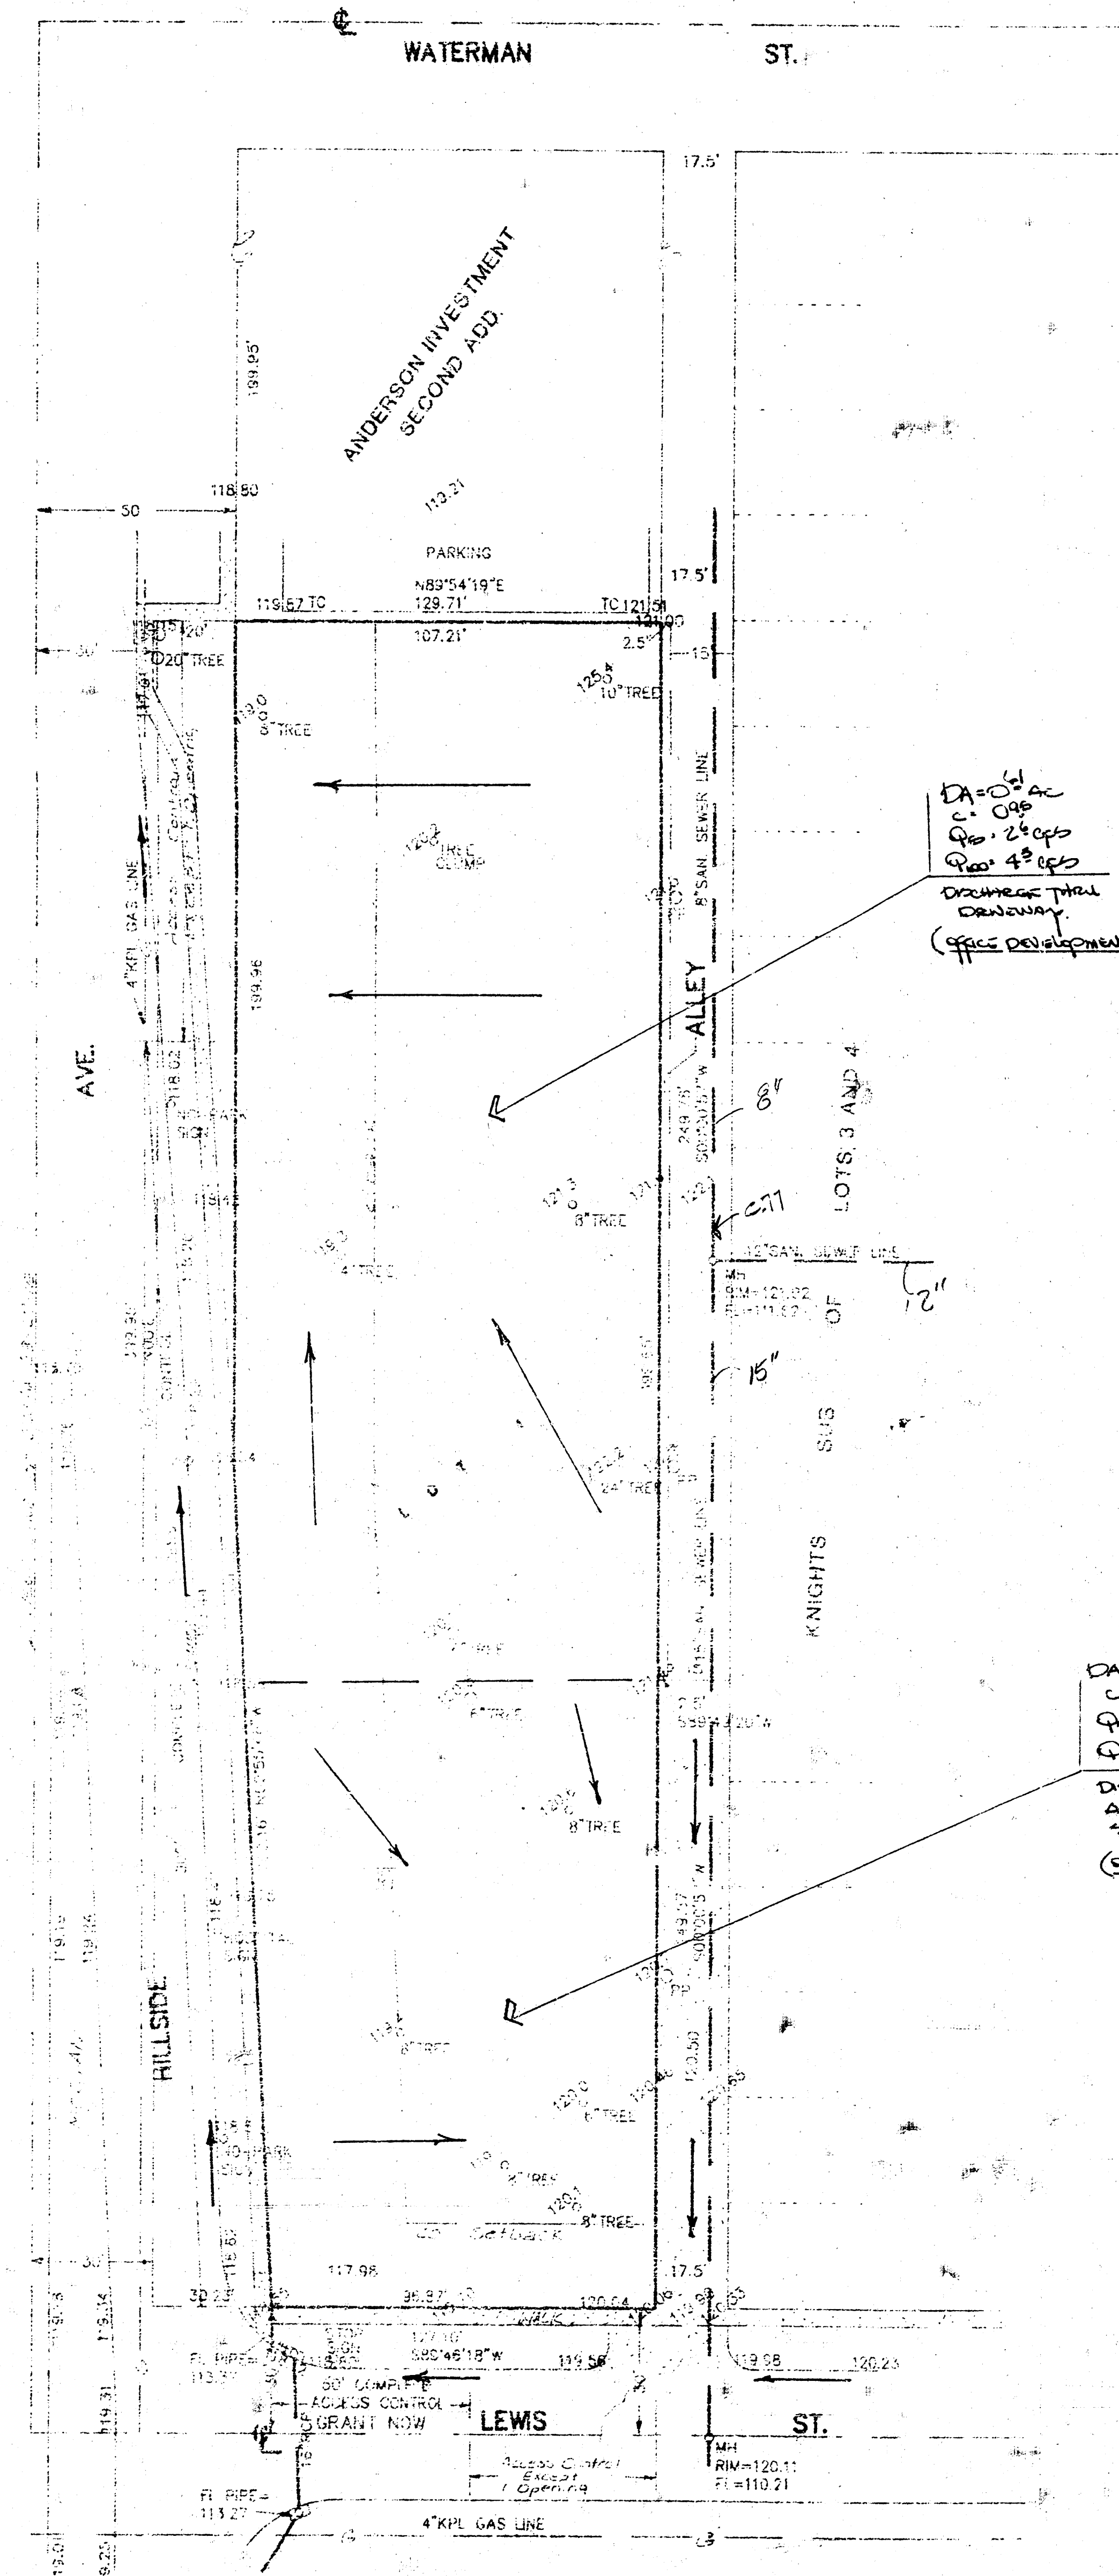

SKETCH PLAT **DEPARTMENT OF** **TRANSPORTATION** **3RD ADDITION**

REPLAT OF LOTS 17, 19, 21, AND 23, KNIGHTS SUB-DIVISION, OF LOTS 3 AND 4, IN BLOCK 1, GRAND VIEW ADDITION TO WICHITA, KANSAS, TOGETHER WITH LOTS 1, 3, 5, 7, 9, AND 11, RAWLINS AND BROWN'S SUB-DIVISION OF LOTS 5 AND 8, IN BLOCK 1, GRAND VIEW ADDITION TO WICHITA, KANSAS, TOGETHER WITH LOT 1, HERMAN ADDITION, WICHITA, KANSAS.

DEPARTMENT OF TRANSPORTATION
AND CITY OF WICHITA

(OFFICE DEVELOPMENT)

Prove existing storm sewer can take all water & tell what existing runoff to to SS is.
And prove won't flood street
Paved Alley? Brent