
DHON ADDITION
(Drainage)

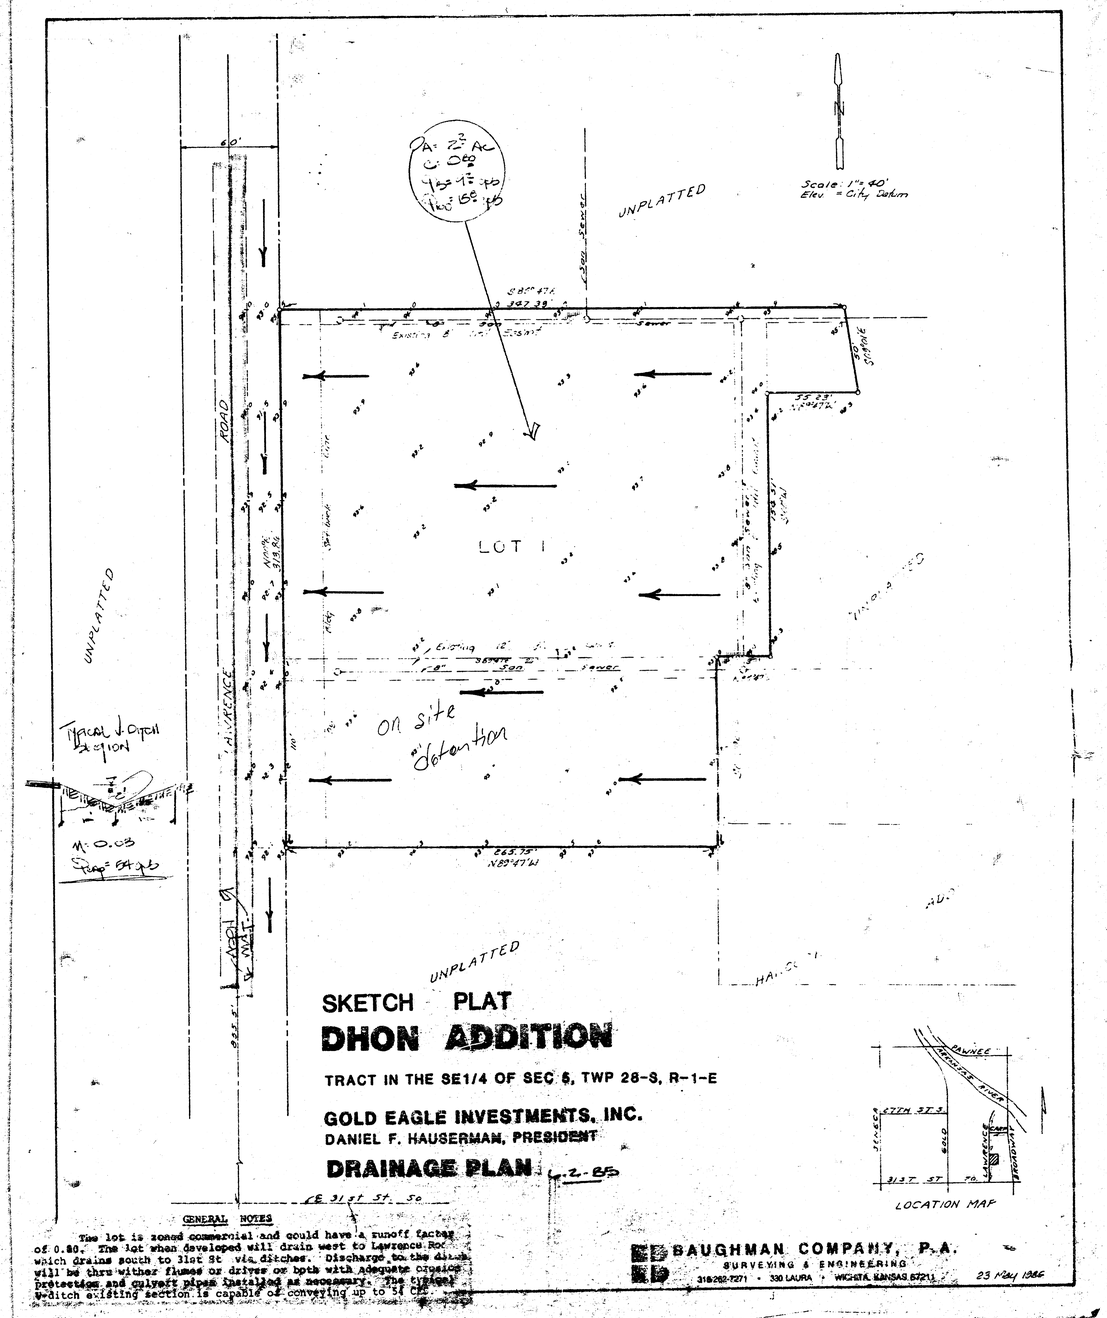

SKETCH PLAT

DHON ADDITION

TRACT IN THE SE1/4 OF SEC 6, TWP 28-S, R-1-E

GOLD EAGLE INVESTMENTS, INC.
DANIEL F. HAUSERMAN, PRESIDENT

DRAINAGE PLAN

4-2-85

GENERAL NOTES

The lot is zoned commercial and could have a runoff factor of 0.80. The lot when developed will drain west to Lawrence Rd. which drains south to 31st St via ditches. Discharge to the ditch will be thru wither flumes or drives or both with adequate erosion protection and culvert pipes installed as necessary. The typical v-ditch existing section is capable of conveying up to 5 CFS

BAUGHMAN COMPANY, P.A.
SURVEYING & ENGINEERING
316/262-7271 • 330 LAURA • WICHITA, KANSAS 67211

23 May 1985