


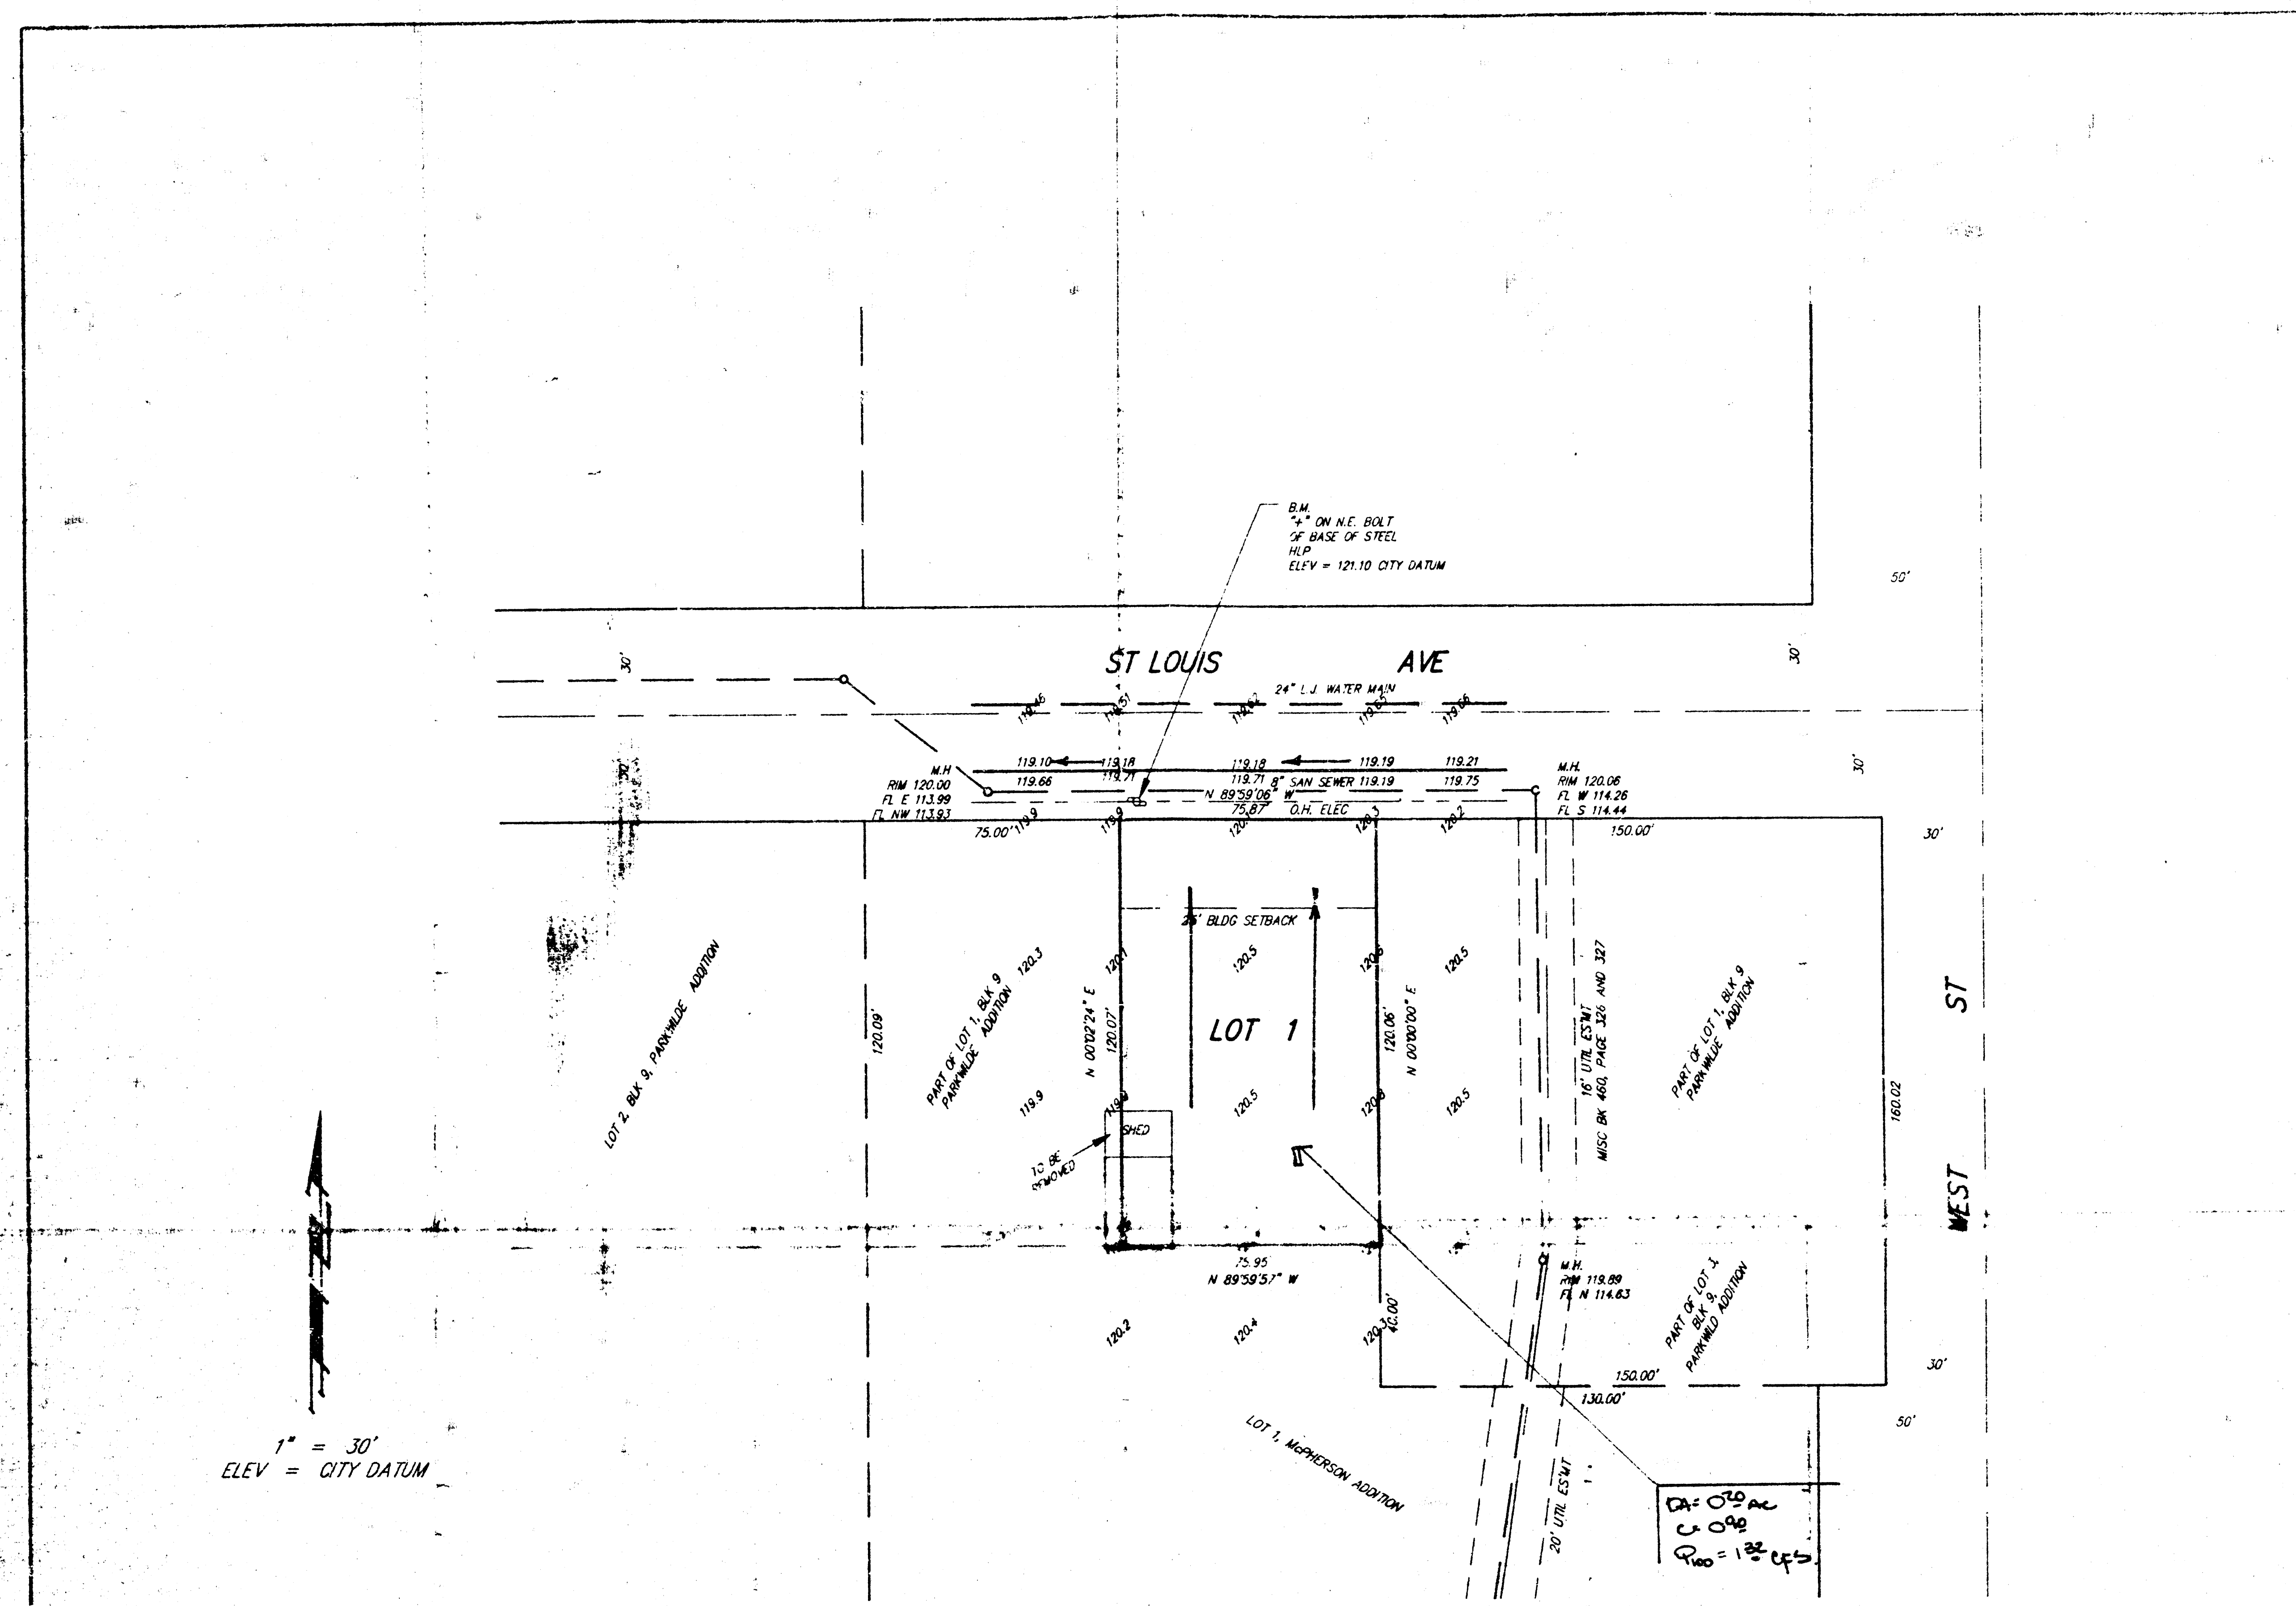

SKETCH PLAT E.C.I. 2ND ADDITION

LOT 1, EXCEPT THE EAST 150 FEET THEREOF
AND EXCEPT THE WEST 75 FEET THEREOF,
BLOCK 9, PARKWILDE ADDITION TO WICHITA,
KANSAS.

ELECTRICAL CONTRACTORS, INC.
KENN SEILER, PRESIDENT
2420 WHEATRIDGE DR.
WICHITA, KS 67233

PH 722-0204

**DRAINAGE
PLAN**



BAUGHMAN COMPANY P. A.
SURVEYING & ENGINEERING

316/262-7271 • 315 ELLIS • WICHITA, KANSAS 67211

22 NOV 91