
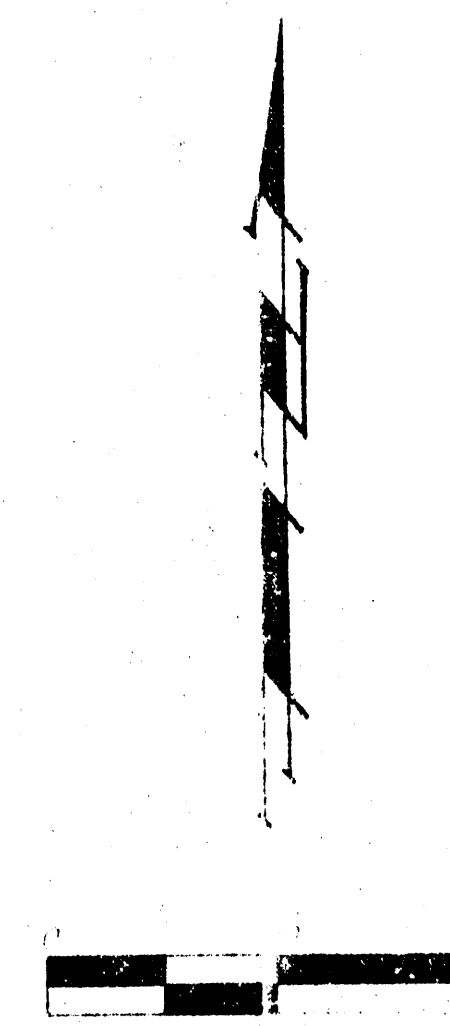


DRAINAGE PLAN
ECK 4TH ADDITION
WICHITA, SEDGWICK COUNTY, KANSAS

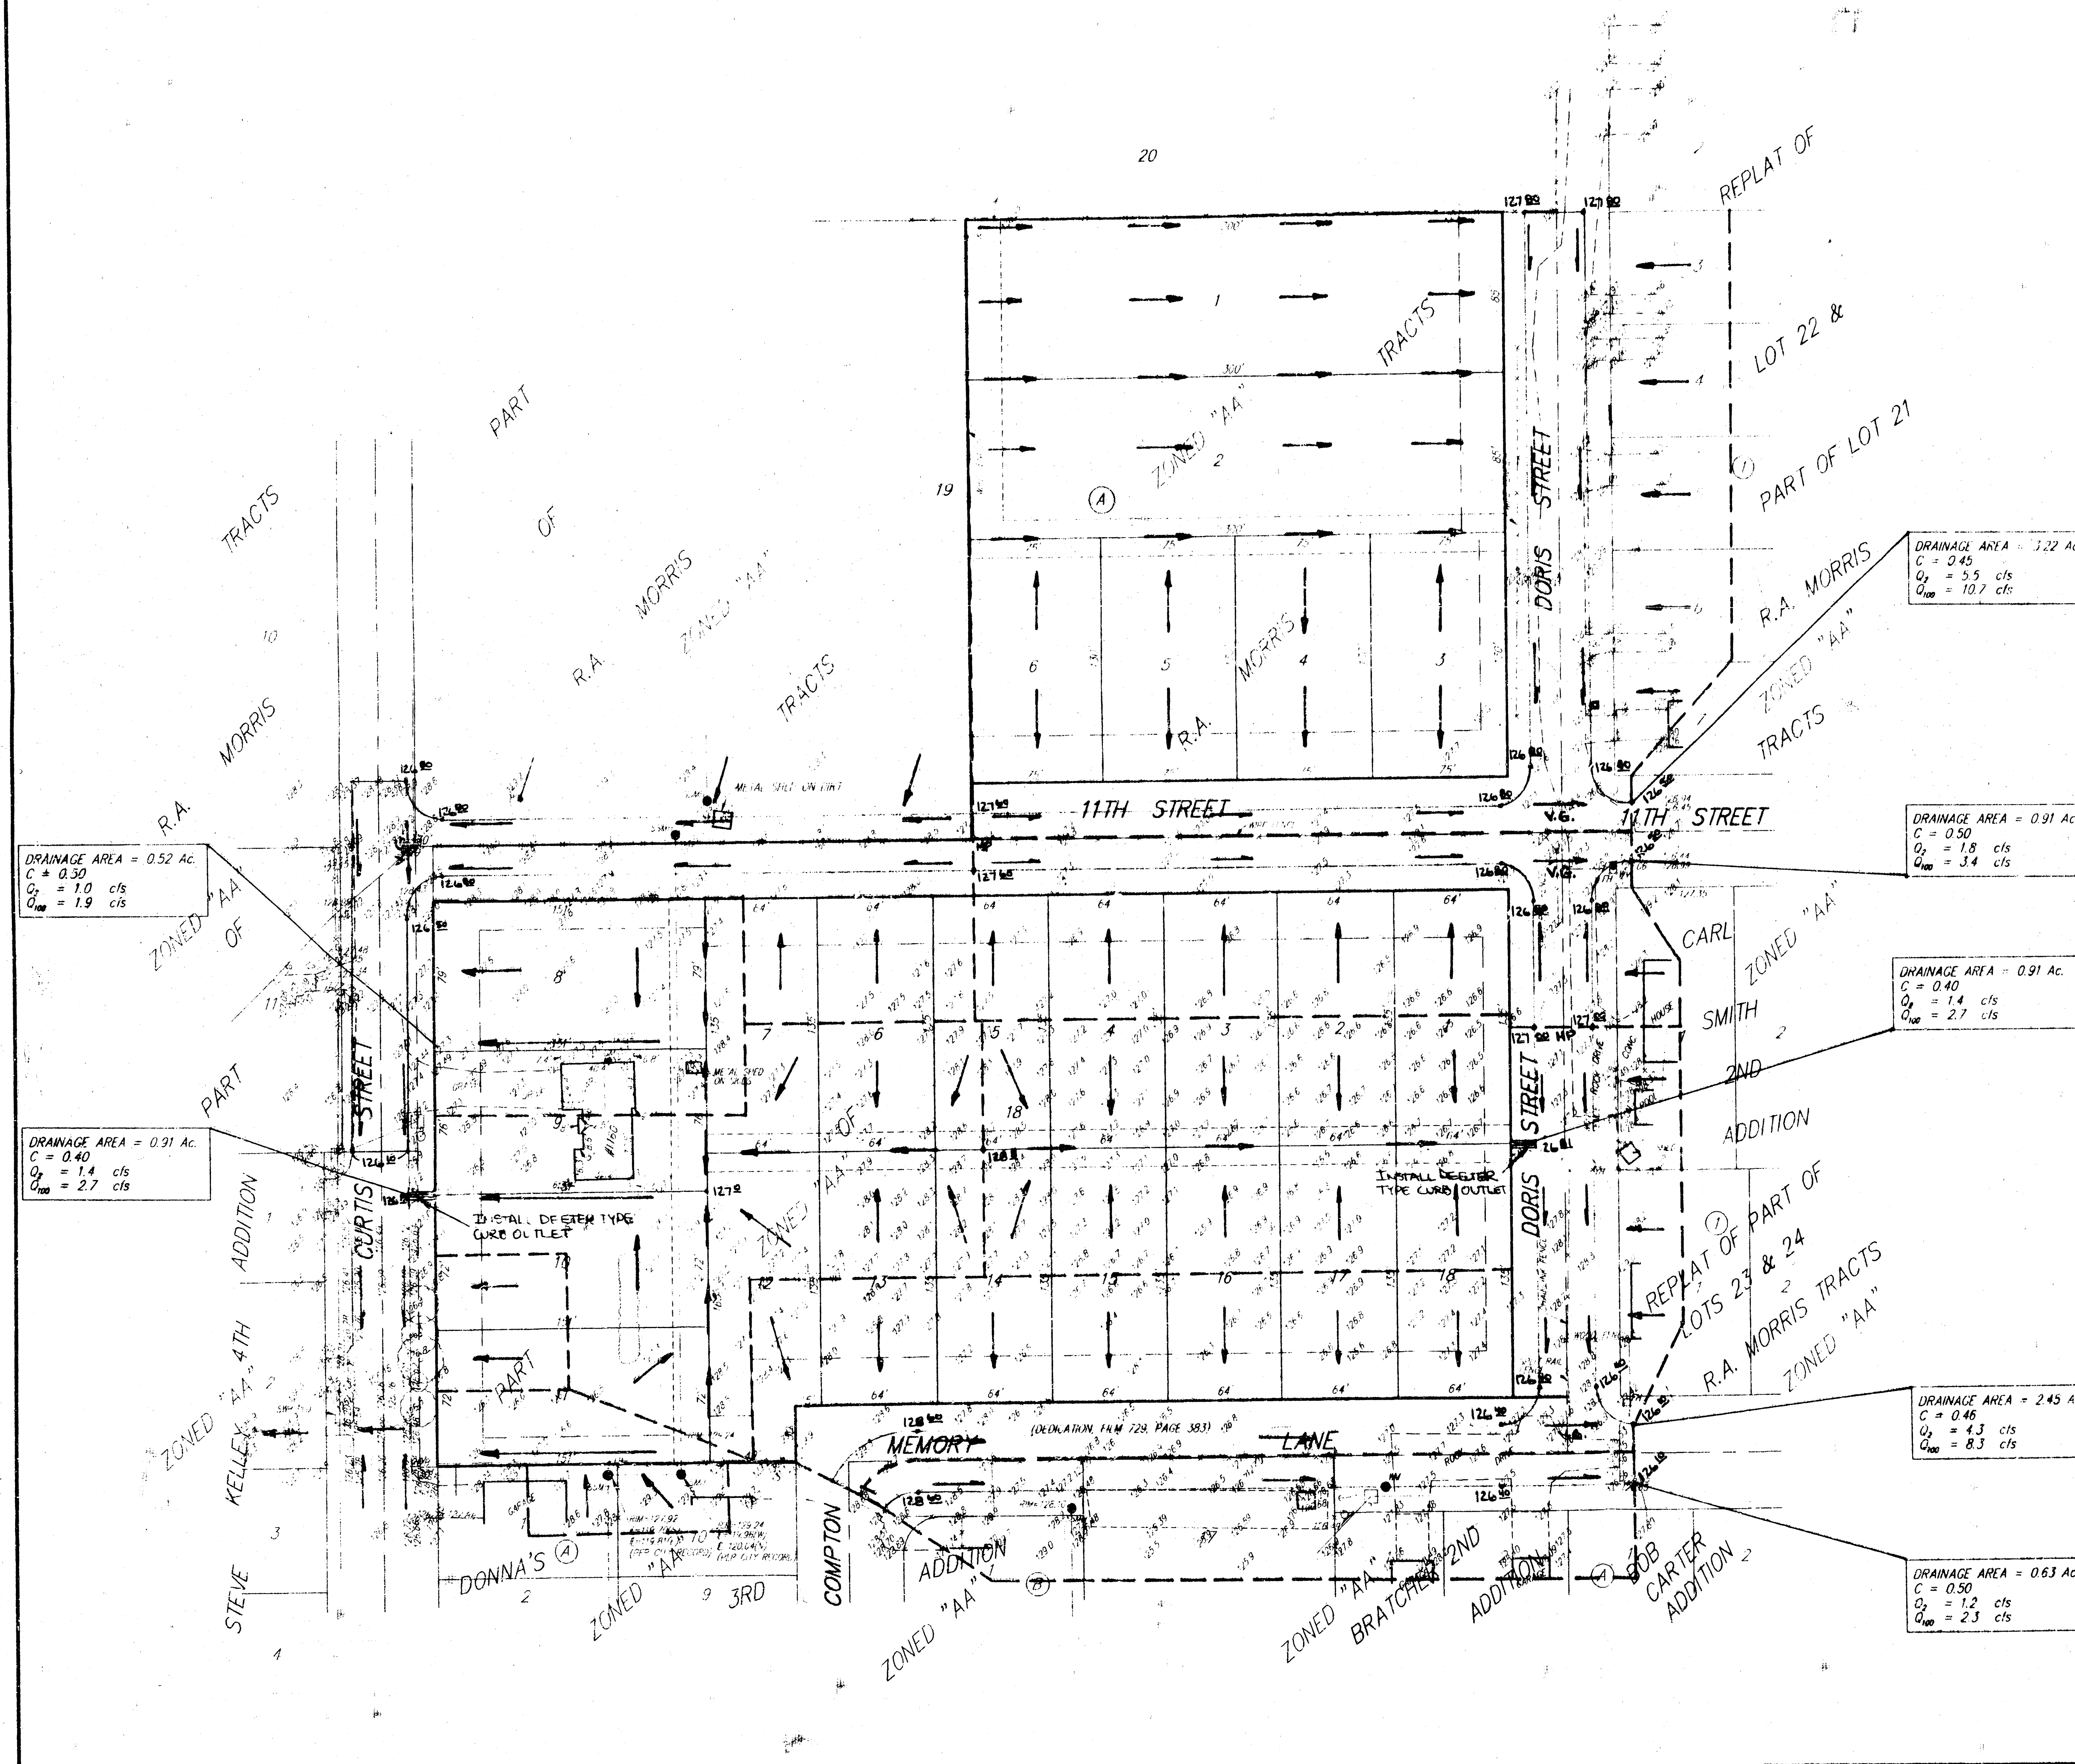


LEGAL DESCRIPTION:
A REPLAT OF ALL OF LOT 15 AND THE 1/2 OF LOT 12,
R.A. MORRIS TRACTS, SEDGWICK COUNTY, KANSAS.

OWNER:
MATT ECK
5512 W. CENTRAL
WICHITA, KS 67212
PH. 316-942-7402

BENCHMARK:
CURTIS AND 13TH STREET
CITY OF WICHITA BENCHMARK 050, C OF CURTIS EXTENDED,
2' SOUTH OF SOUTH PROPERTY LINE 1-235 R/W
21' WEST OF POLE LINE SOUTH EXTENDED
74' NORTH NORTHWEST OF STREET LIGHT POLE
68' WEST OF CHAINLINK FENCE CORNER
ELEV. = 129.152 (CITY DATUM)

NOTE: ALL SPOT ELEVATION ON PROPOSED PAVING
AND BACKLOT DRAINAGEWAYS ARE FLOW
LINE ELEVATIONS.

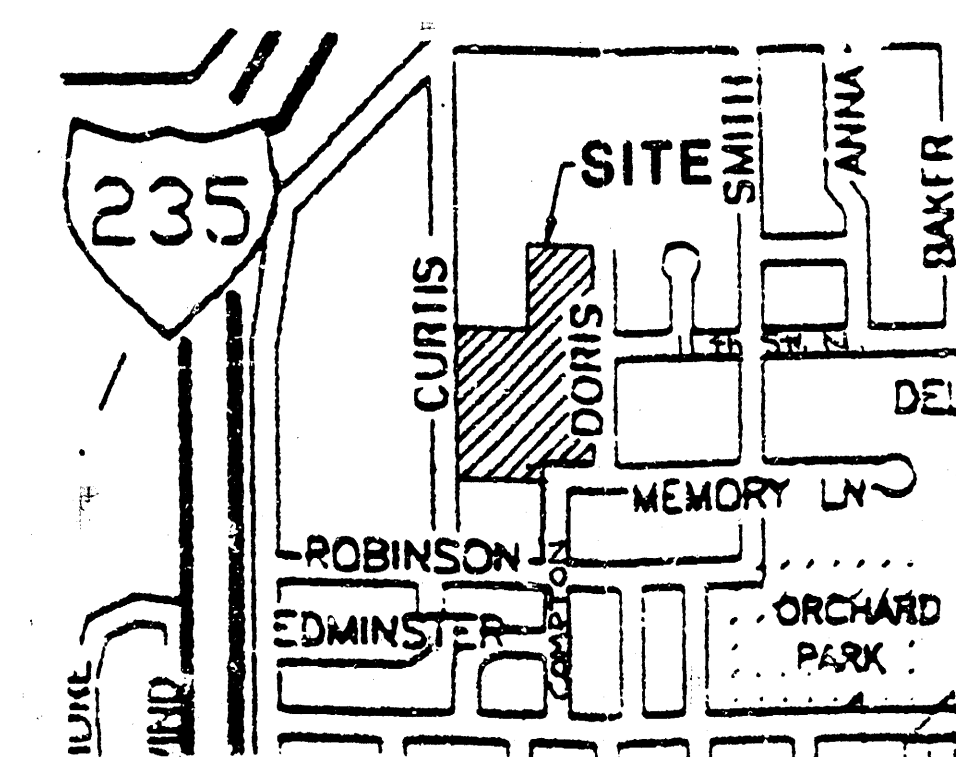

MAR. 4, 1996
JAN. 20, 1996

BAUGHMAN COMPANY P.A.
ENGINEERING, SURVEYING, & PLANNING
316 WEST 10TH STREET, SUITE 200, WICHITA, KS 67202

