

GARY EDMINSTER ADDITION
(DRAINAGE)

SKETCH PLAT
GARY EDMINSTER ADDITION

THE SOUTH 130 FEET OF THE NORTH
660 FEET OF THE EAST 330 FEET OF THE
NW 1/4 OF SEC. 15, TWP. 27-S, R-1-W OF THE
6TH P.M., SEDGWICK COUNTY, KANSAS.


GARY K. EDMINSTER

drainage plan

N

1" = 50'
Elev. = City Datum

BENCH MARK
City Standard Disc. 49 W. & 34 S.
of E. Ridge Rd. & School St.
Elev. = 132.188 City Datum

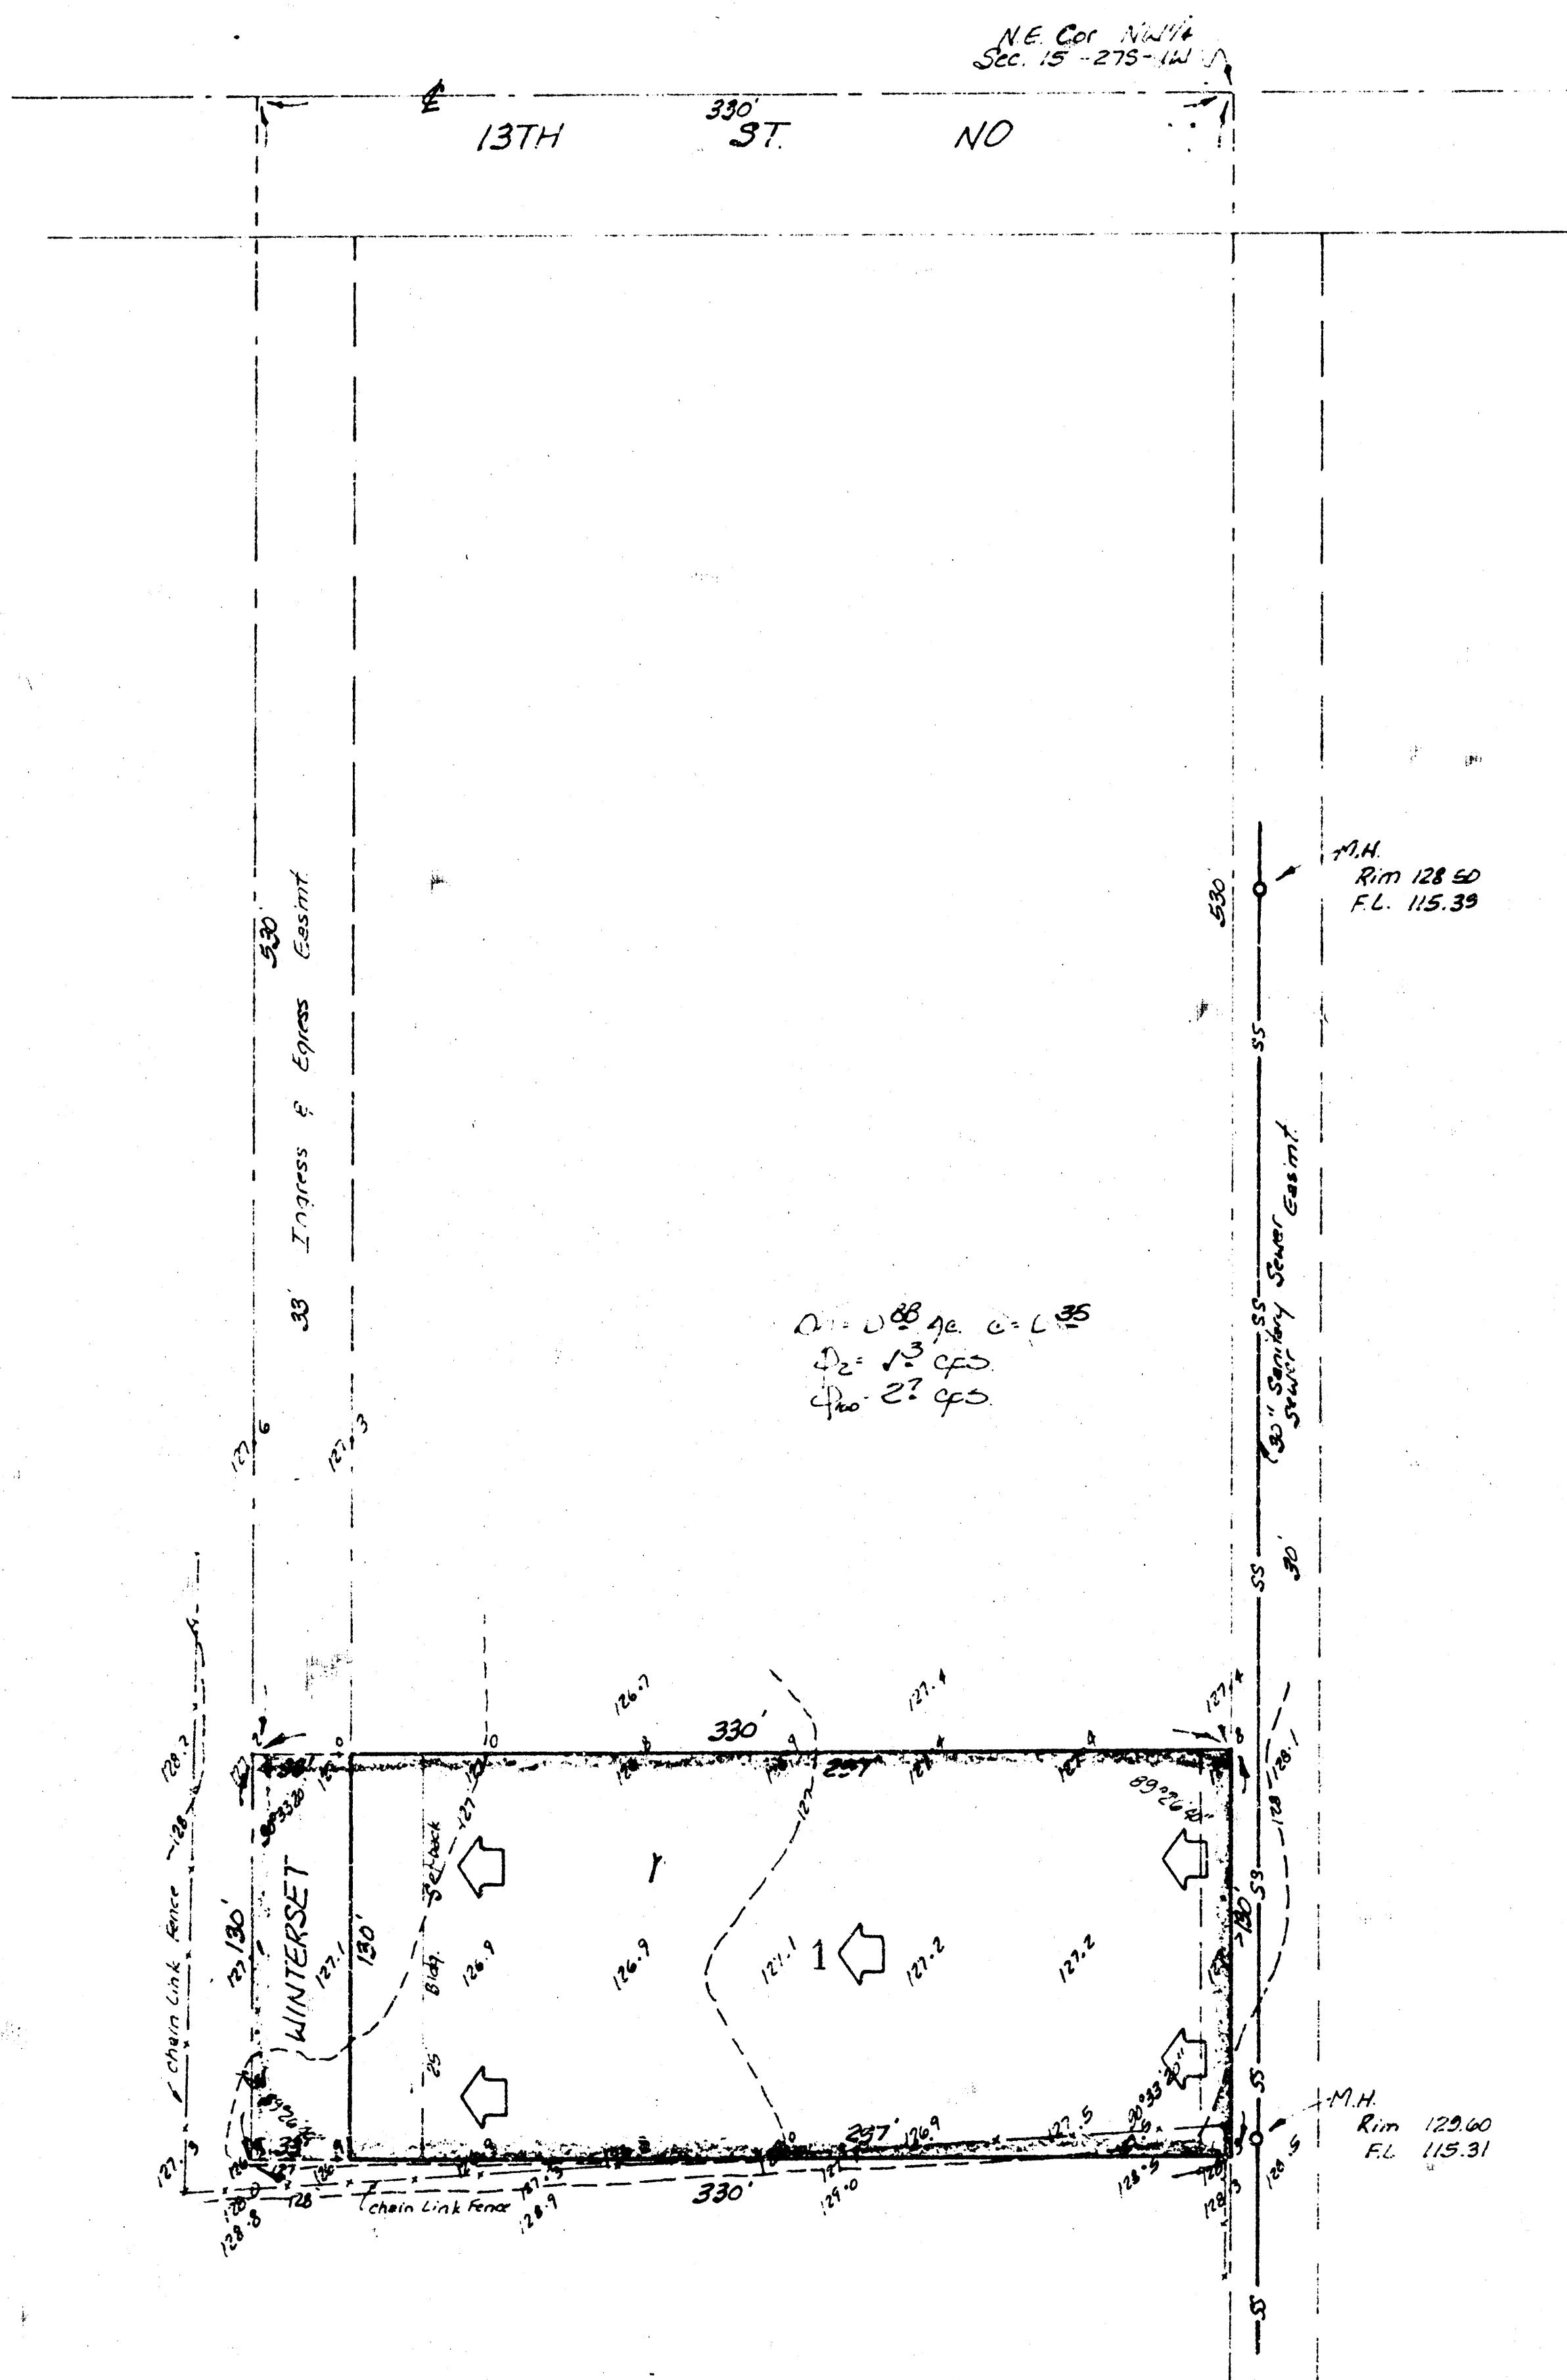

BAUGHMAN COMPANY, P.A.
SURVEYING & ENGINEERING
316/262-7271 • 330 LAURA • WICHITA, KANSAS 67211

BAUGHMAN COMPANY, P.A.
SURVEYING & ENGINEERING
316/262-7271 • 330 LAURA • WICHITA, KANSAS 67211

MEMO

PROJECT GARY EDMINSTER ADDITION

DATE 5-23-83

JOB NO.

COPIES TO:

TO Chris Breitenstein

FROM Brent Wooten

REFERENCE Drainage Plan

Final plat is scheduled for subdivision for 5-23-83.

Lot 1 (0.88 Ac.) will drain west to Winterset which is
unpaved and unopened at this time. The lot will be residential with
a runoff factor of 0.35.

Approved
5/25/83

RECEIVED
MAY 25 1983
Dept. Of Engineering

11-2 D
11-2 D

PAGE 1 OF 1