


REVISED
SKETCH PLAT

ELIZABETH'S ADDITION

BEING A REPLAT OF THE RESERVE, BLOCK 1, EXCEPT THE WEST
392 FEET THEREOF, SHADYBROOK ADDITION, WICHITA, SEDGWICK
COUNTY, KANSAS

OWNERS: JULIUS SMITH
LEE LUINSTRA

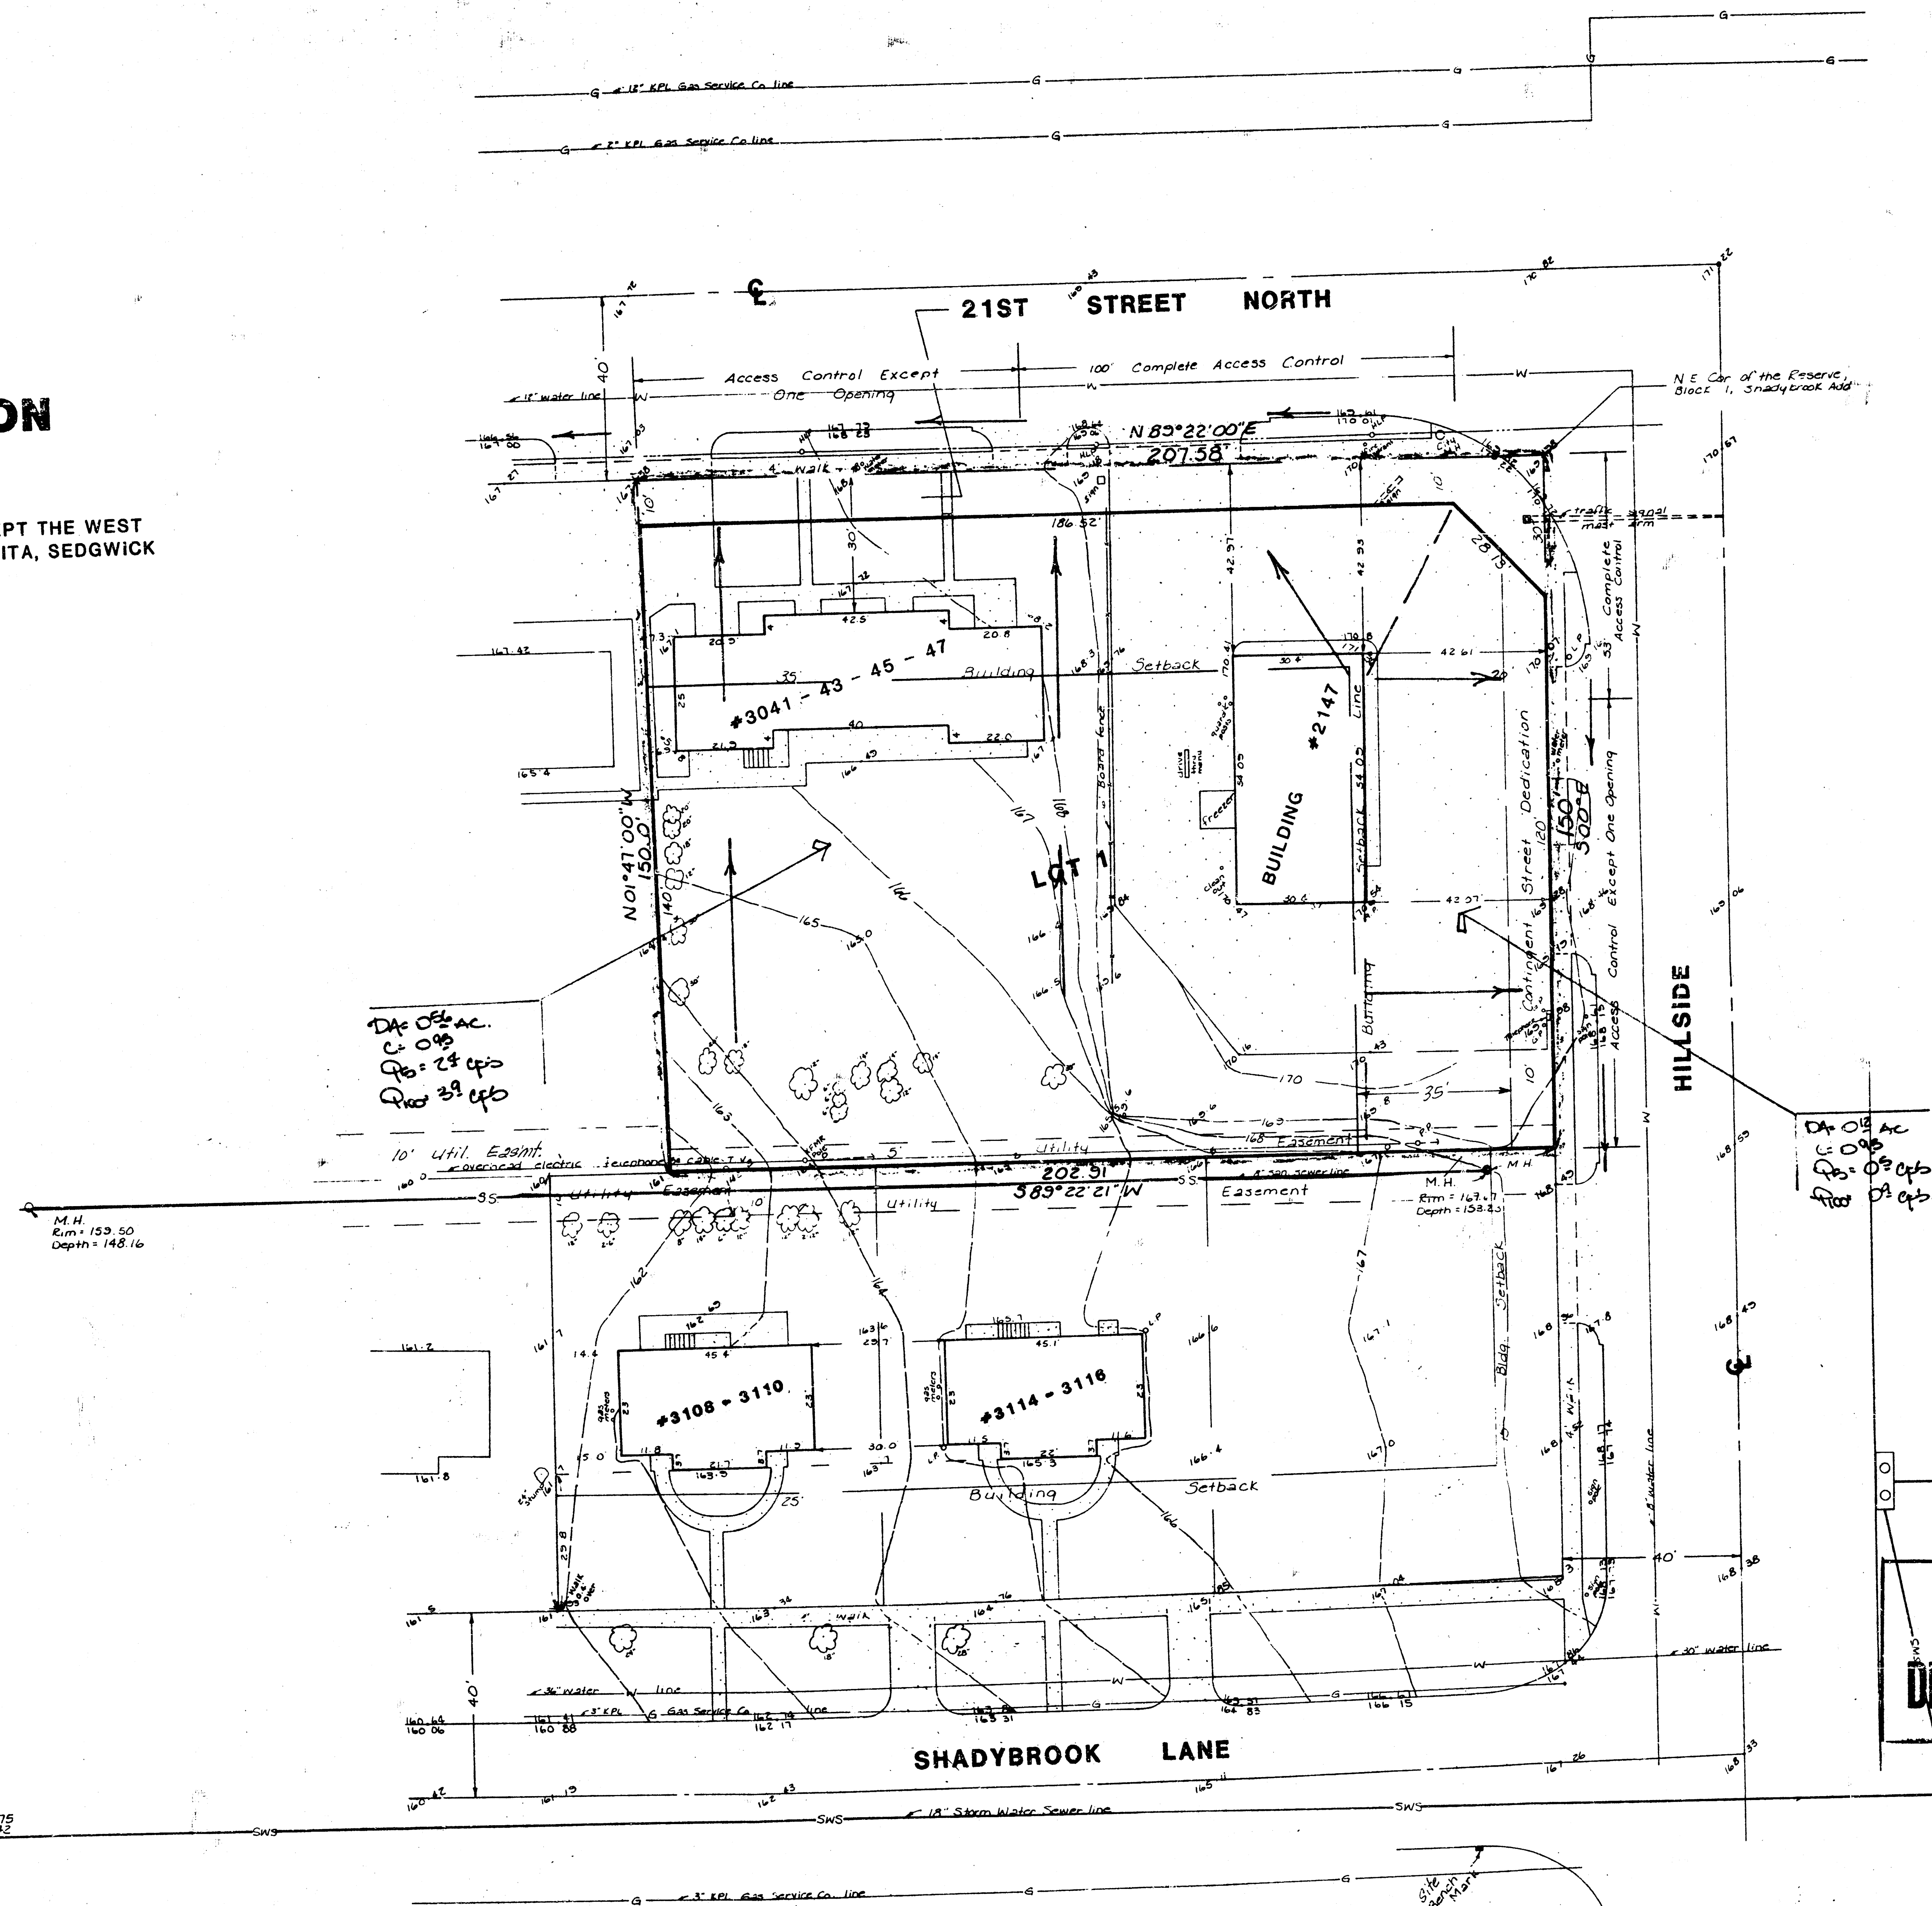

APPROVED
DRAINAGE PLAN

DRAINAGE PLAN

Revised MAR 3, 91
BAUGHMAN COMPANY, P.A.
SURVEYING & ENGINEERING
316/262-7271 • 315 ELLIS • WICHITA, KANSAS 67211 12-28-90

FILMED FROM THE BEST
AVAILABLE COPY.....