
FARROW SECOND ADDITION
(Drainage)

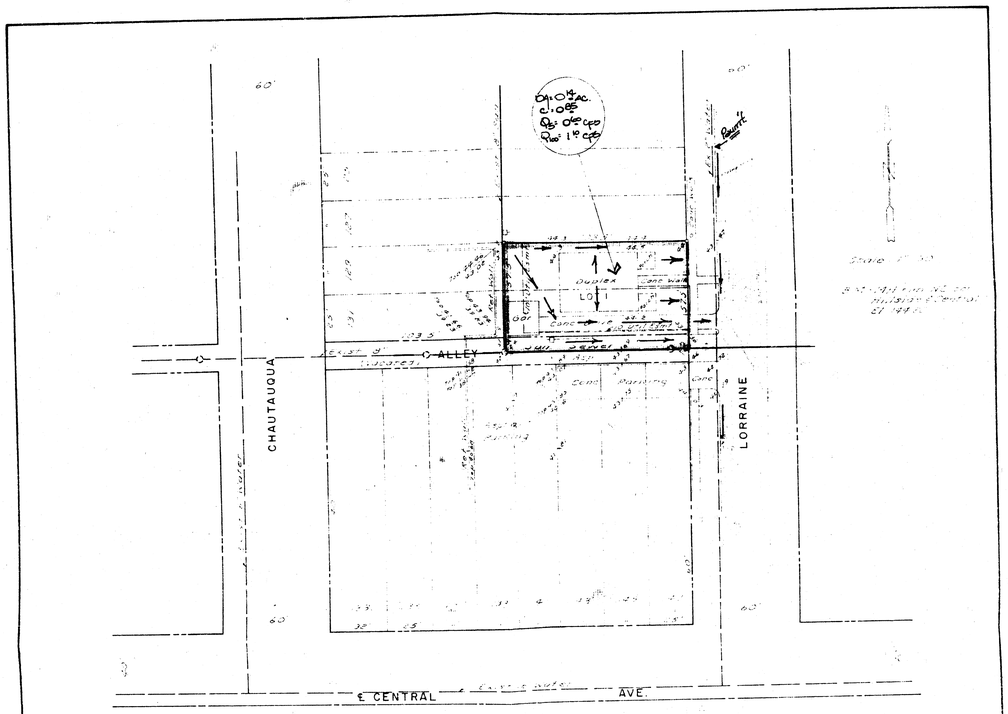

GENERAL NOTES

THE LOT WILL DRAIN EAST TO LORRAINE STREET WHICH DRAINS SOUTH TO CENTRAL. DISCHARGE TO THE STREET WHEN THE SITE IS REDEVELOPED WILL BE THRU THE DRIVEWAY.

SKETCH PLAT

FARROW 2ND ADDITION

A REPLAT OF E.1/2 OF LOTS 129 & 131 & N.1/2 VACATED ALLEY IN BUCK'S 2ND ADD.

DRAINAGE PLAN 5-15-85

BAUGHMAN COMPANY, P.A.
SURVEYING & ENGINEERING
316-262-7271 • 330 I AURA • WICHITA KANSAS 67211