

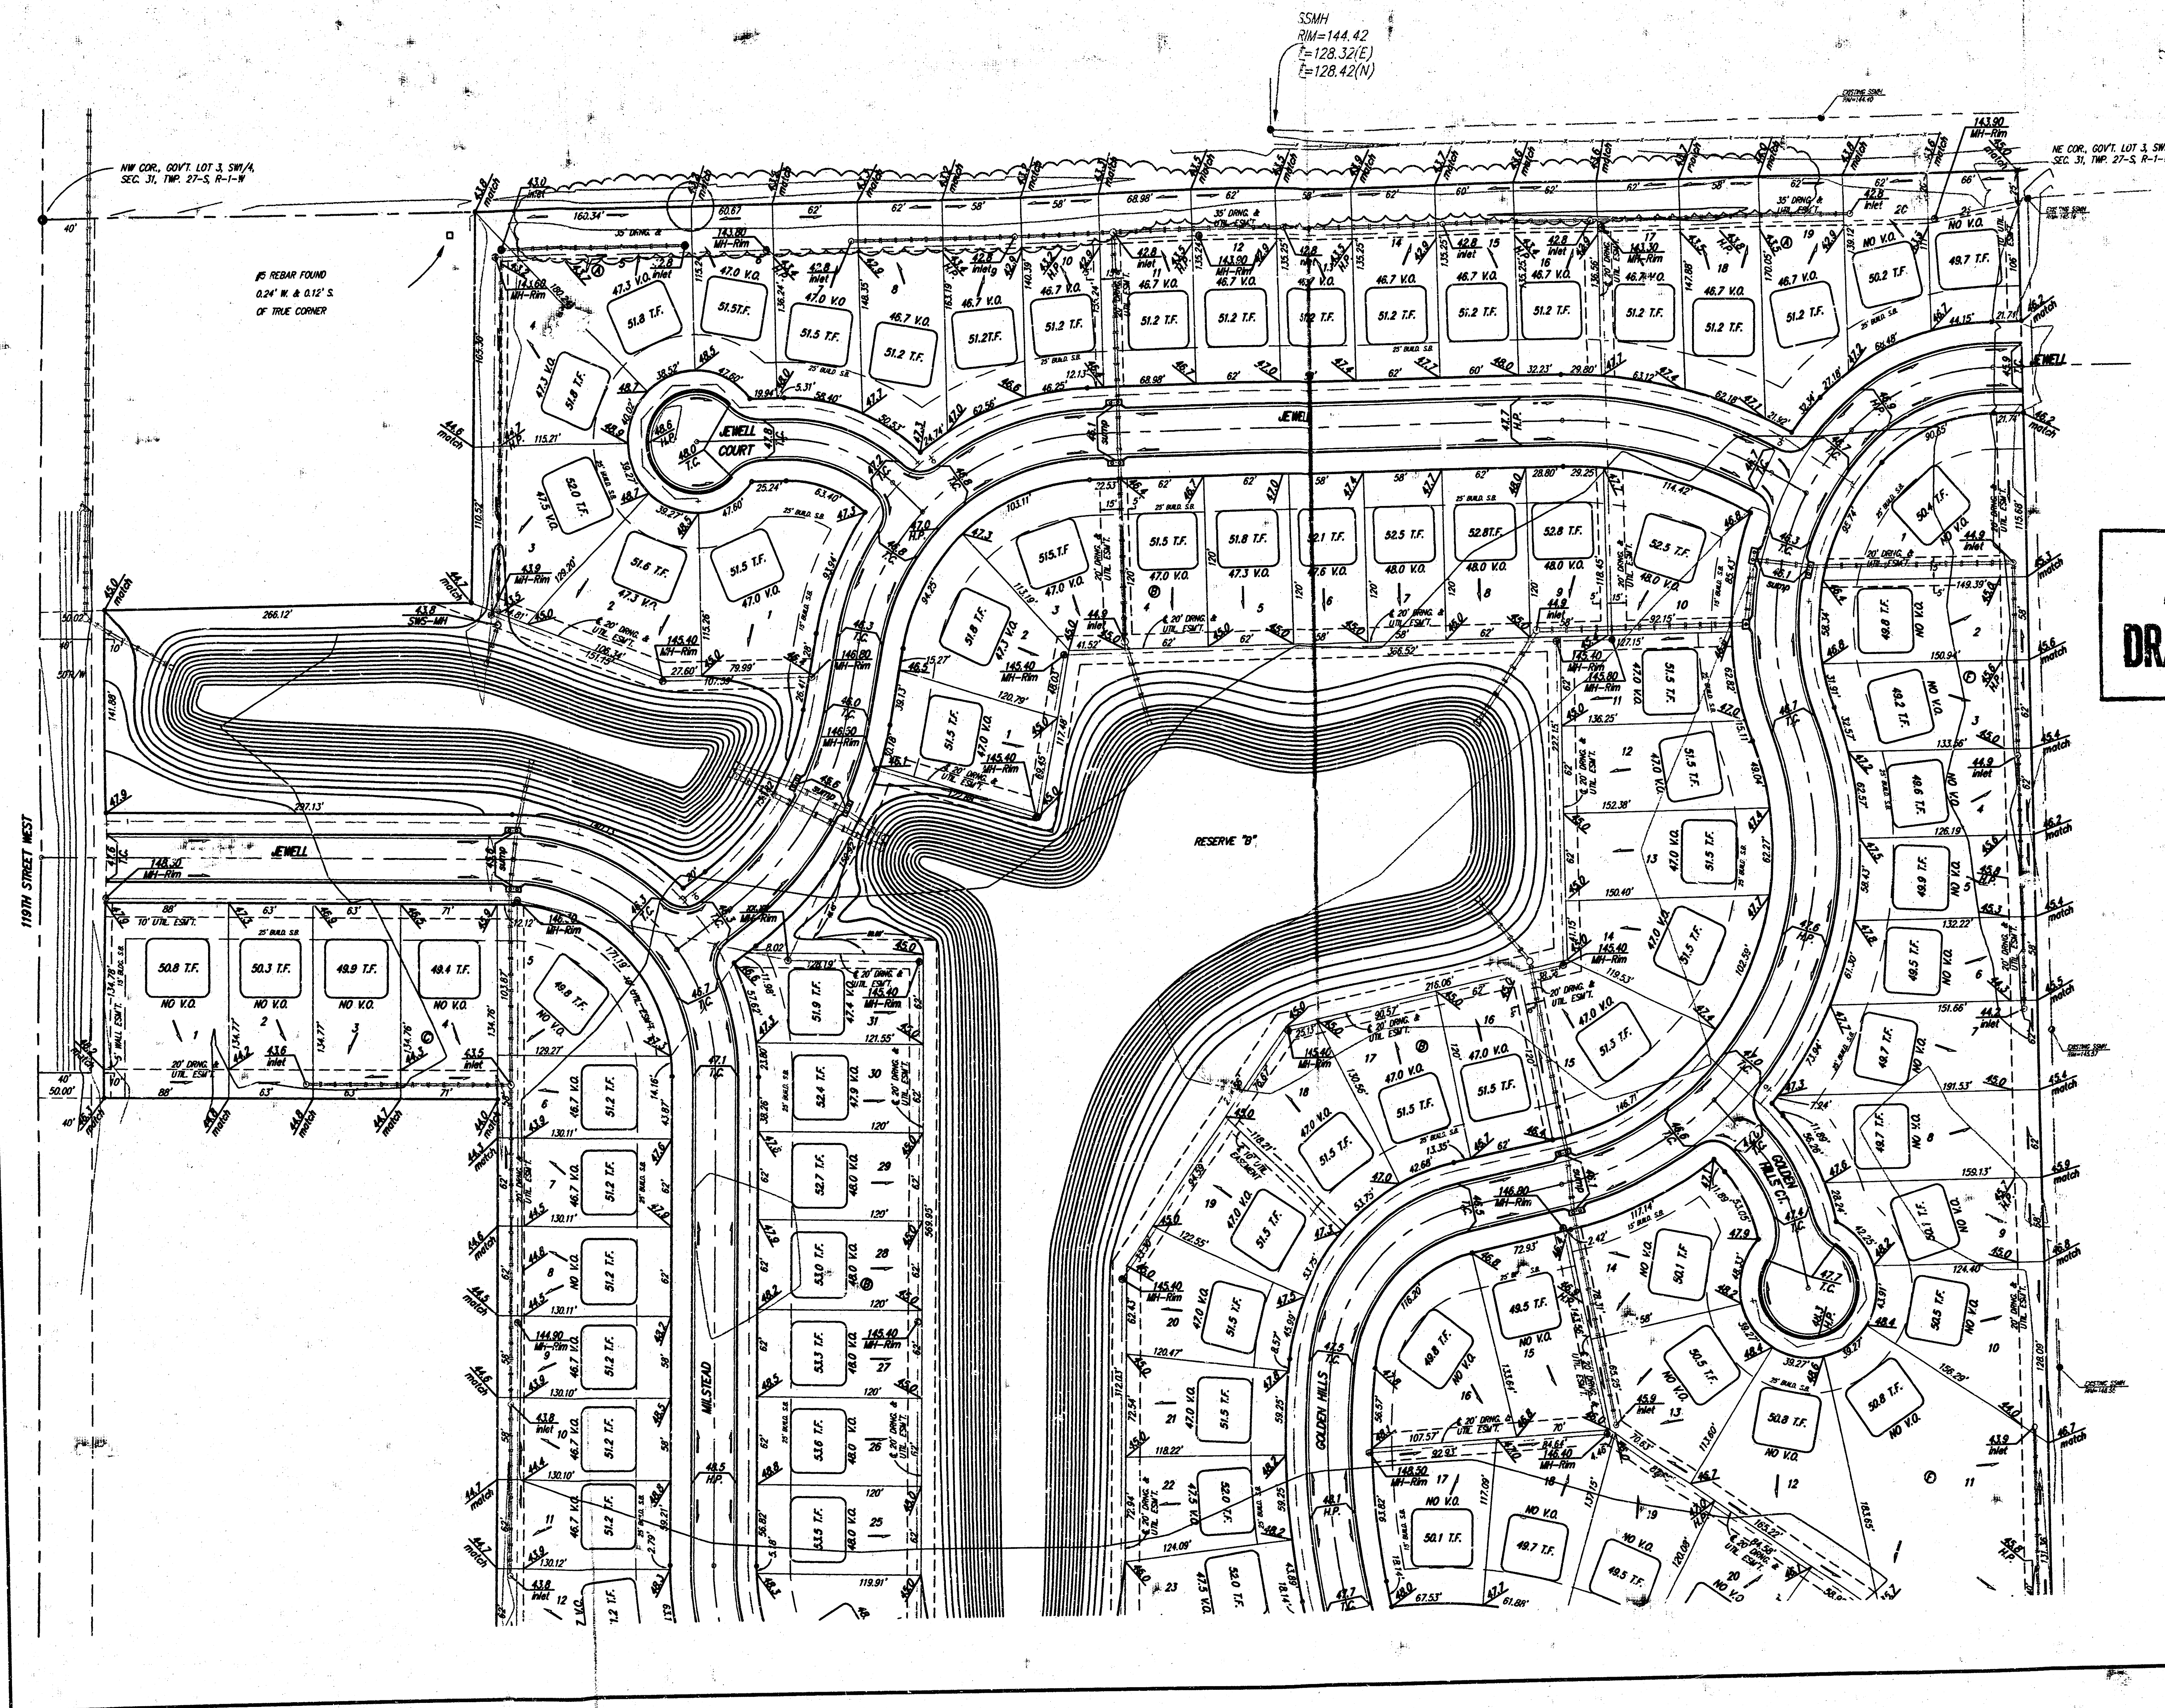


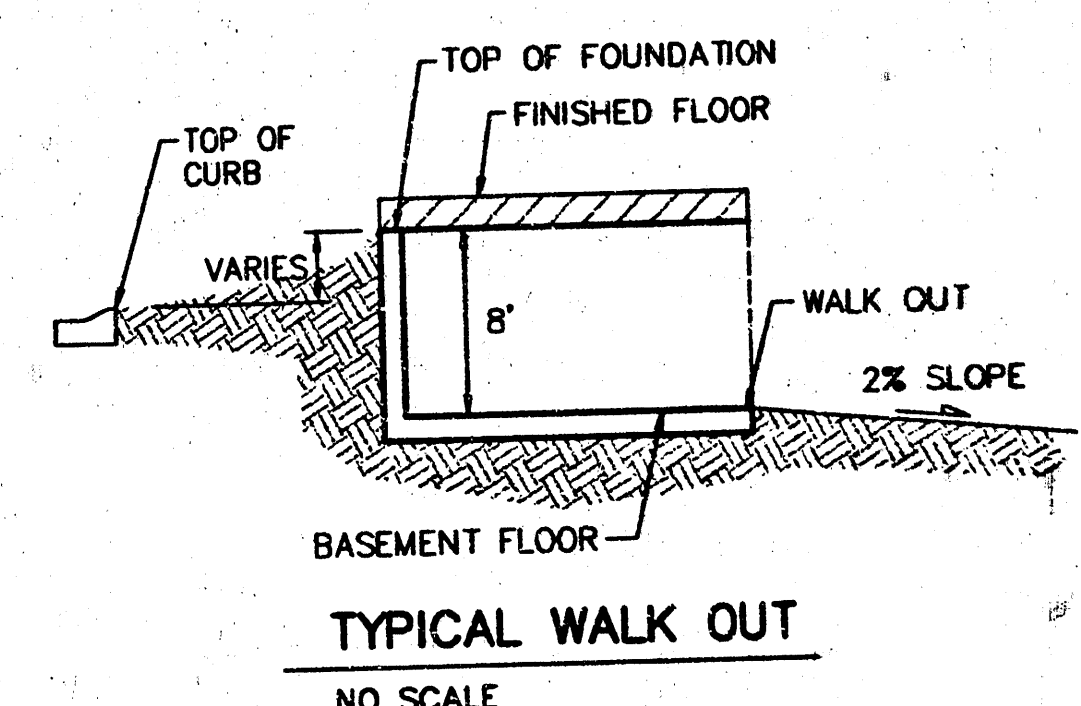


APPROVED DRAINAGE PLAN

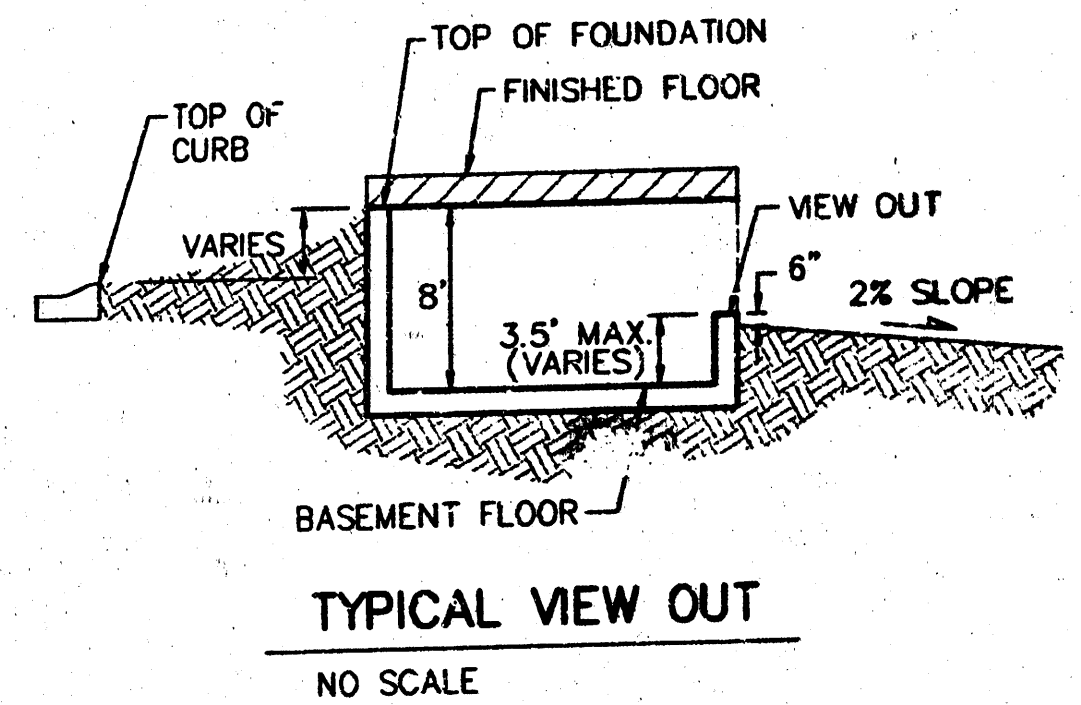

REVISED 3-24-03 BY AEG
 REVISED LOTS 4-6, BLK F & LOT 1, BLK D 1/20/03 BY AEG
 REVISED LOTS 8 & 11, BLK F 1/8/03 BY AEG
 REVISED 8/19/02 BY AEG PER NBW
 Prev. Lots 1-21, Blk A, Dated 2001 BLG

FLAT CREEK ADDITION			
GRADING PLAN			
WICHITA, KANSAS			
BAUGHMAN COMPANY P.A.			
ENGINEERING, SURVEYING, & PLANNING			
316-262-7271 • 315 ELLIS • WICHITA, KANSAS 672-1			
PROJECT NUMBER			
DESIGN	DRAWN	APPROVED	DATE
NGM/BLG	BLG		04/27/01
SCALE			NOTED
SHEET			1
OF			3

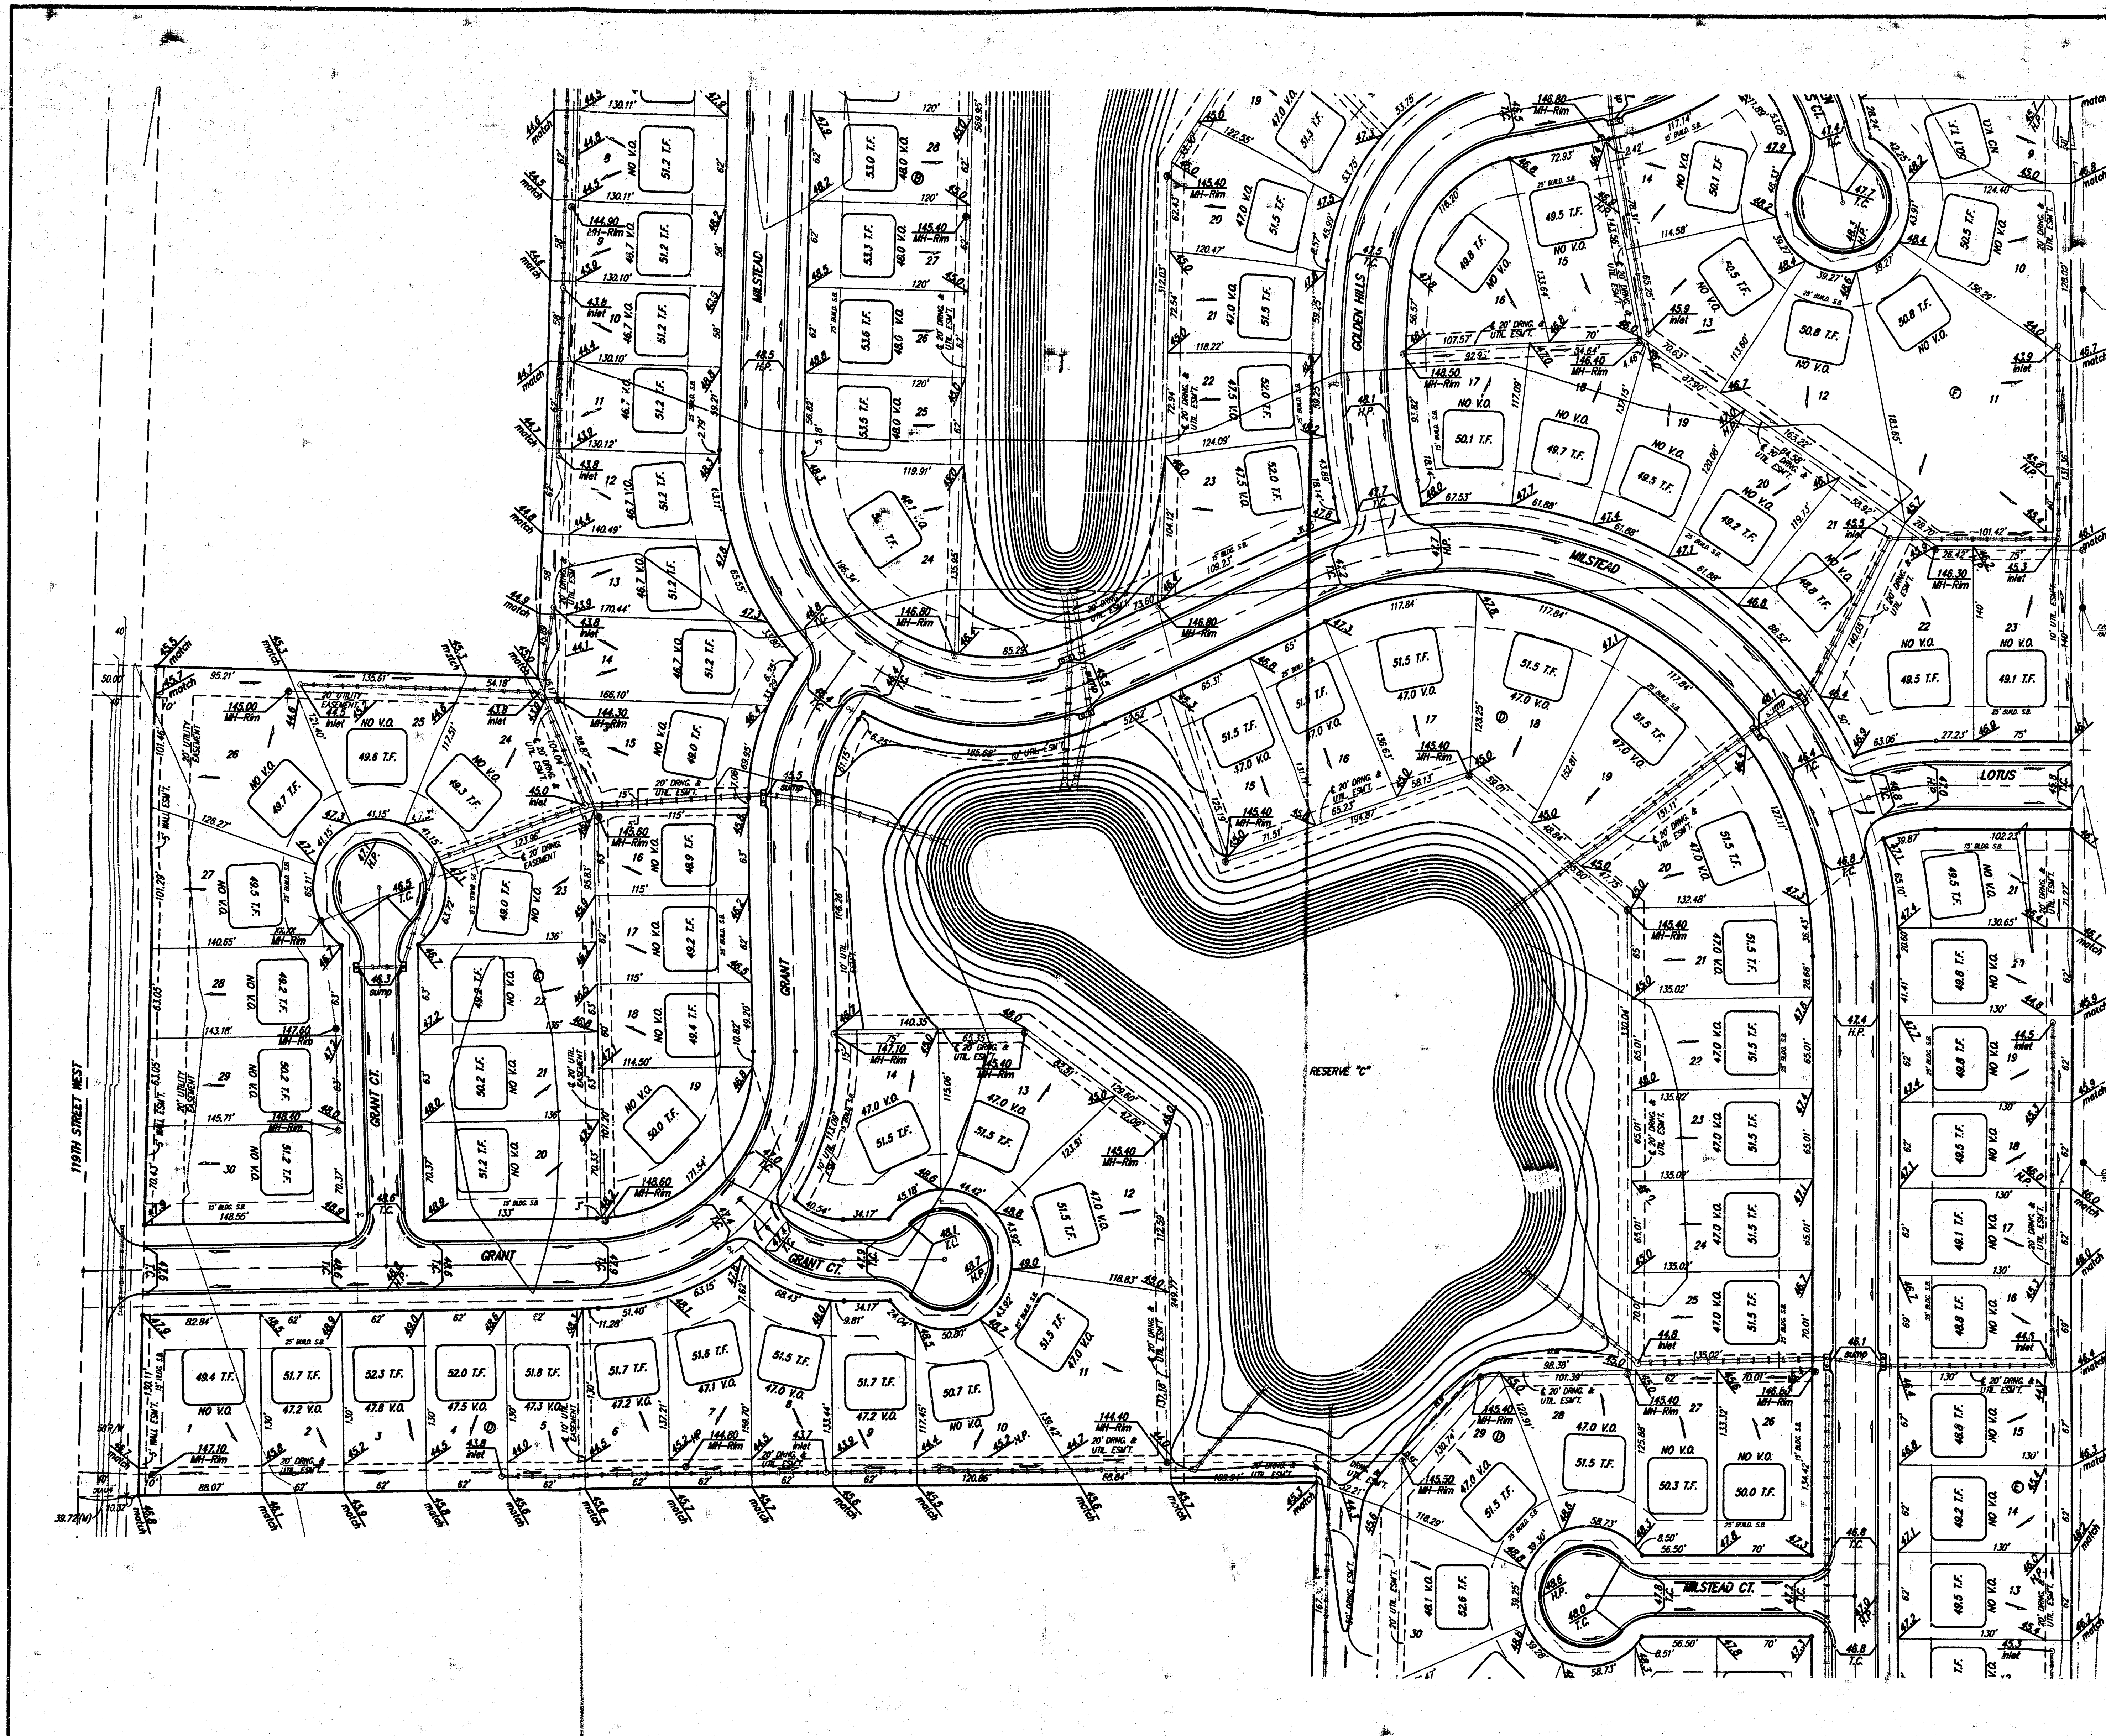

SCALE:
1" = 60'
• = IRON

BENCHMARK
City of Wichita Benchmark Disc.
located North and East of the intersection
of 119th St. West and Pawnee.
Elev. = 148.68 City Datum
= 1336.08 NGVD

NOTE:
Minimum building pad elevation
for the lowest opening to the
structures on all lots in this
subdivision shall be 146.7 city
datum (1334.1 NGVD).



NOTE:
All lots within Flat Creek Addition
shall have a 5 foot interior
sideyard setback.

NOTE:
Proposed top of foundation are shown
on plans. Contractor to set finish floor
elevation.

All street elevations shown on plans
are for top of curb (full height).


View-out elevations are denoted as
XX.X V.O.
Walk-out elevations are denoted as
XX.X W.O.

CONTOUR INTERVAL = 1 FT.

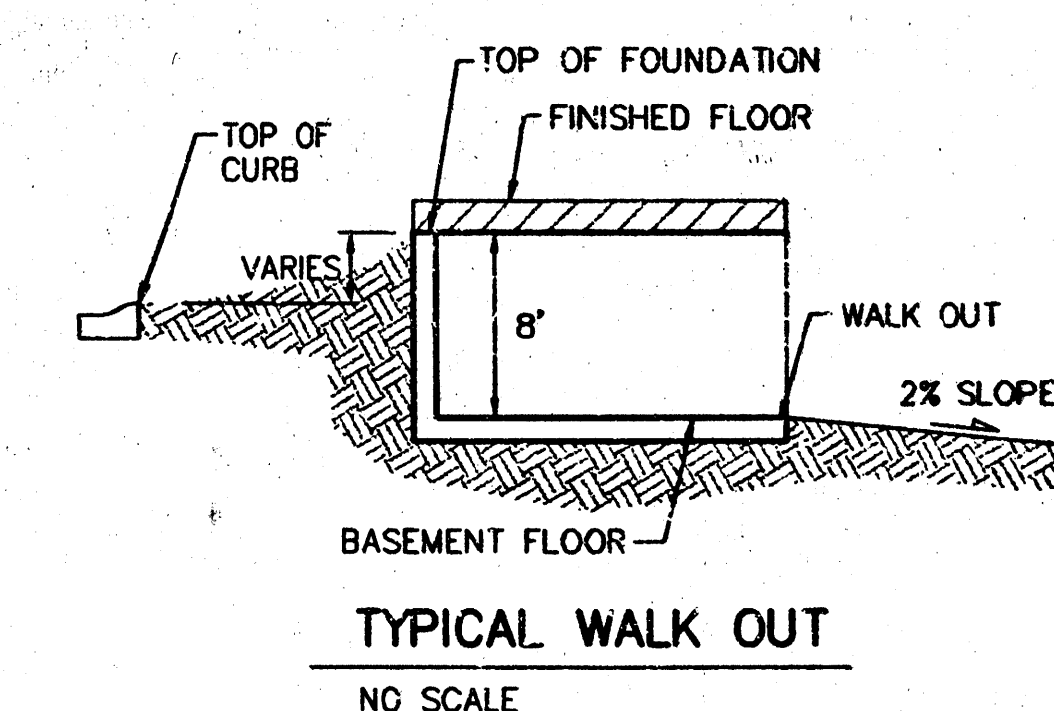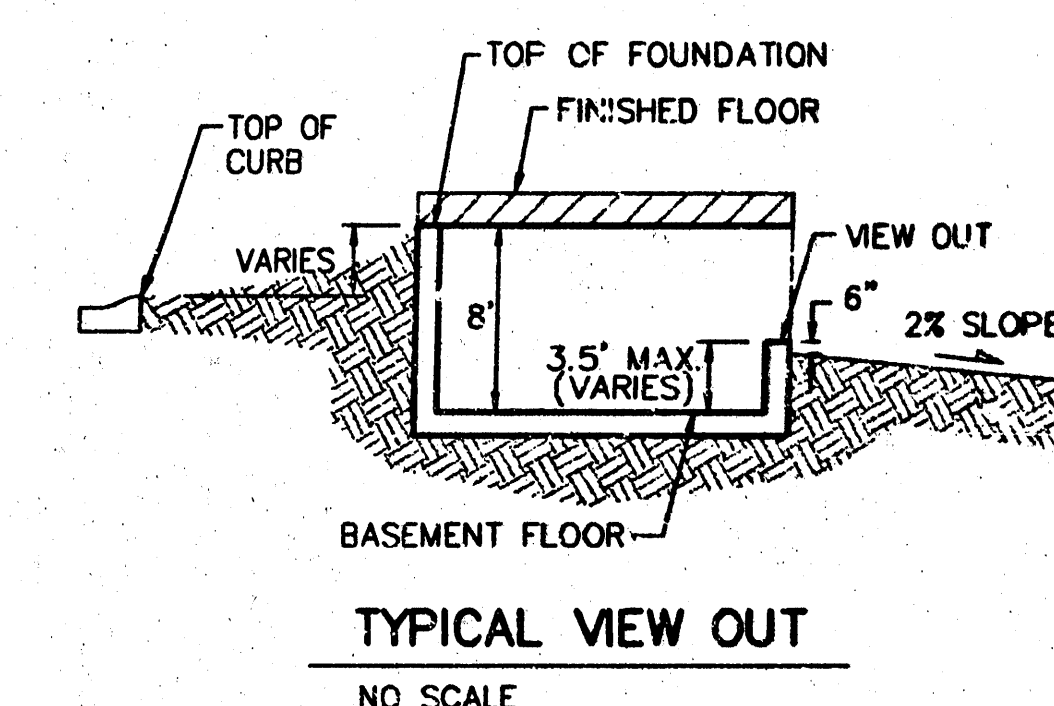

REVISED 3-24-03 BY AEG
REVISED LOTS 4-6, BLK F & LOT 1, BLK D 1/20/03 BY AEG
REVISED LOTS 8 & 11, BLK F 1/8/03 BY AEG
REVISED 2/19/02 BY AEG PER NGM

FLAT CREEK ADDITION GRADING PLAN WICHITA, KANSAS				
BAUGHMAN COMPANY P.A. ENGINEERING, SURVEYING, & PLANNING 315-262-7271 • 315 ELLIS • WICHITA, KANSAS 67211				
PROJECT NUMBER				
DESIGN NGM, BLG	DRAWN BLG	APPROVED	DATE 04/27/01	SCALE NOTED
				SHEET 2 OF 8

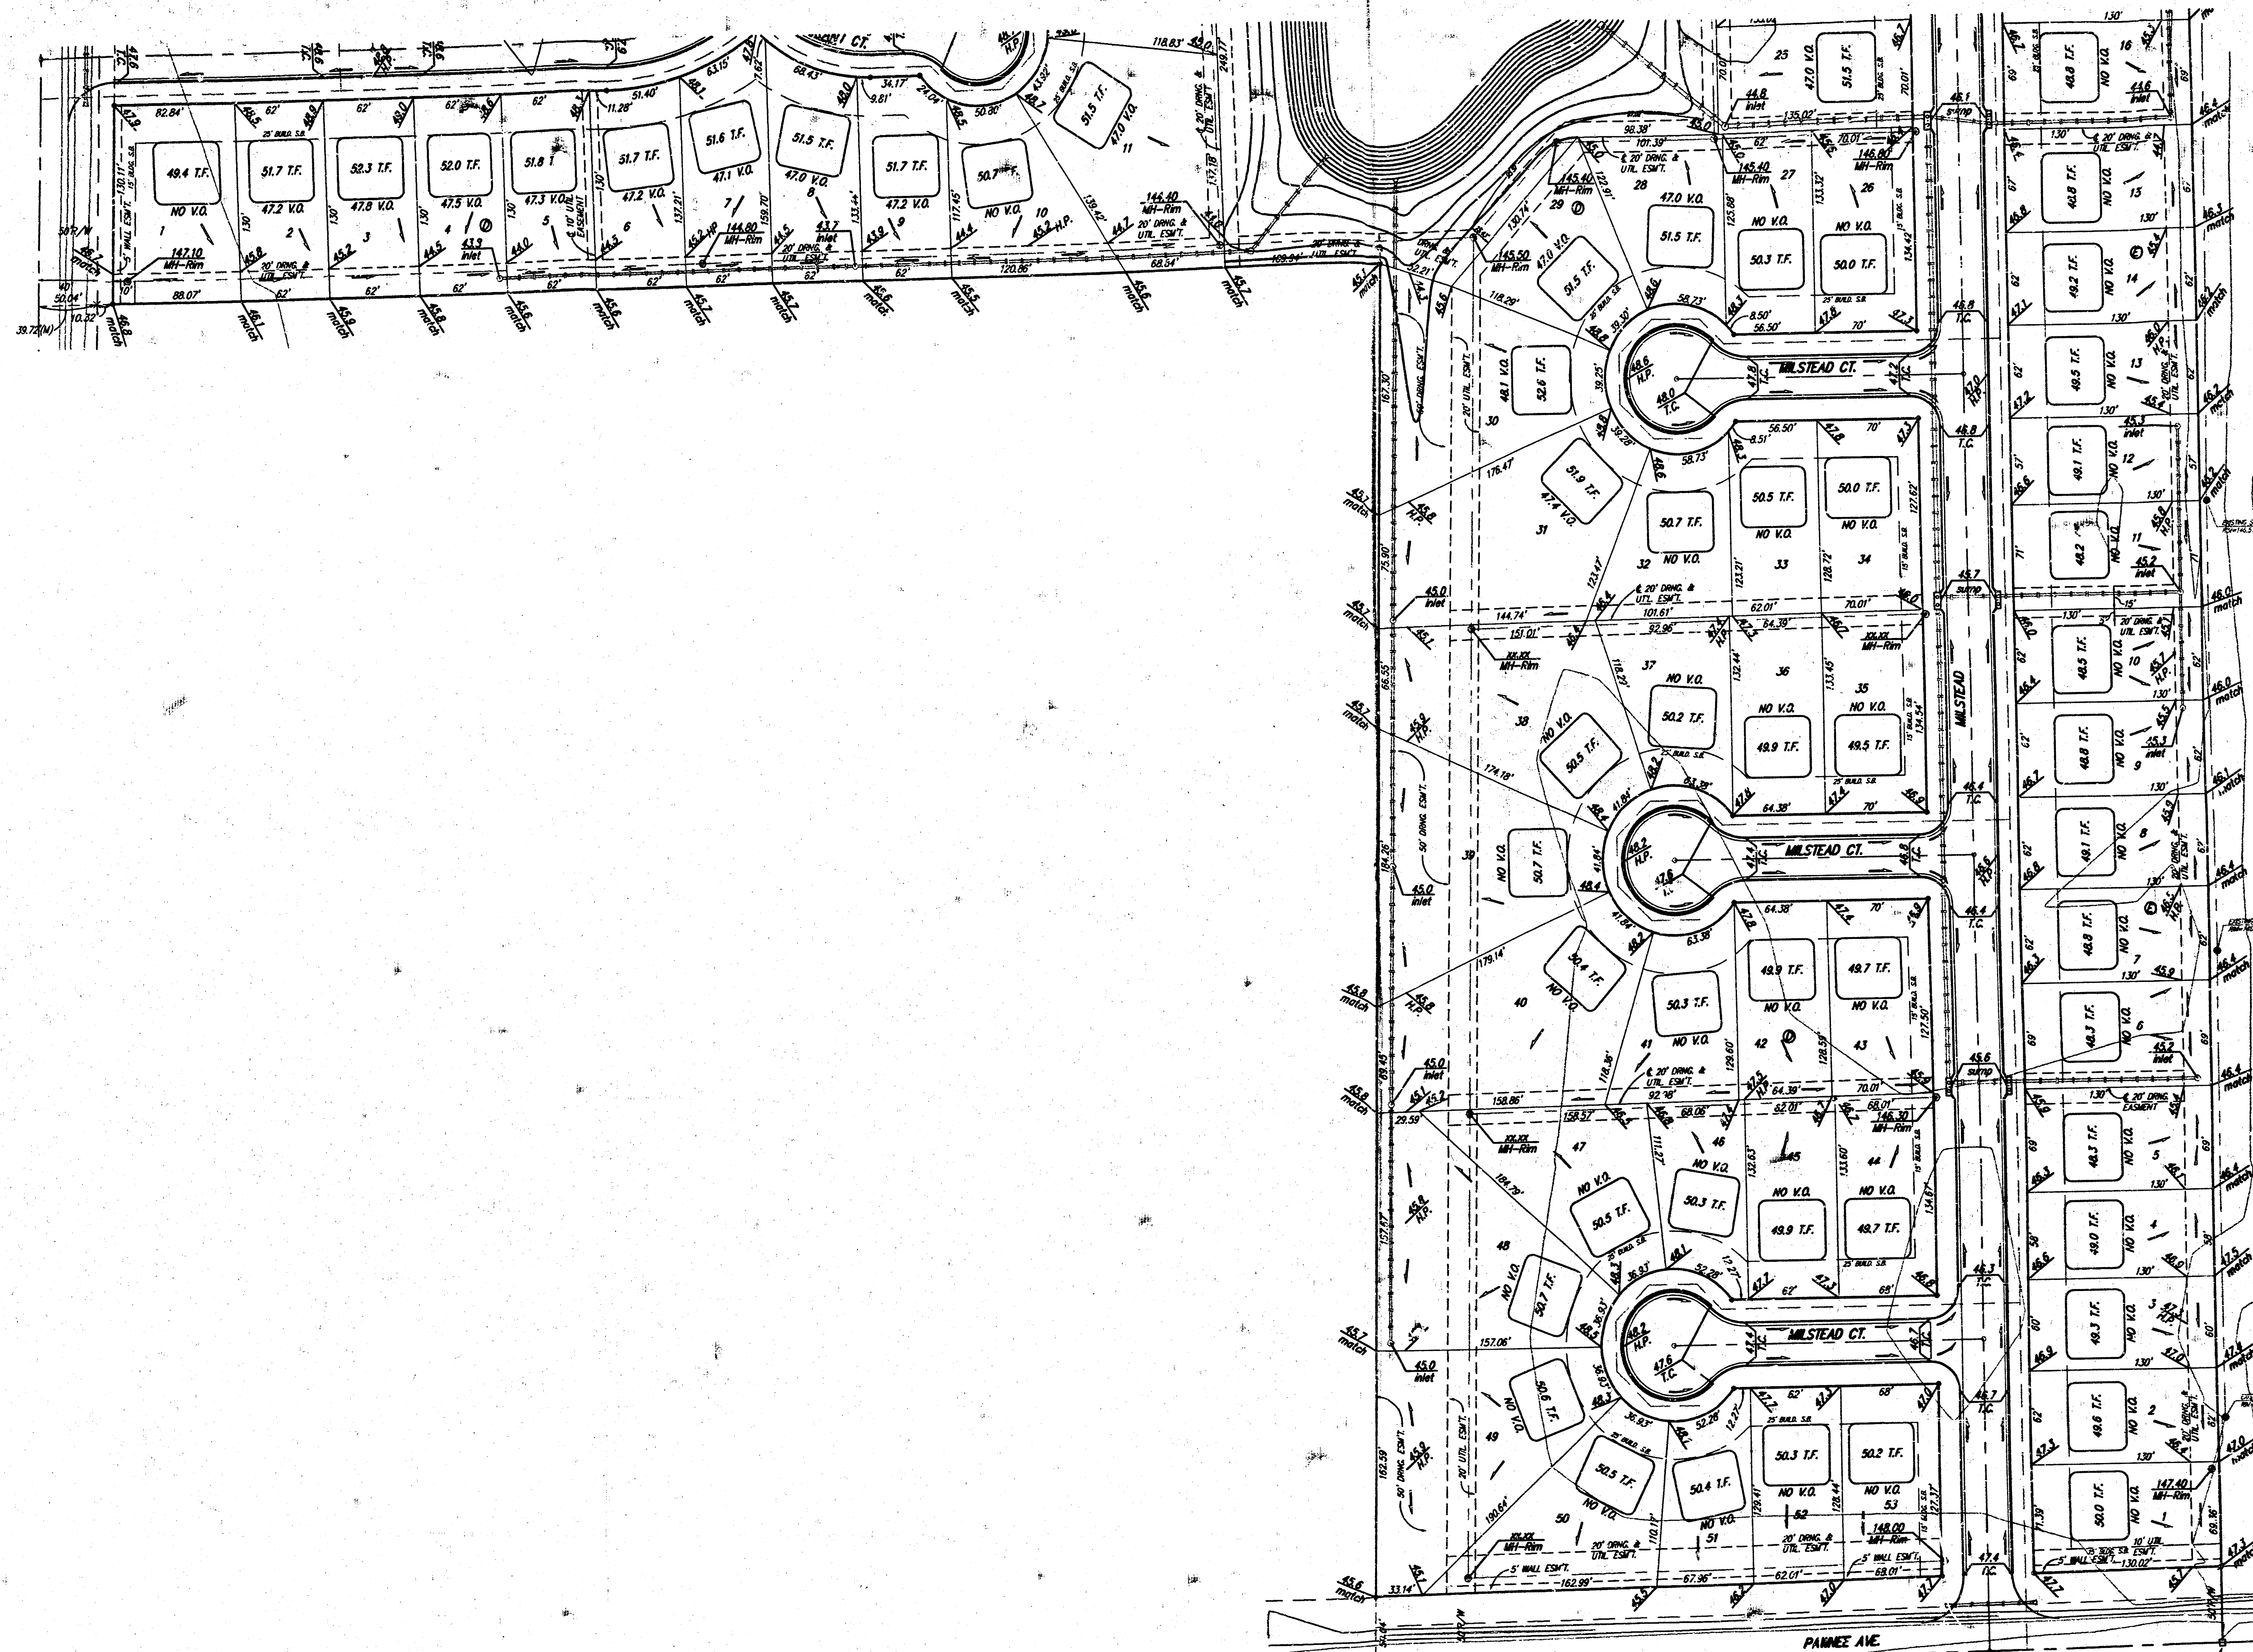

SCALE:
1" = 60'
• = IRN

BENCHMARK
City of Wichita Benchmark Disc.
located North and East of the intersection
of 119th St. West and Pamnee.
Elev. = 143.68 City Datum
= 1336.08 NGVD

NOTE:
Minimum building pad elevation
for the lowest opening to the
structures on all lots in this
subdivision shall be 146.7 city
datum (1334.1 NGVD).



NOTE:
All lots within Flat Creek Addition
shall have a 5 foot interior
sidewalk setback.

NOTE:
Proposed top of foundation are shown
on plans. Contractor to set finish floor
elevation.

All street elevations shown on plans
are for top of curb (full height).

View-out elevations are denoted as
XX.X V.O.
Walk-out elevations are denoted as
XX.X W.O.

CONTOUR INTERVAL = 1 FT.

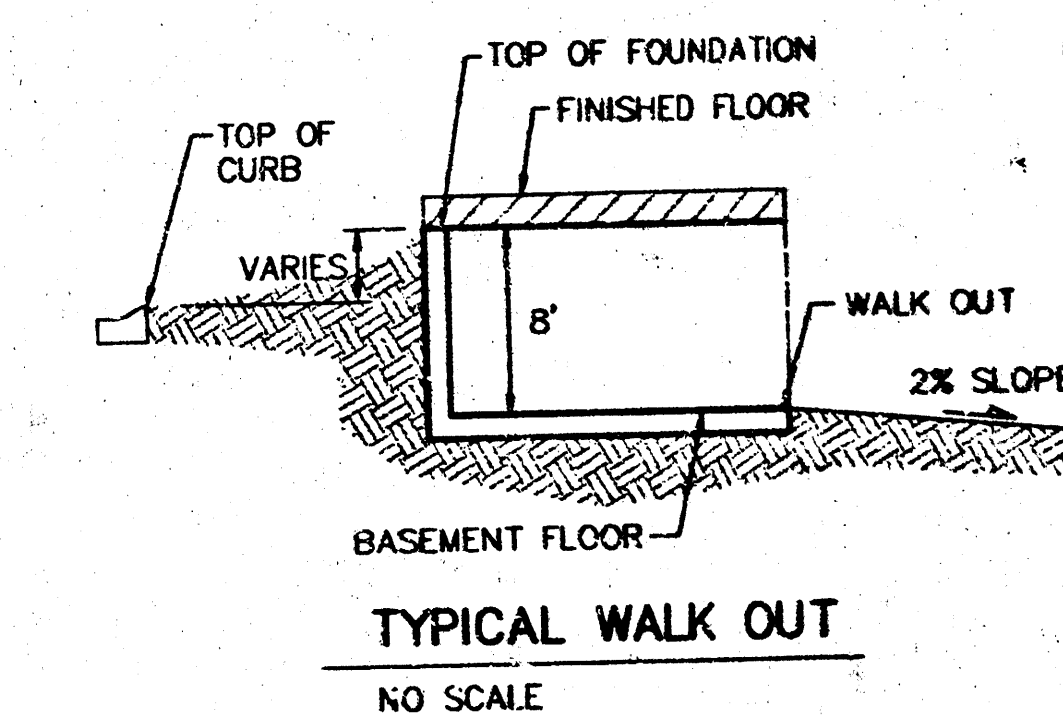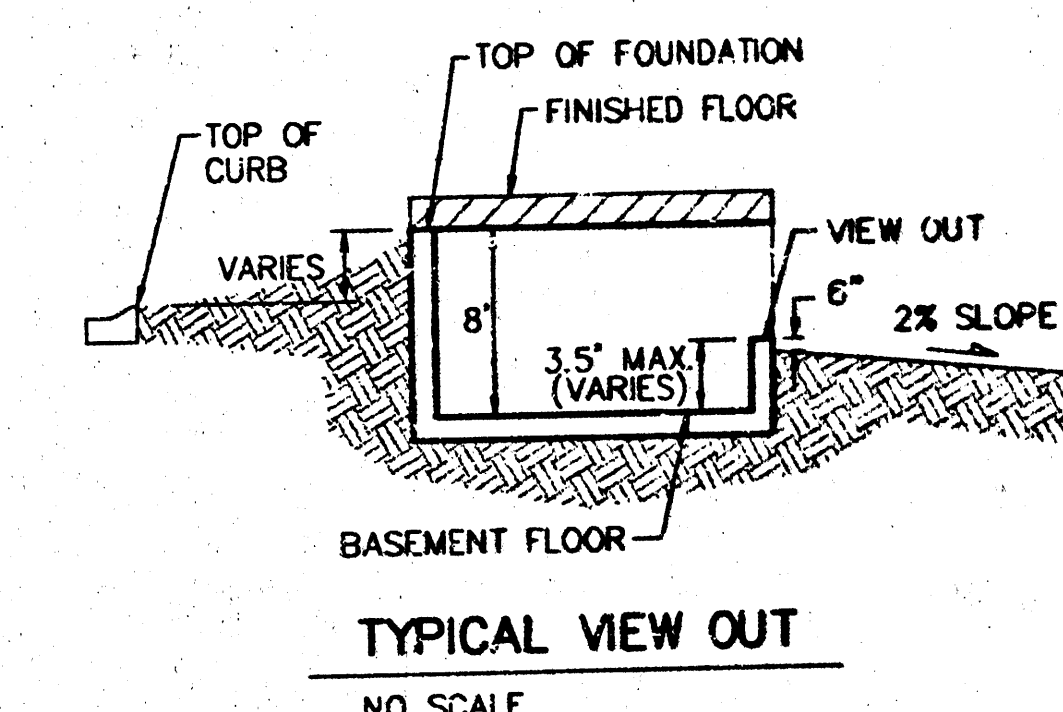

REVISED 3-24-03 BY AEG
REVISED LOTS 4-6, BLK F & LOT 1, BLK D 1/20/03 BY AEG
REVISED 8/19/02 BY AEG P/R NEW

FLAT CREEK ADDITION			
GRADING PLAN			
WICHITA, KANSAS			
BAUGHMAN COMPANY P.A.			
ENGINEERING, SURVEYING, & PLANNING			
316-262-7234 • 315 ELLIS • WICHITA, KANSAS 67211			
PROJECT NUMBER			
DESIGN	DRAWN	APPROVED	DATE
NEW, BLG	BLG		04/27/01
SCALE			SHEET
NOTED			3