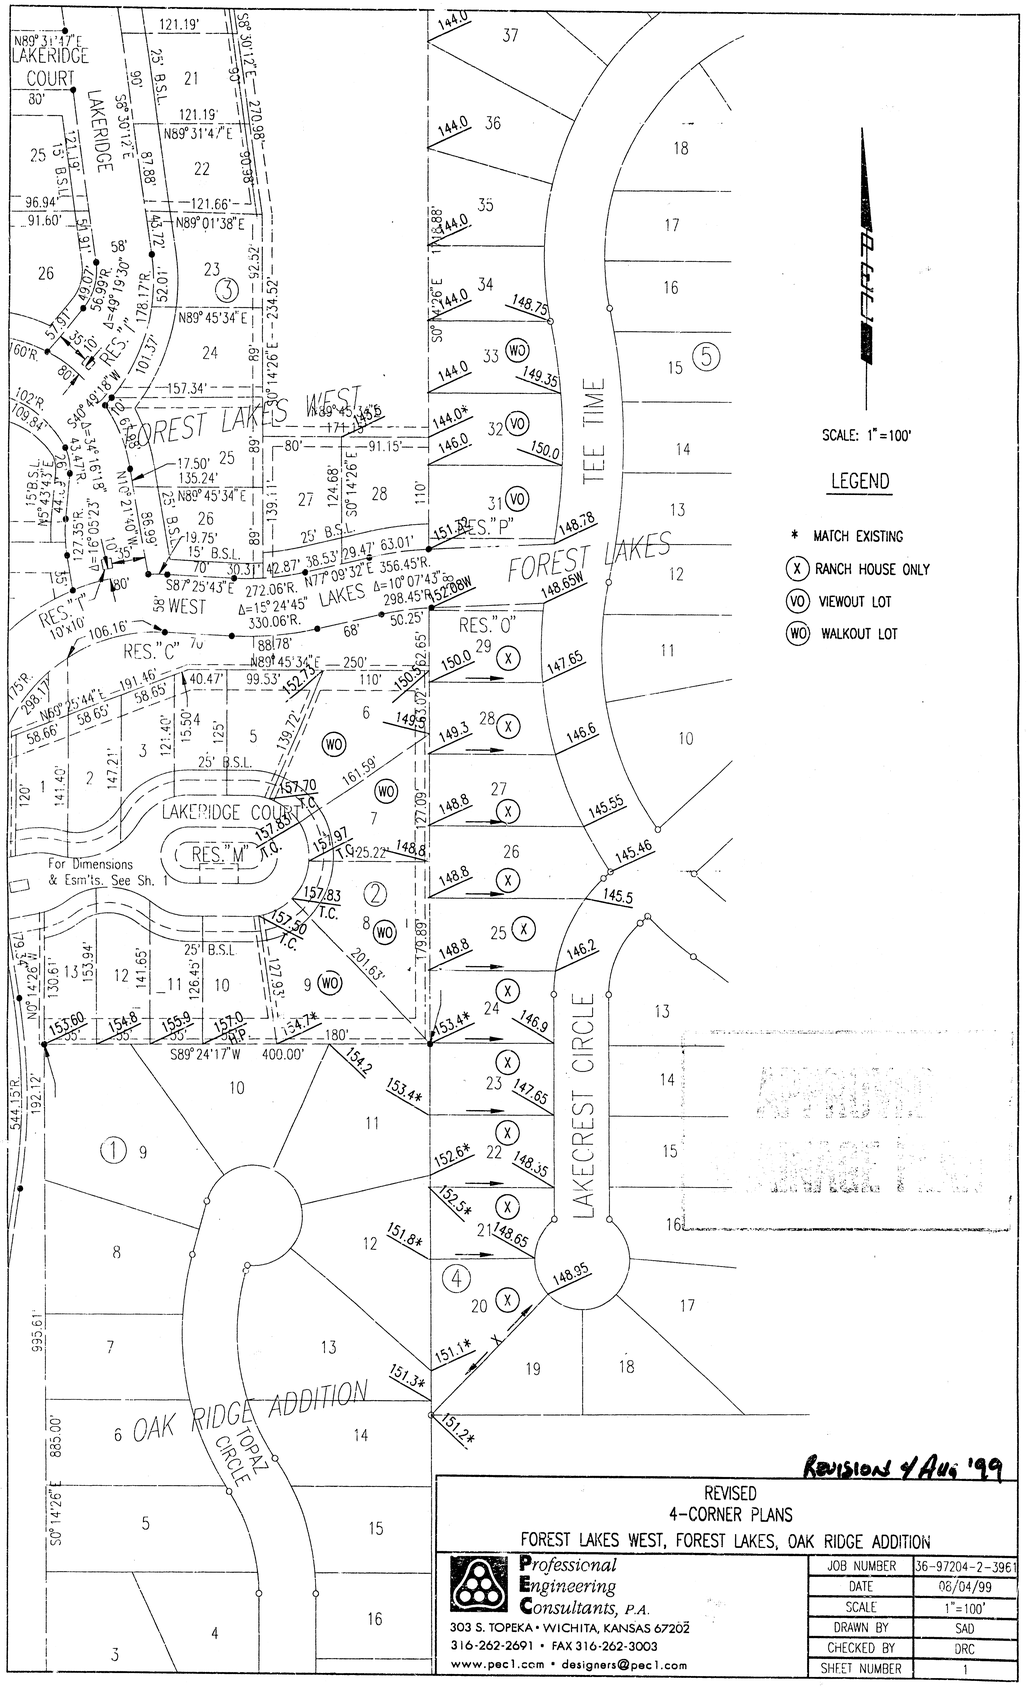


Revisions 4 Aug '99

REVISED
4-CORNER PLANS
FOREST LAKES WEST, FOREST LAKES, OAK RIDGE ADDITION

Professional Engineering Consultants, P.A.
303 S. TOPEKA • WICHITA, KANSAS 67202
316-262-2691 • FAX 316-262-3003
www.pec1.com • designers@pec1.com

JOB NUMBER	36-97204-2-3961
DATE	08/04/99
SCALE	1"=100'
DRAWN BY	SAD
CHECKED BY	DRC
SHEET NUMBER	1