


FRUITVALE PARK 2ND ADDITION
(Drainage)

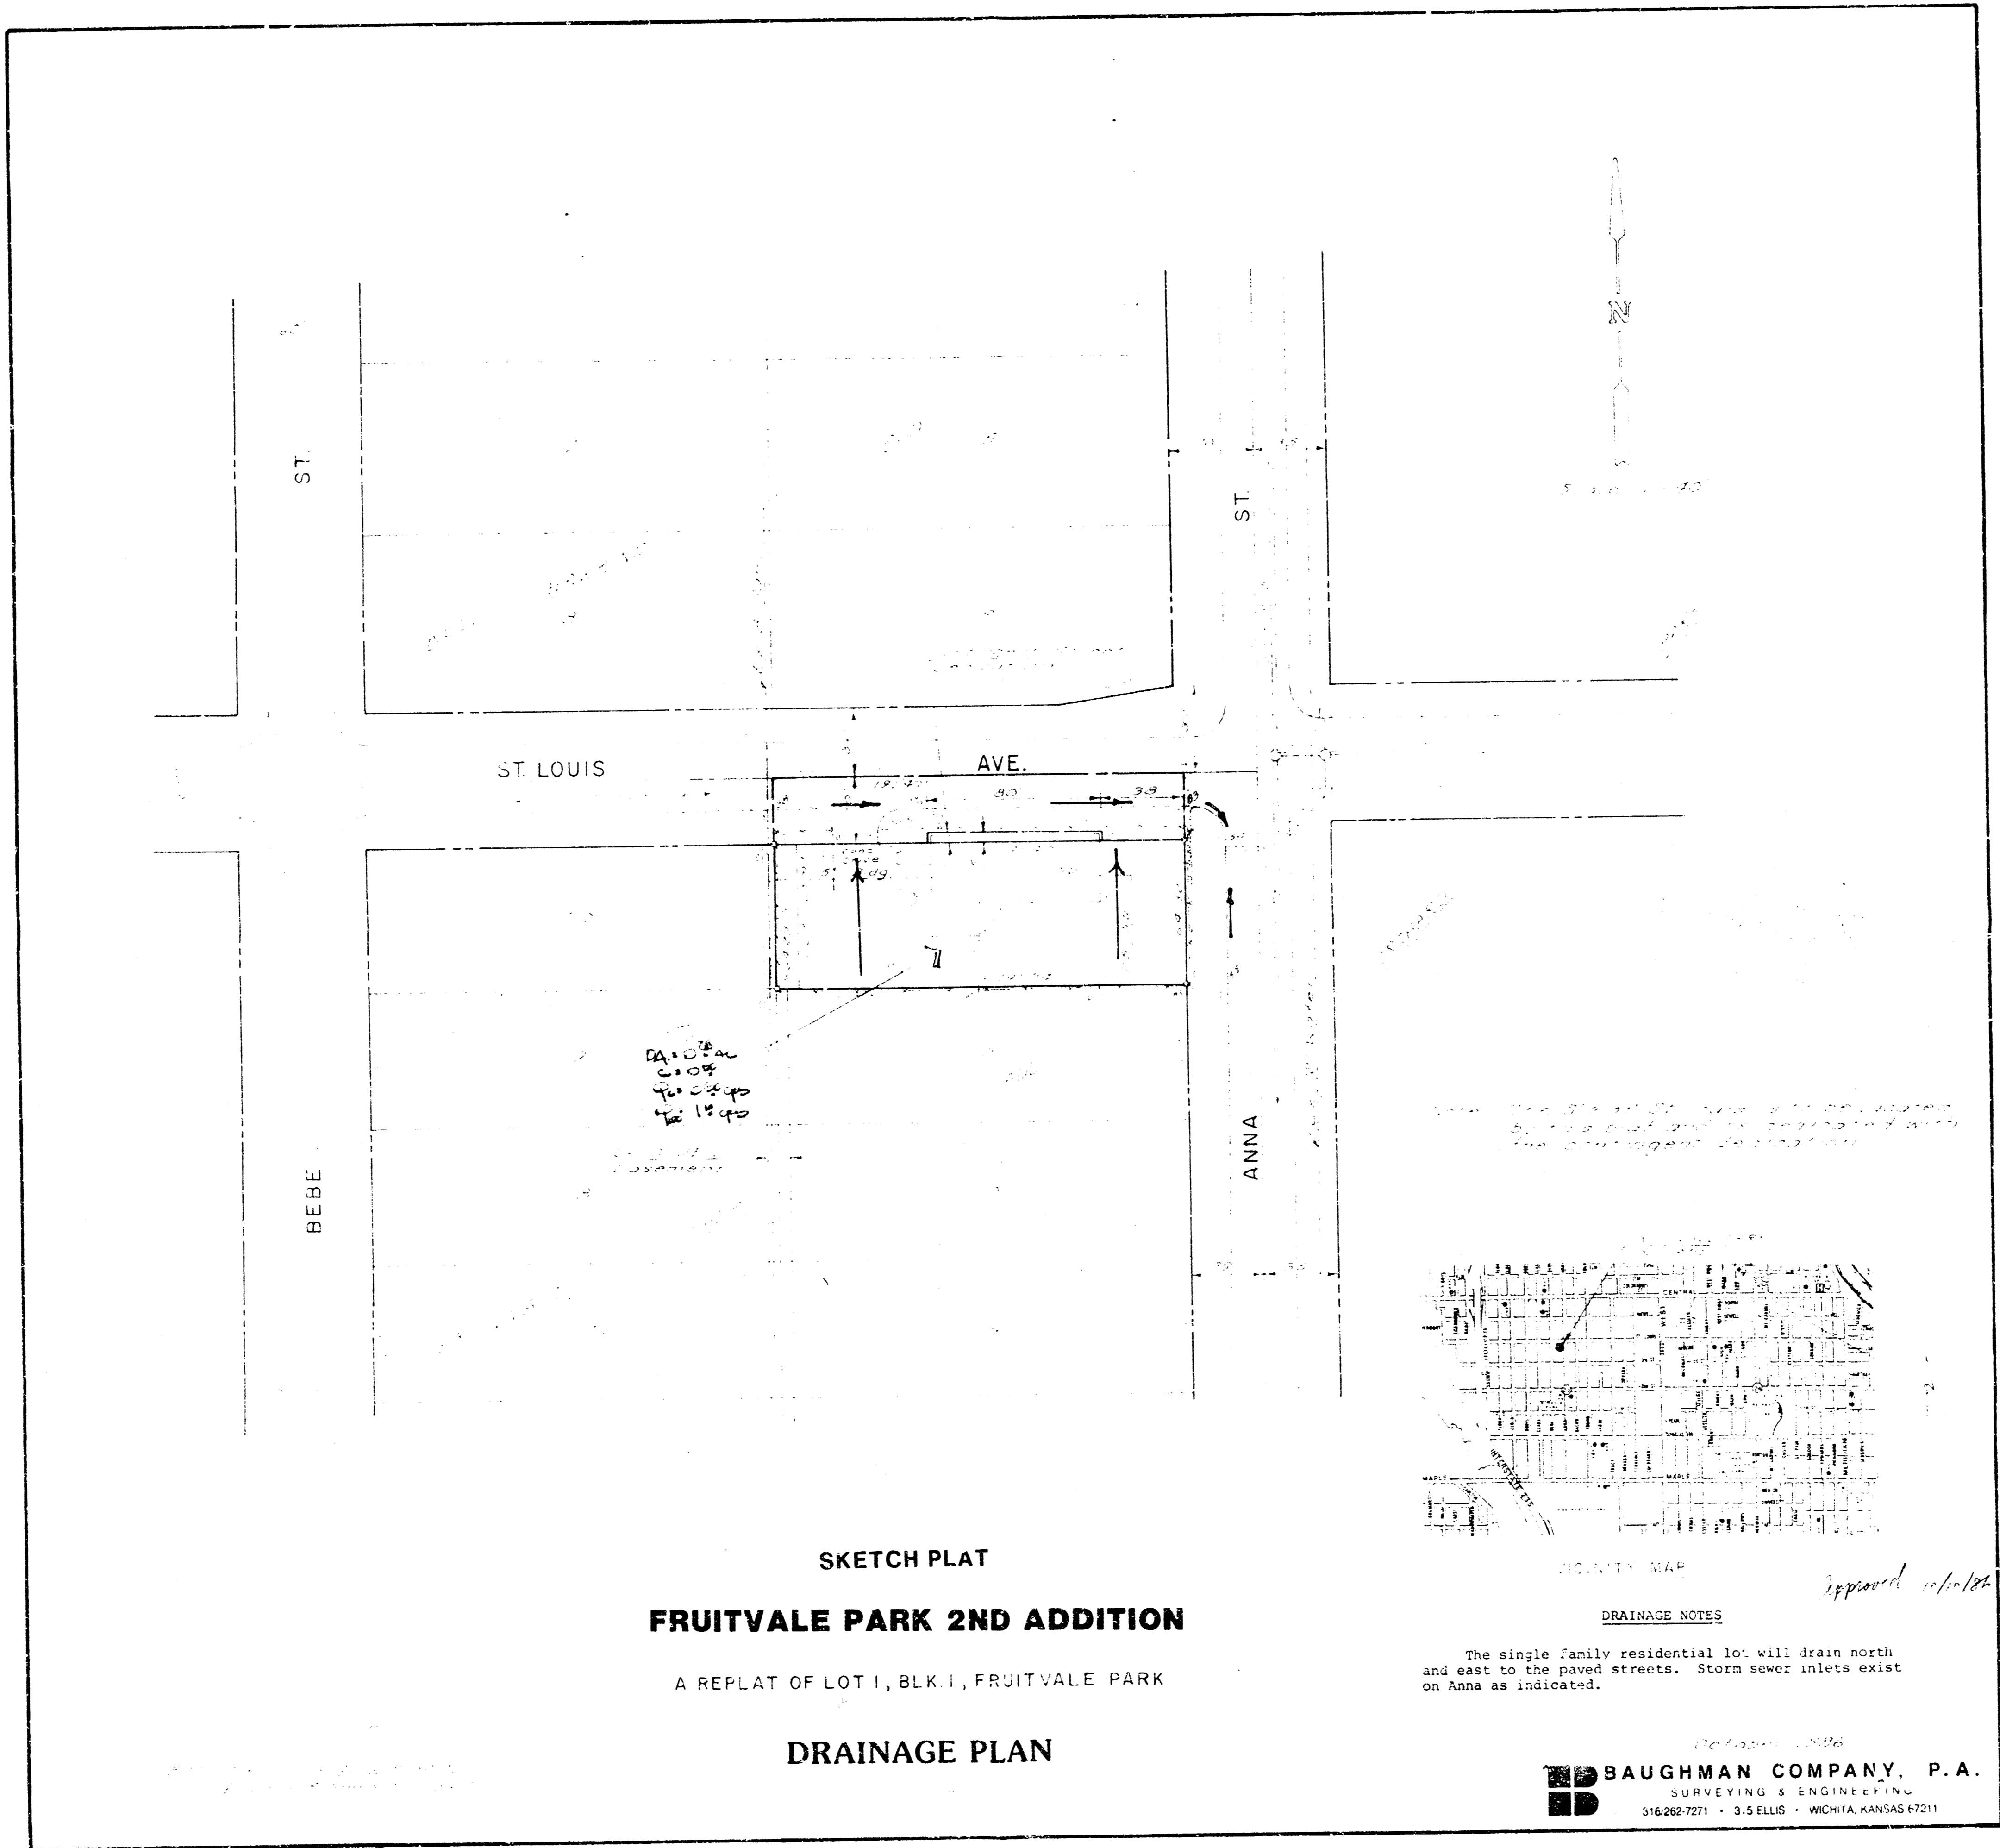

SKETCH PLAT
FRUITVALE PARK 2ND ADDITION

A REPLAT OF LOT 1, BLK. 1, FRUITVALE PARK

DRAINAGE PLAN

DRAINAGE NOTES
The single family residential lot will drain north and east to the paved streets. Storm sewer inlets exist on Anna as indicated.

BAUGHMAN COMPANY, P.A.
SURVEYING & ENGINEERING
316.262.7271 • 3.5 ELLIS • WICHITA, KANSAS 67211