


SKETCH PLAT GOEBEL BROS. 4TH ADDITION

WICHITA, SEDGWICK COUNTY, KANSAS

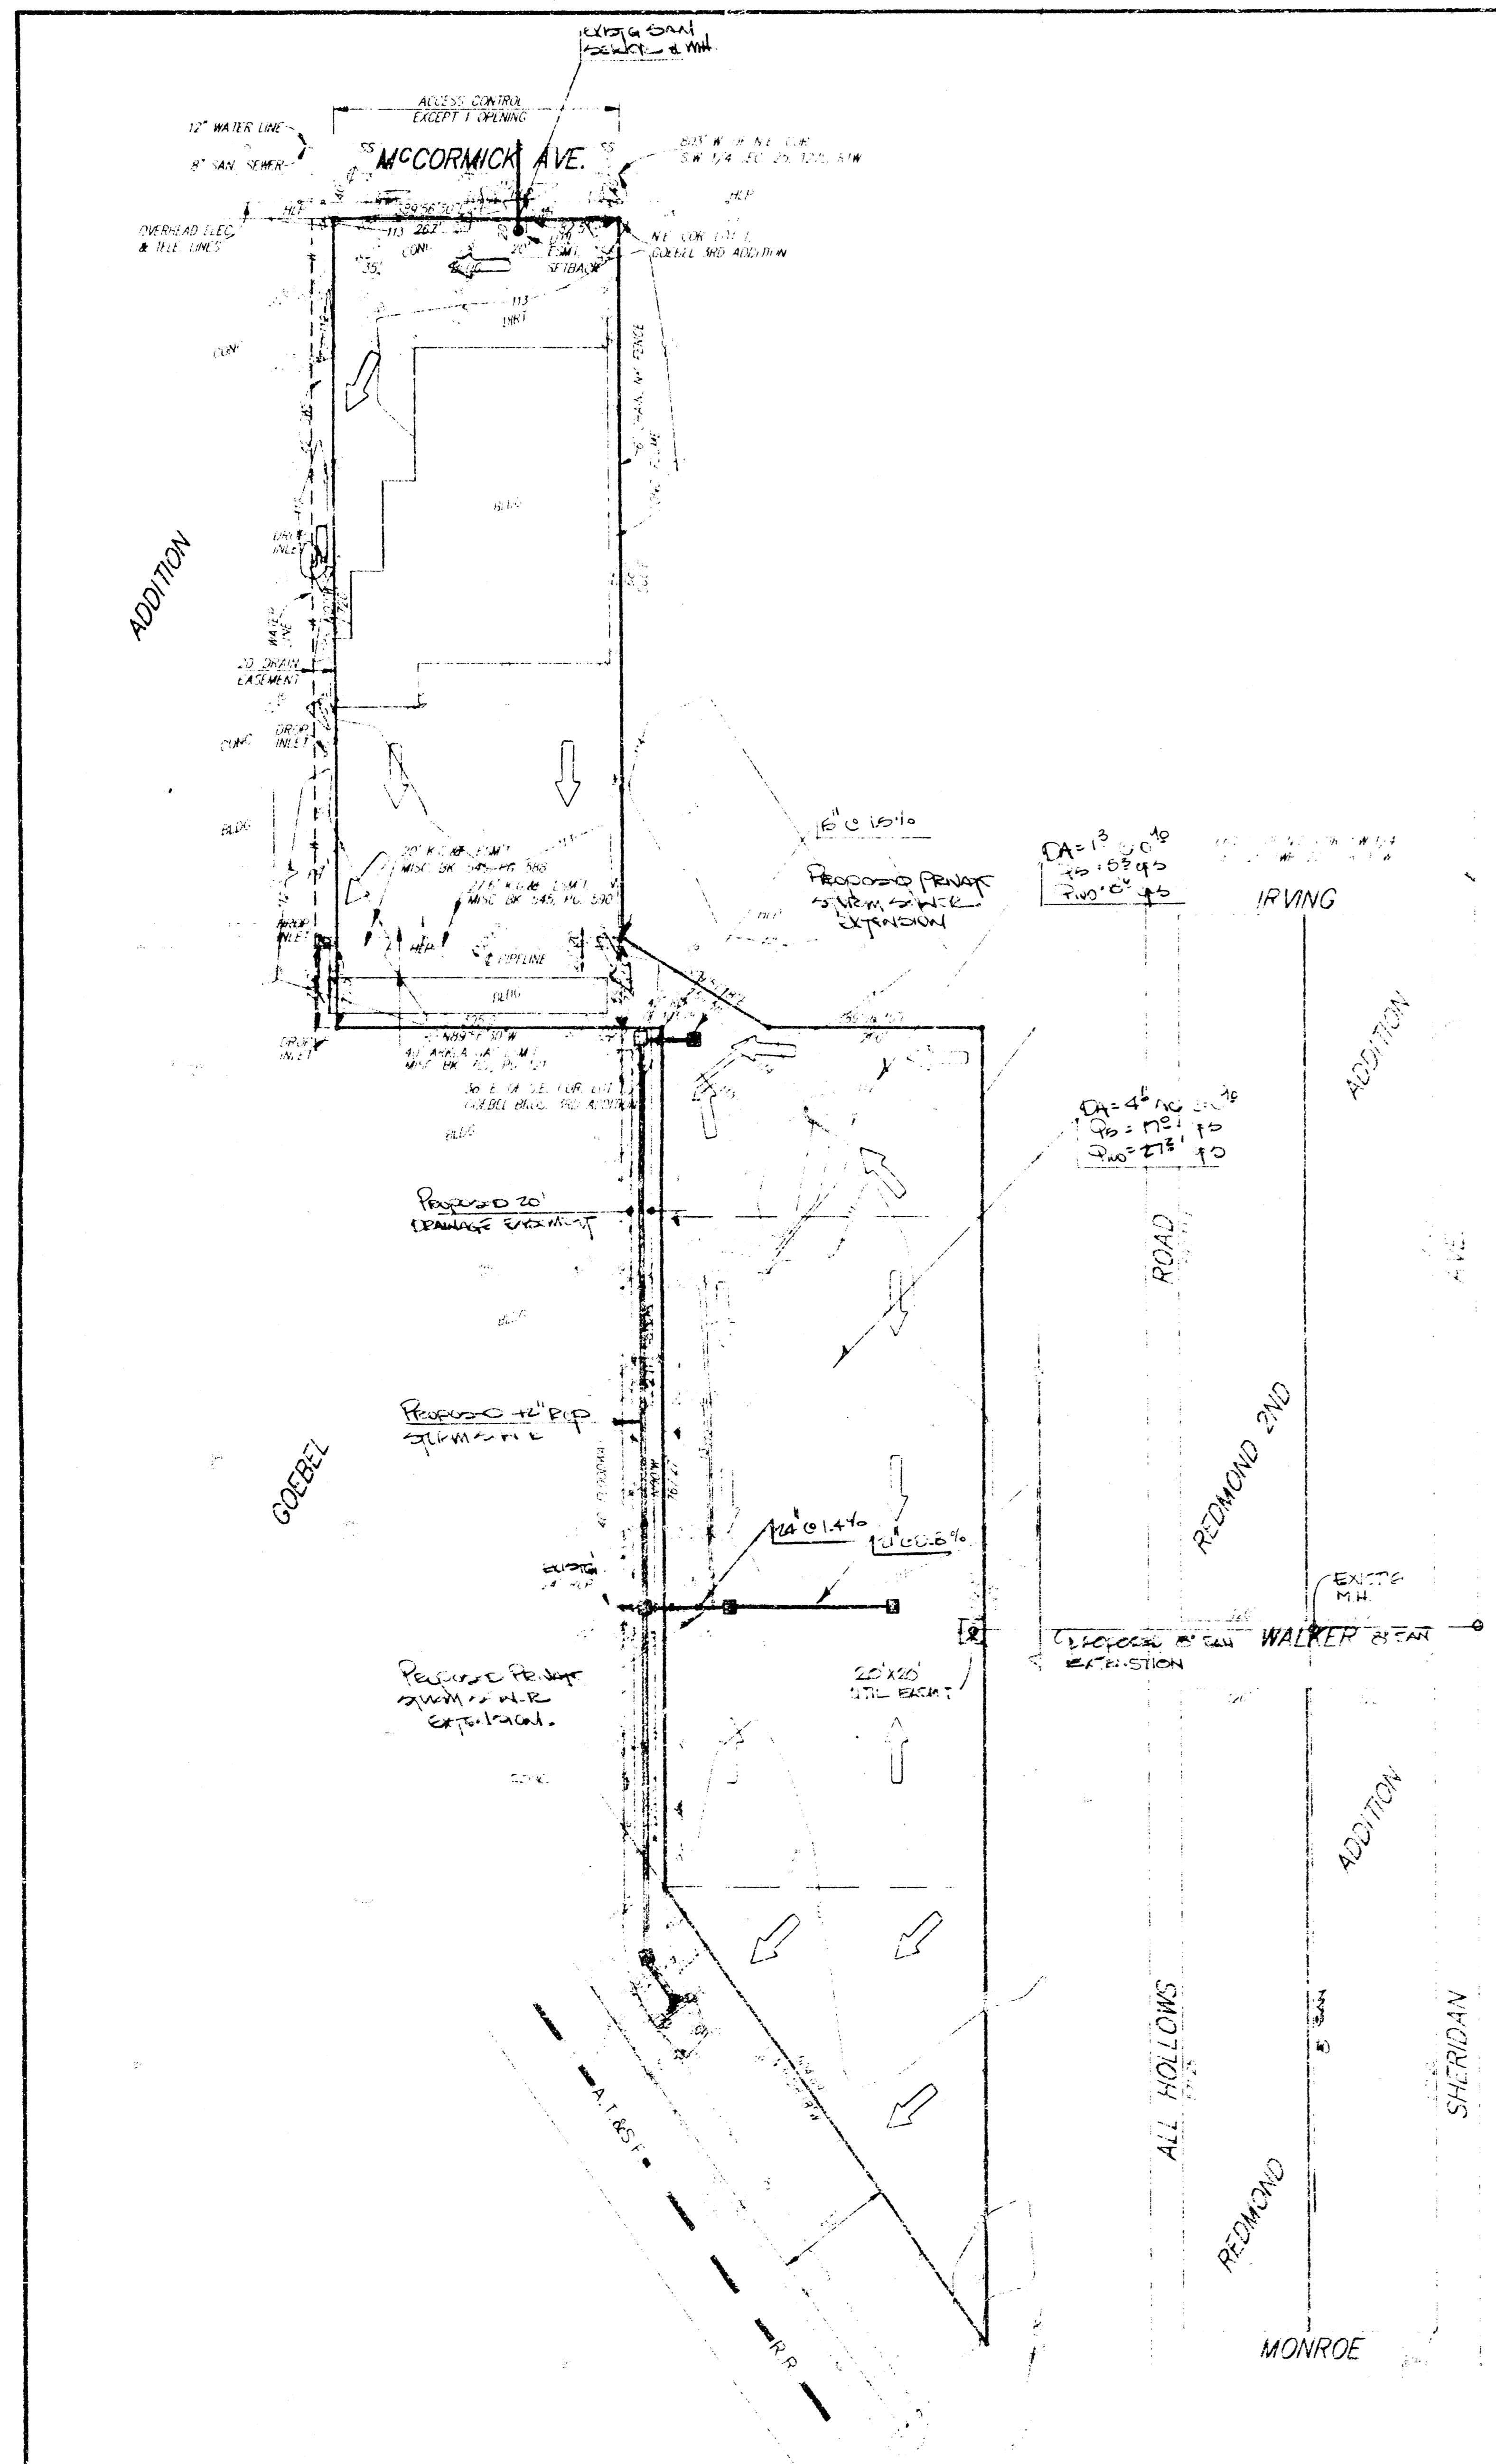


DRAINAGE & UTILITY PLAN