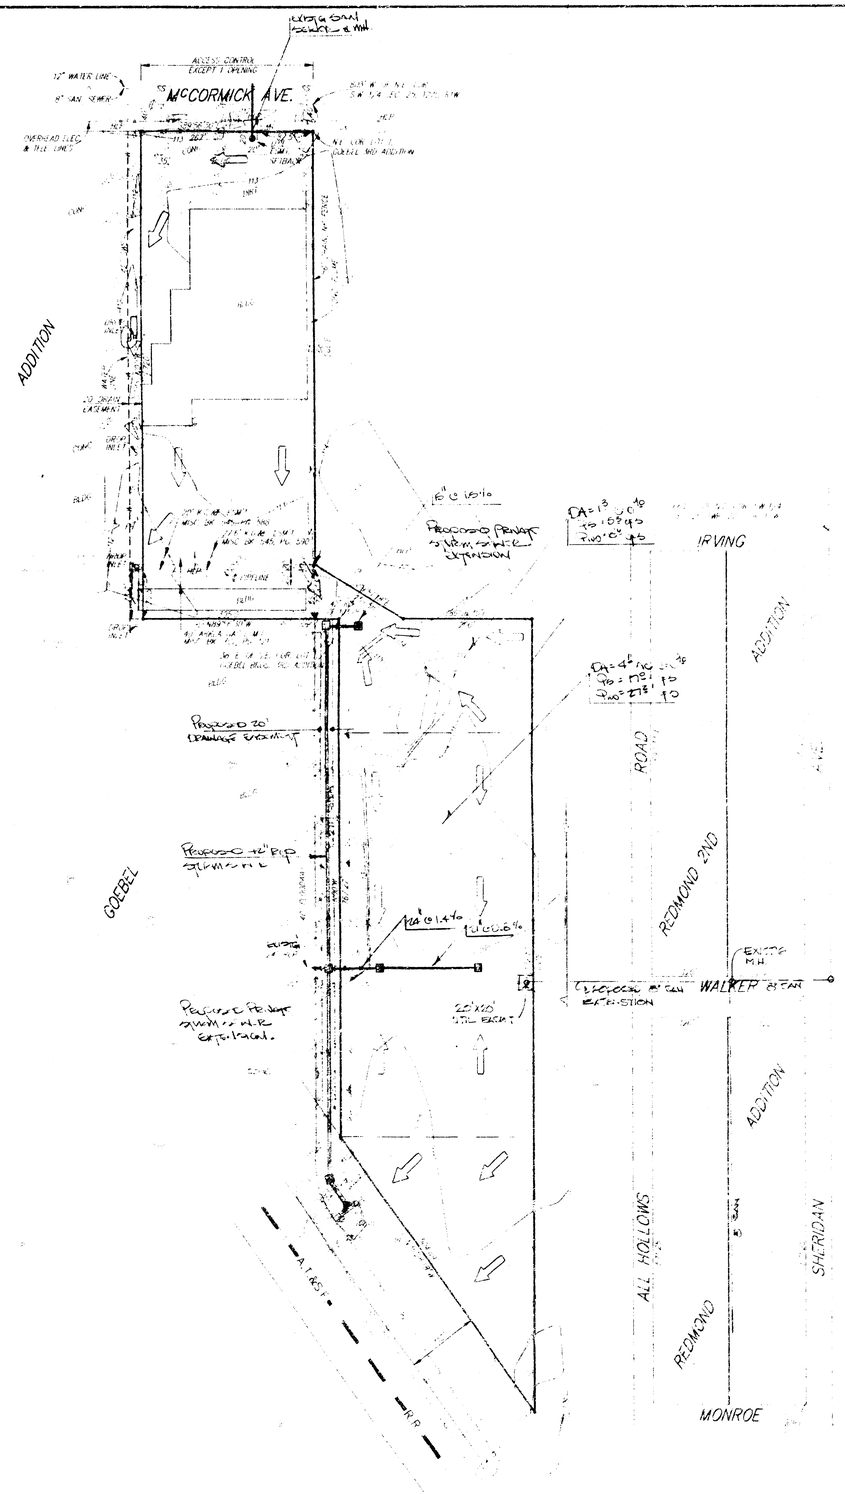


SKETCH PLAT
GOEBEL BROS. 4TH ADDITION

WICHITA, SEDGWICK COUNTY, KANSAS

DRAINAGE & UTILITY PLAN

BAUGHMAN COMPANY P. A.