


0227

471H

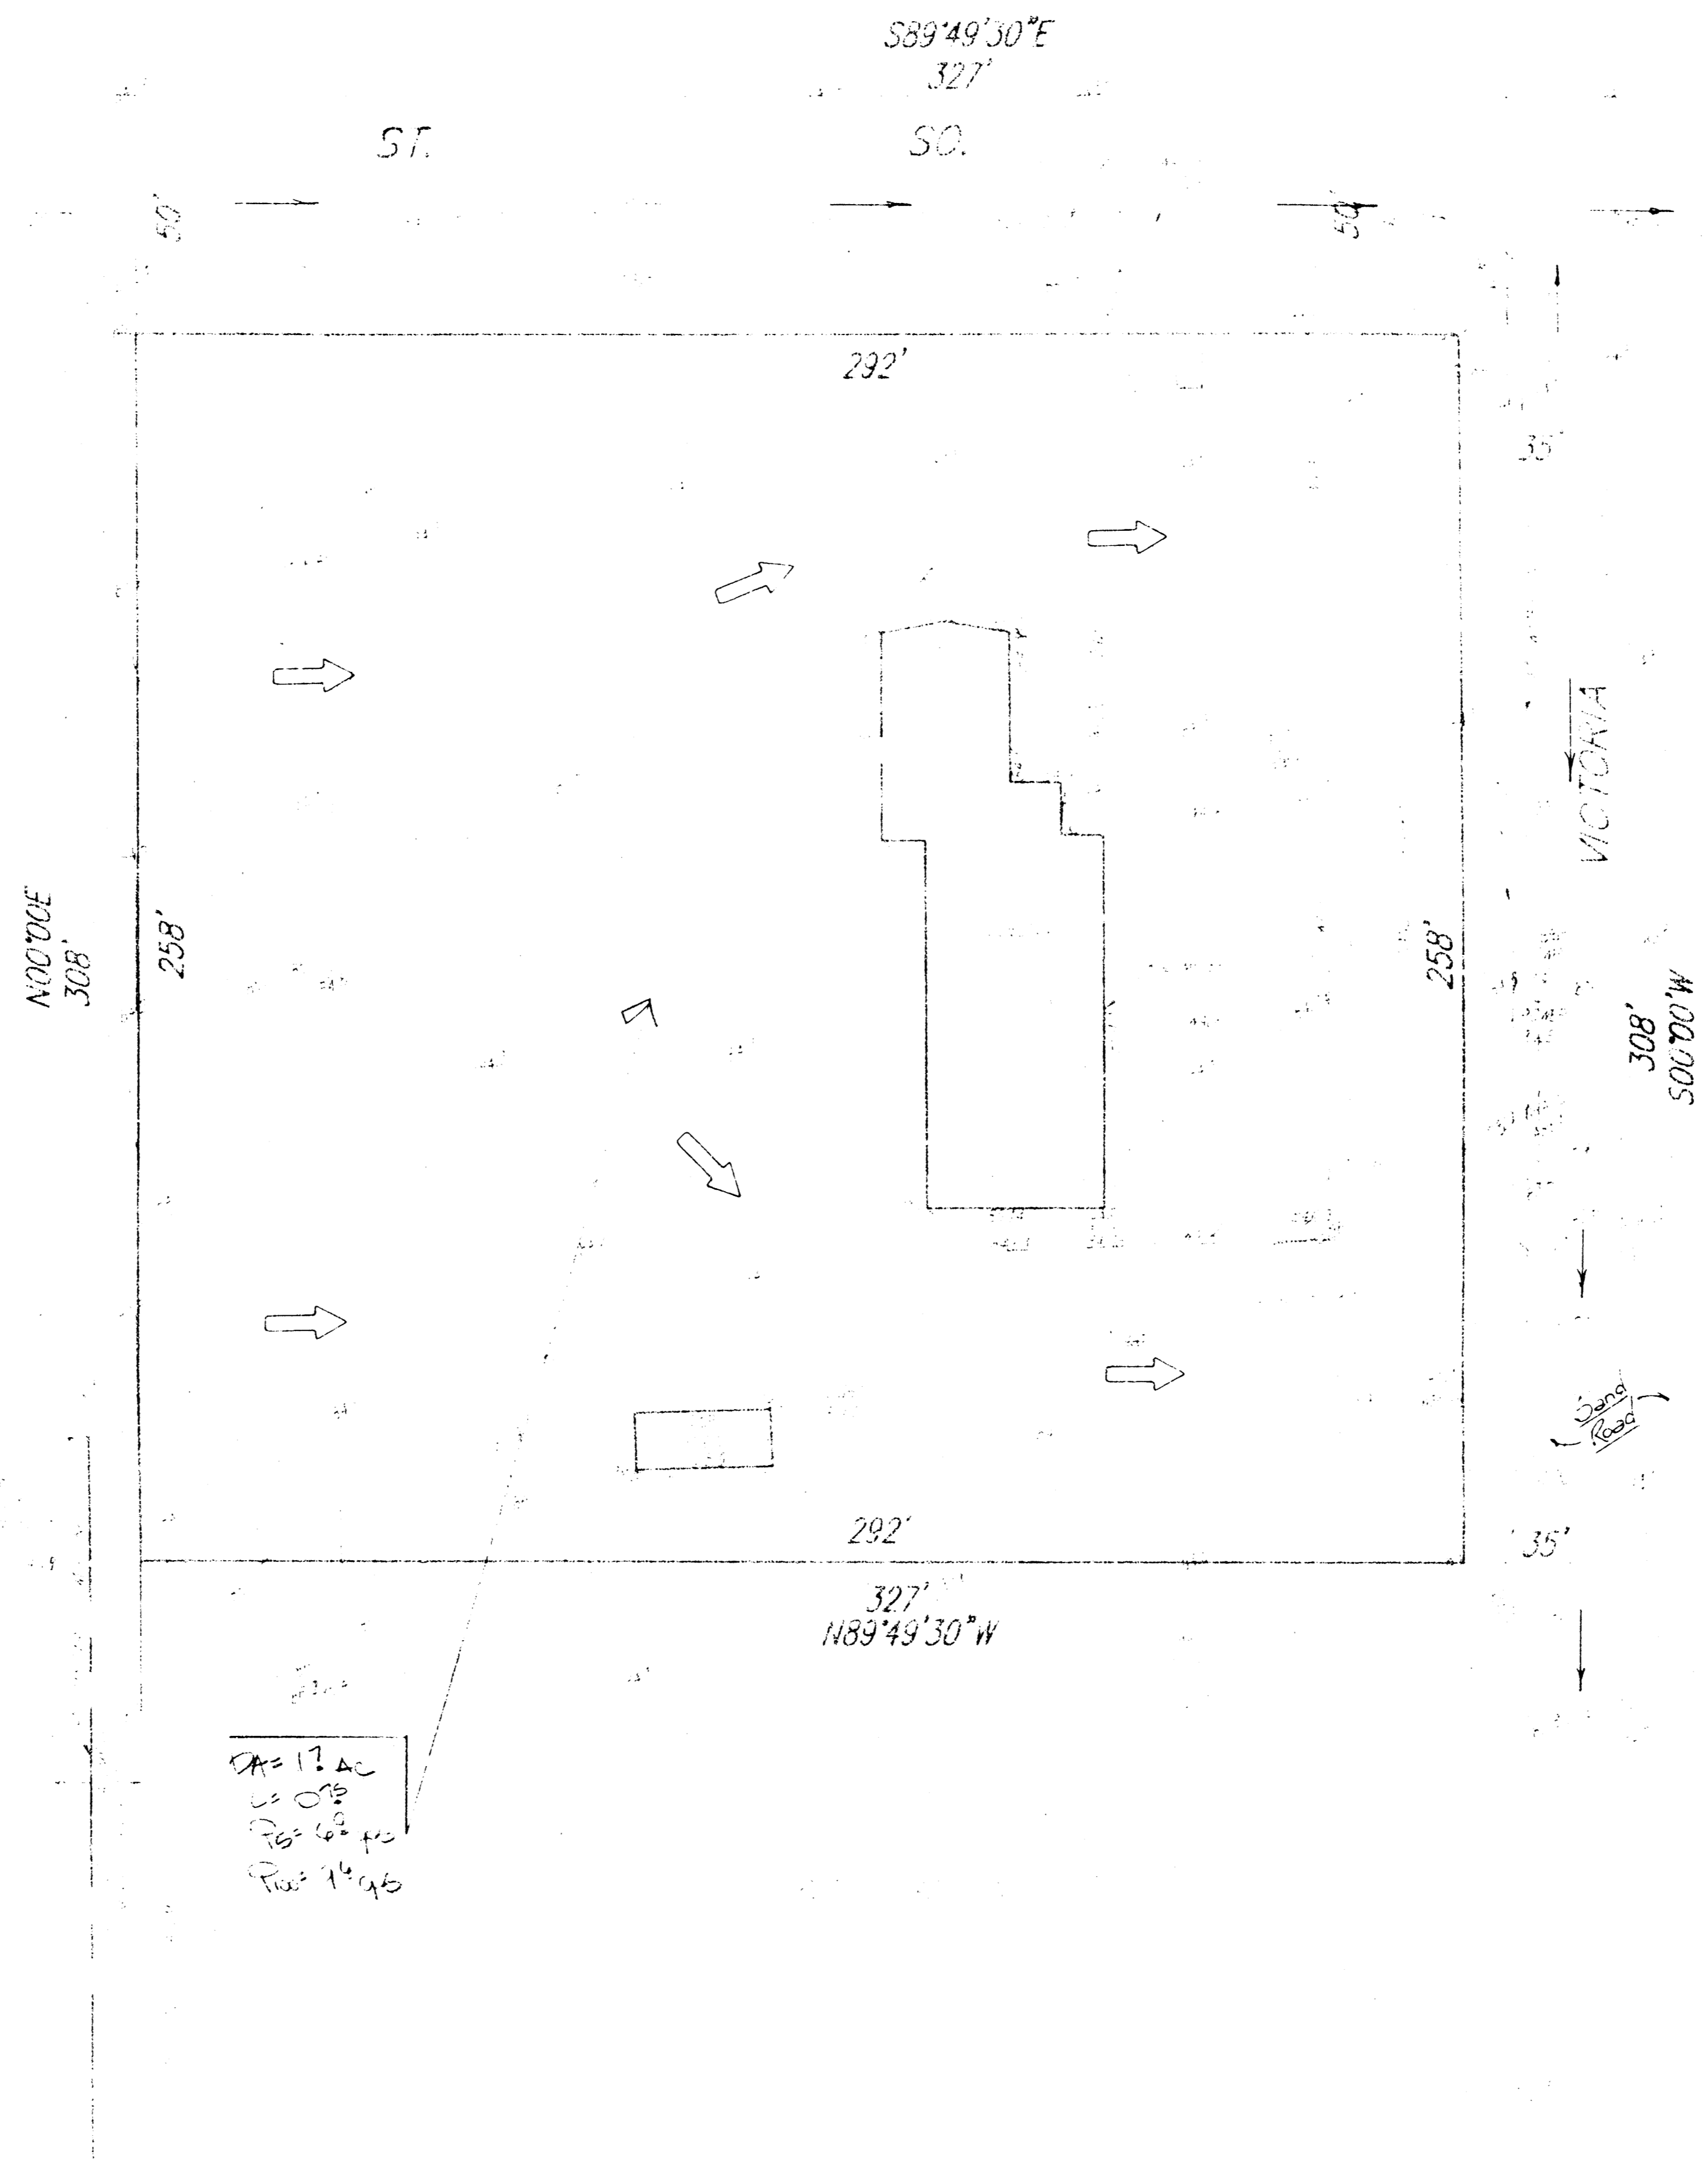


SKETCH PLAT

GOOD SHEPHERD LUTHERAN CHURCH ADDITION

DRAINAGE PLAN

