



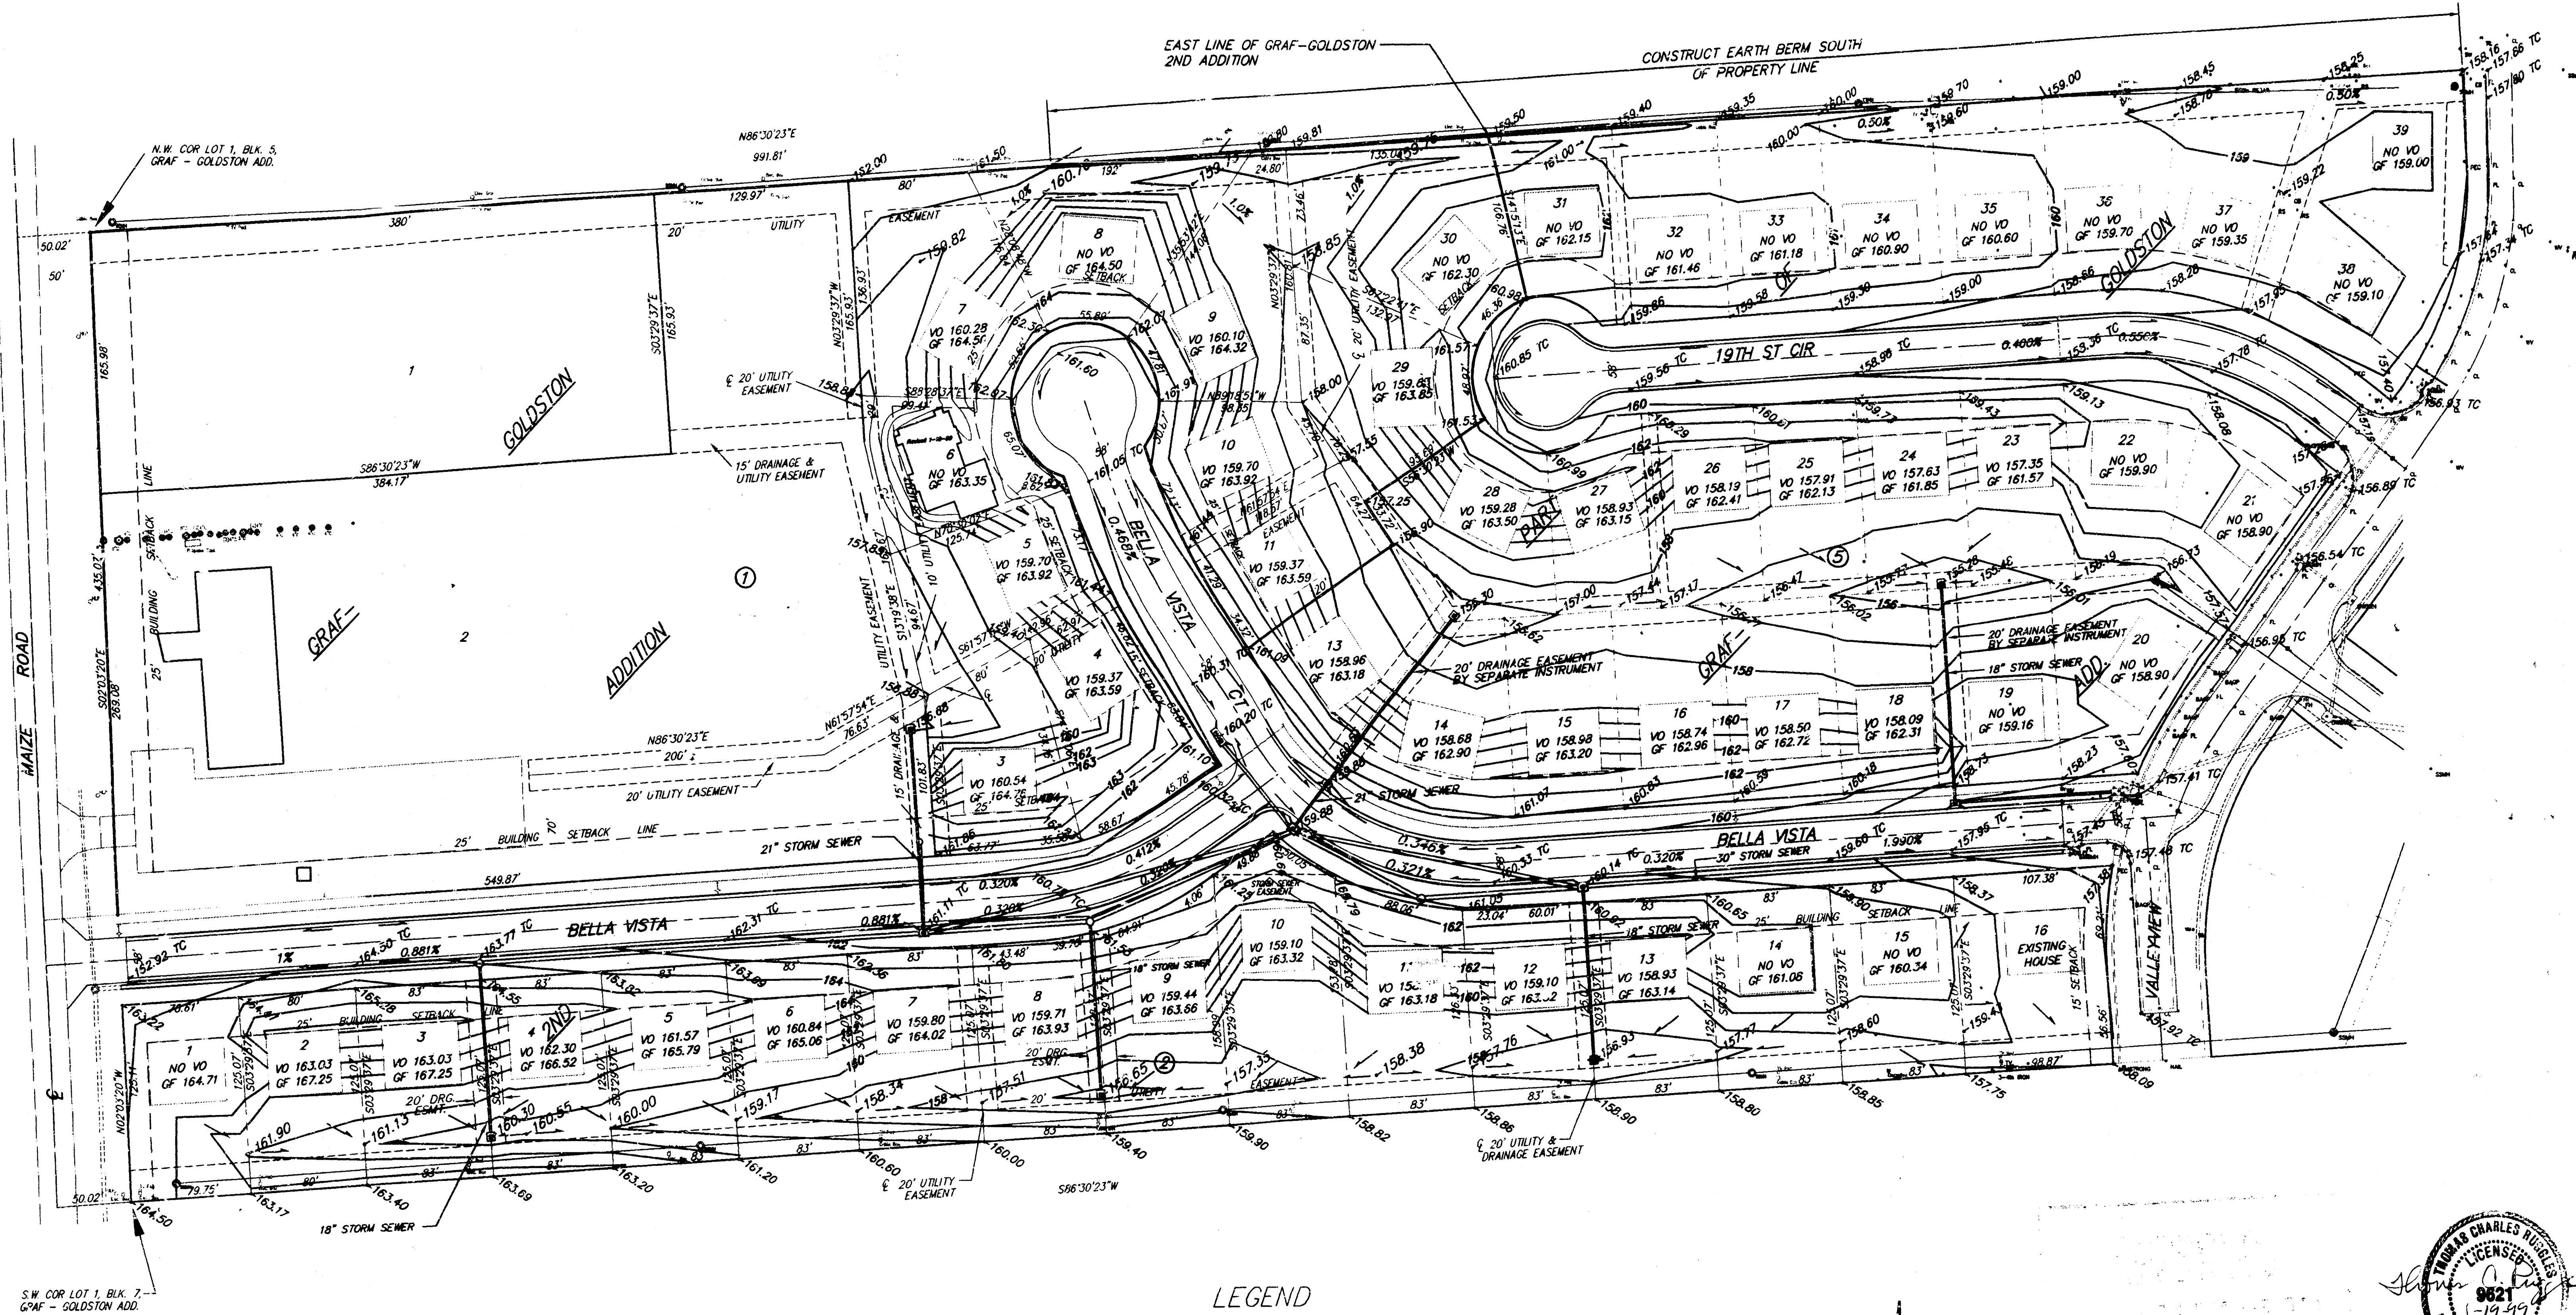


LEGEND

- 162.31 TC PROPOSED TOP OF CURB ELEVATION
- 162.31 PROPOSED GROUND ELEVATION
- 162.31 PROPOSED CONTOUR
- EXISTING GROUND ELEVATION
- GF 163.18 PROPOSED GARAGE FLOOR ELEVATION
- VO 158.96 PROPOSED VIEW OUT ELEVATION

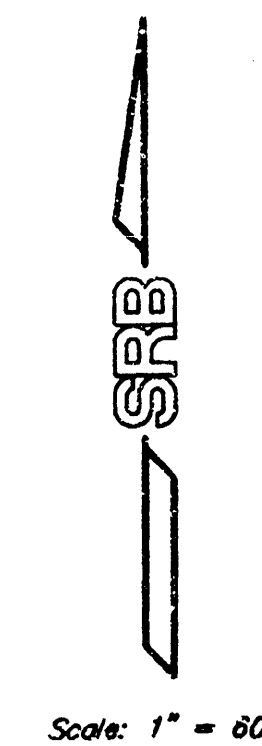

Scale: 1" = 80'

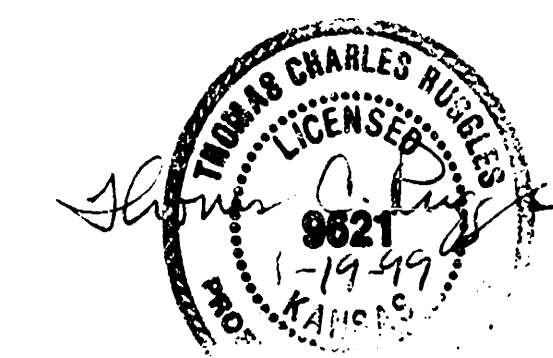

Revised 19 JAN 1999

REVISED LOT GRADING PLAN FOR GRAF-GOLDSTON 2ND ADDITION AND PART OF BLOCK 5, GRAF-GOLDSTON ADDITION

SRB 924 NORTH MAIN WICHITA, KANSAS 67203 316-264-8008 FAX 264-4621		REVISION 1-19-99
SAVOY, RUGGLES & BOHM, P.A. ENGINEERING & SURVEYING		
PROJECT NUMBER		
DRAWN DKD/KWL	DESIGN T.C.R.	REVIEW T.C.R.
DATE Mar. 1, 1996	UTILITY T.C.R.	SRB JOB 139E