



HADIJSKI ADDITION  
(Drainage)

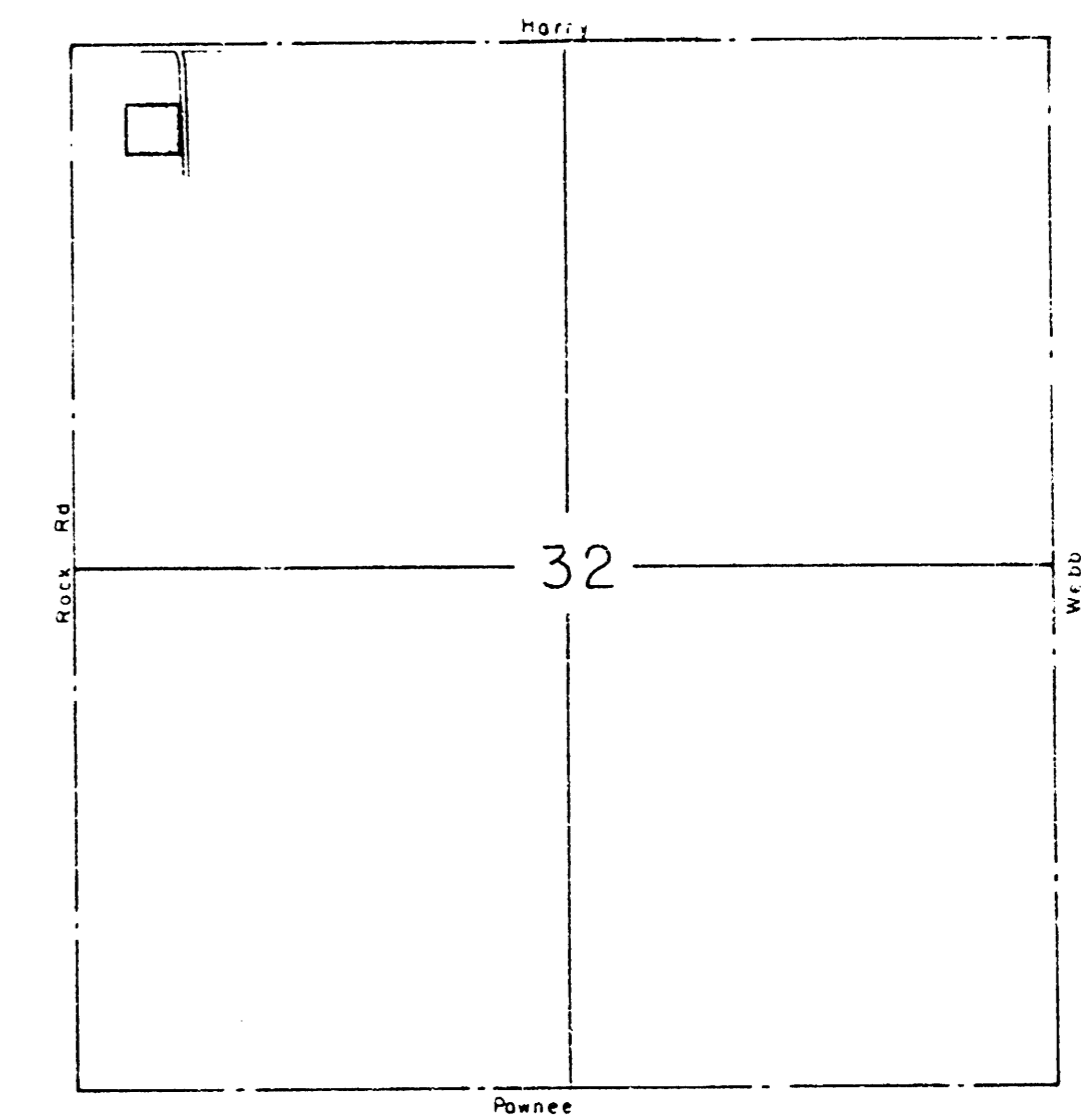

VICINITY MAP  
1" = 1000'

DRAINAGE PLAN  
SKETCH PLAT  
HADIJSKI ADDITION  
LOT 2, BLOCK 1,  
CEDAR LAKES VILLAGE  
THIRD ADDITION

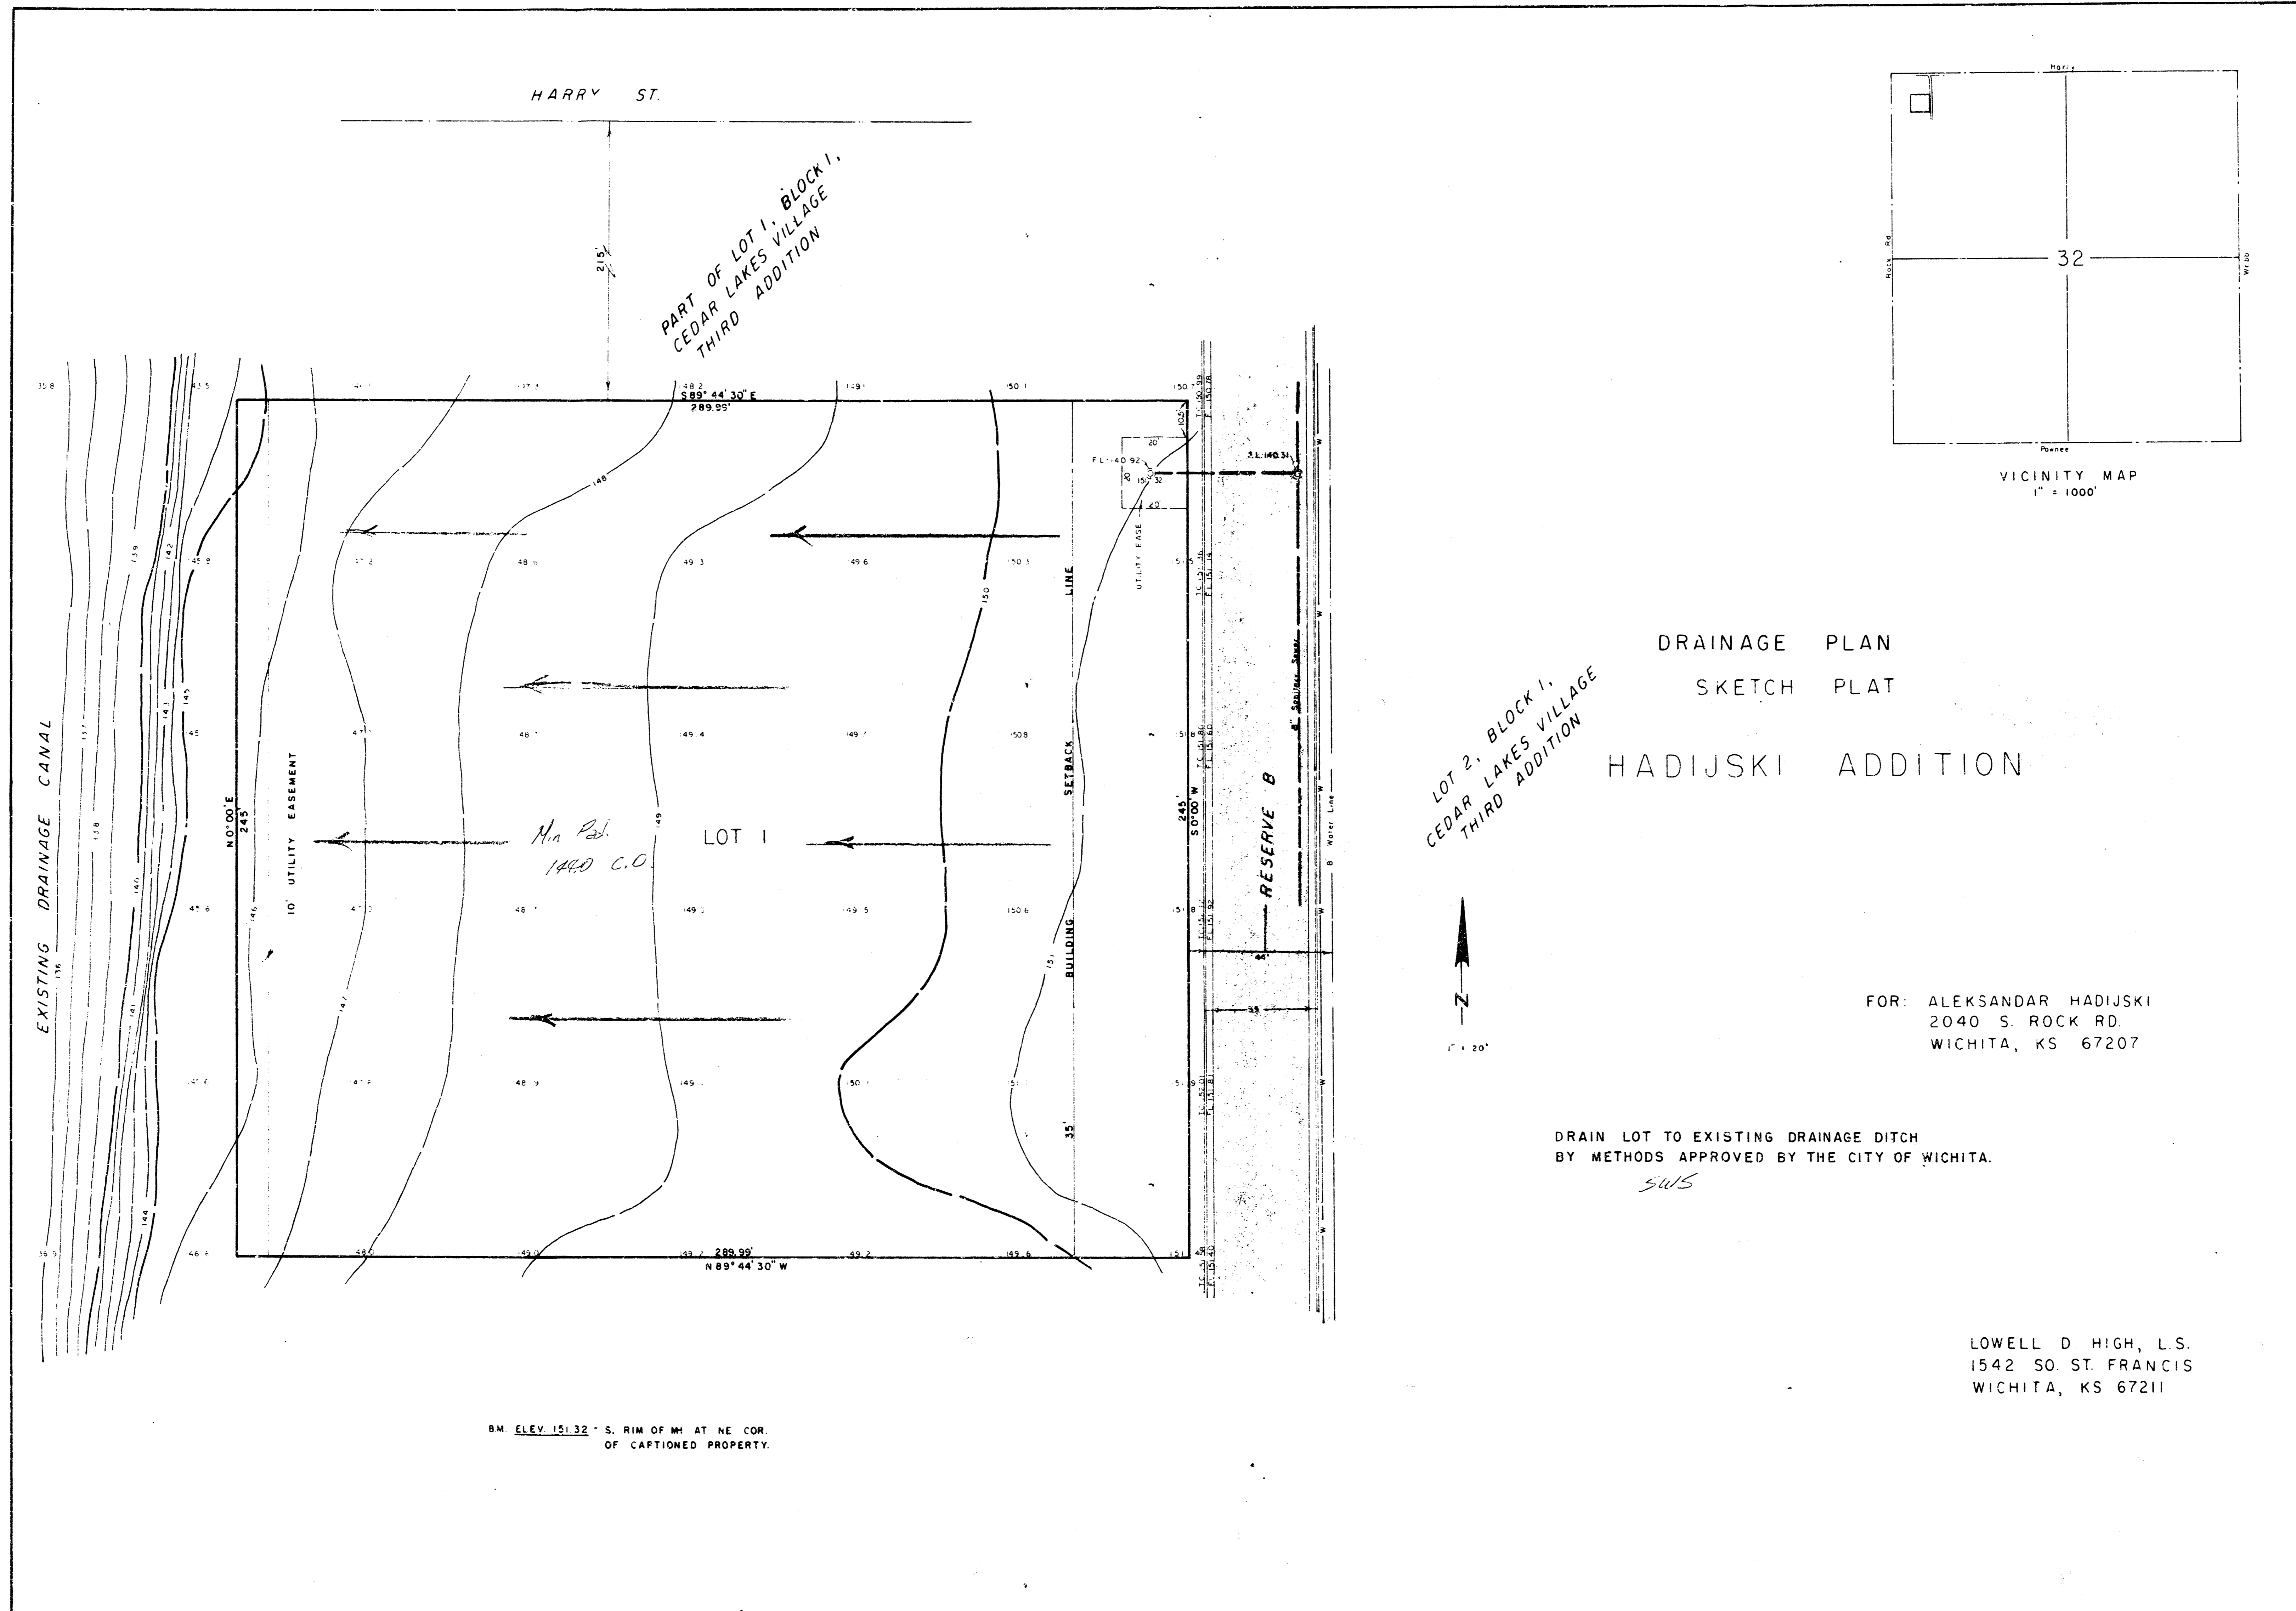

FOR: ALEKSANDAR HADIJSKI  
2040 S. ROCK RD.  
WICHITA, KS 67207

DRAIN LOT TO EXISTING DRAINAGE DITCH  
BY METHODS APPROVED BY THE CITY OF WICHITA.  
*SWS*

LOWELL D HIGH, L.S.  
1542 SO. ST. FRANCIS  
WICHITA, KS 67211

BM ELEV 151.32 - S. RIM OF MH AT NE COR.  
OF CAPTIONED PROPERTY.