


Harlin's

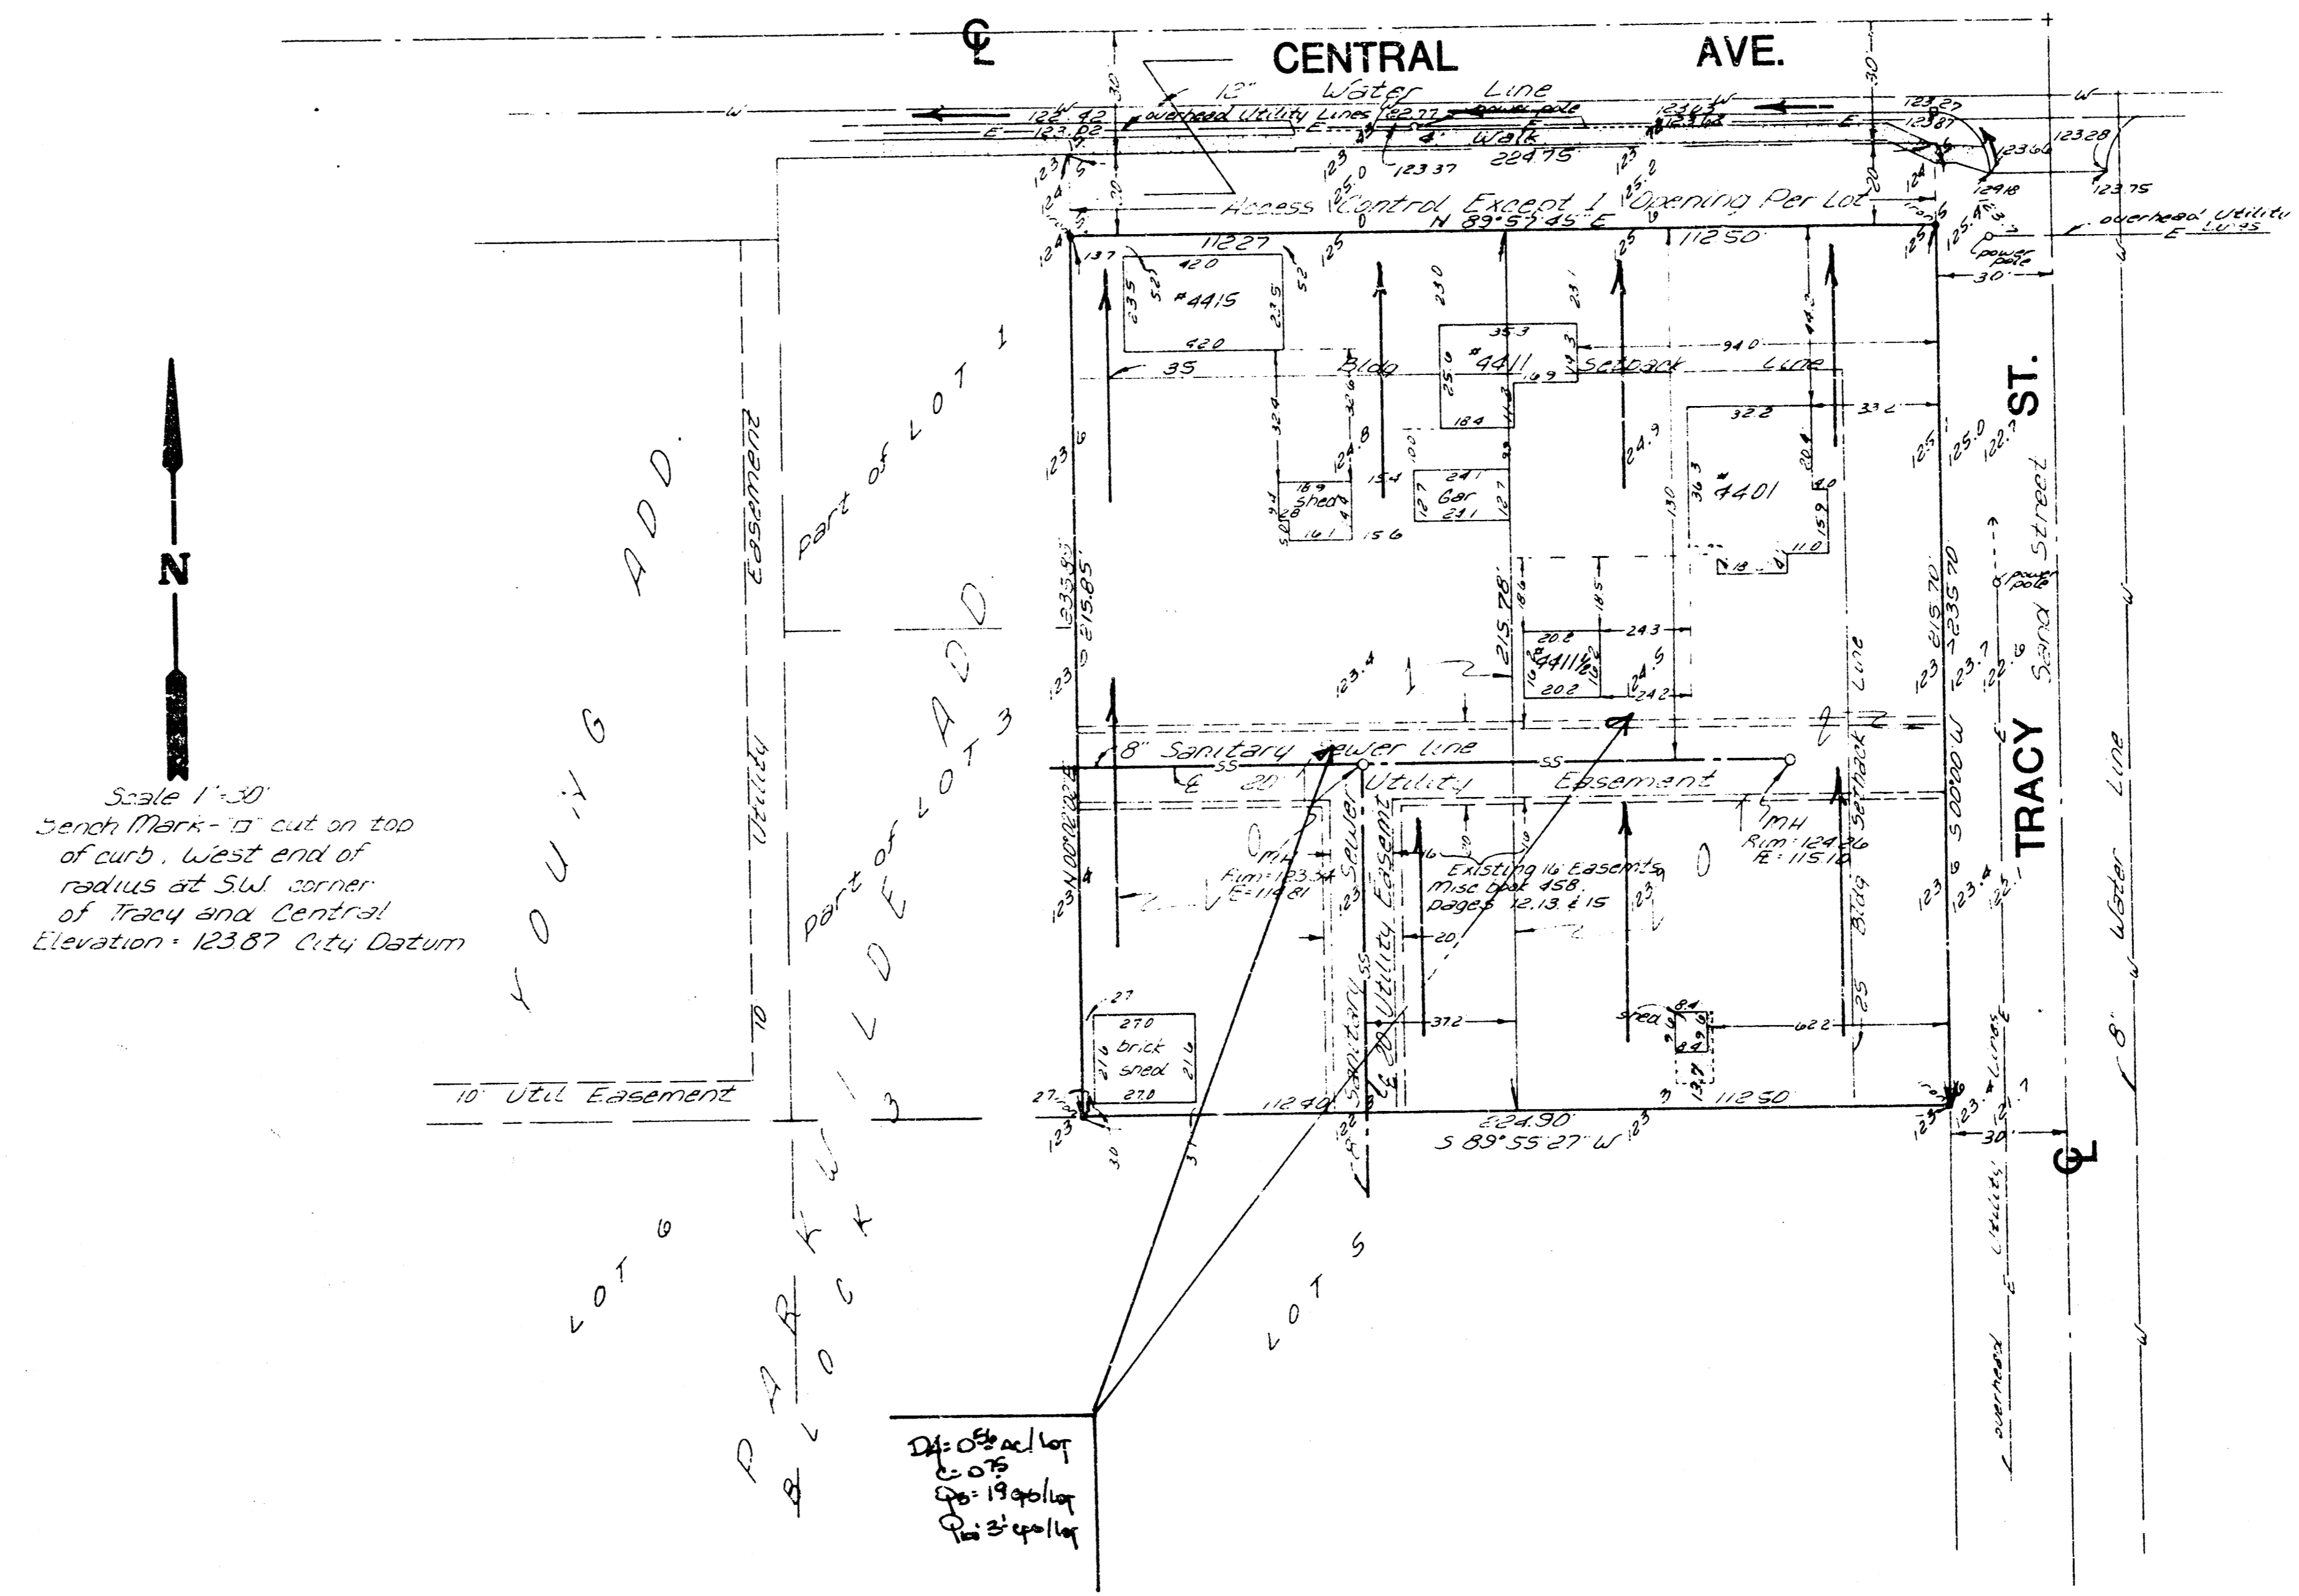

Scale 1"=30'
 Bench Mark - is cut on top
 of curb, West end of
 radius at SW corner
 of Tracy and Central
 Elevation - 123.87 City Datum

SKETCH PLAT

HARLIN'S ADDITION

THE EAST 3/4 OF LOTS 1 & 3, BLOCK 3,
 PARKWILDE ADDITION

OWNER:
 HARLIN & JANET GRAY

DRAINAGE PLAN

BAUGHMAN COMPANY, P.A.
 SURVEYING & ENGINEERING
 315 262-7271 • 315 ELLIS • WICHITA, KANSAS 67211

29 Aug, 1988