

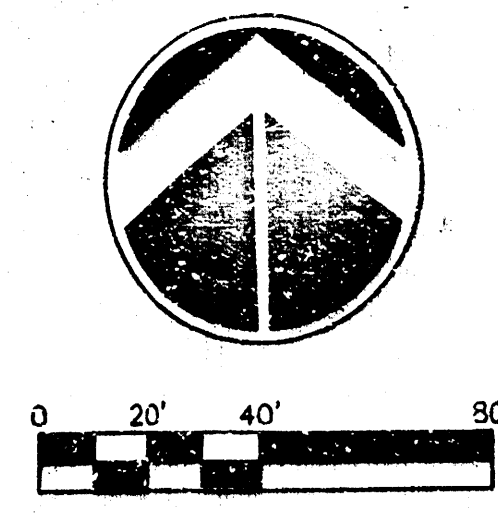
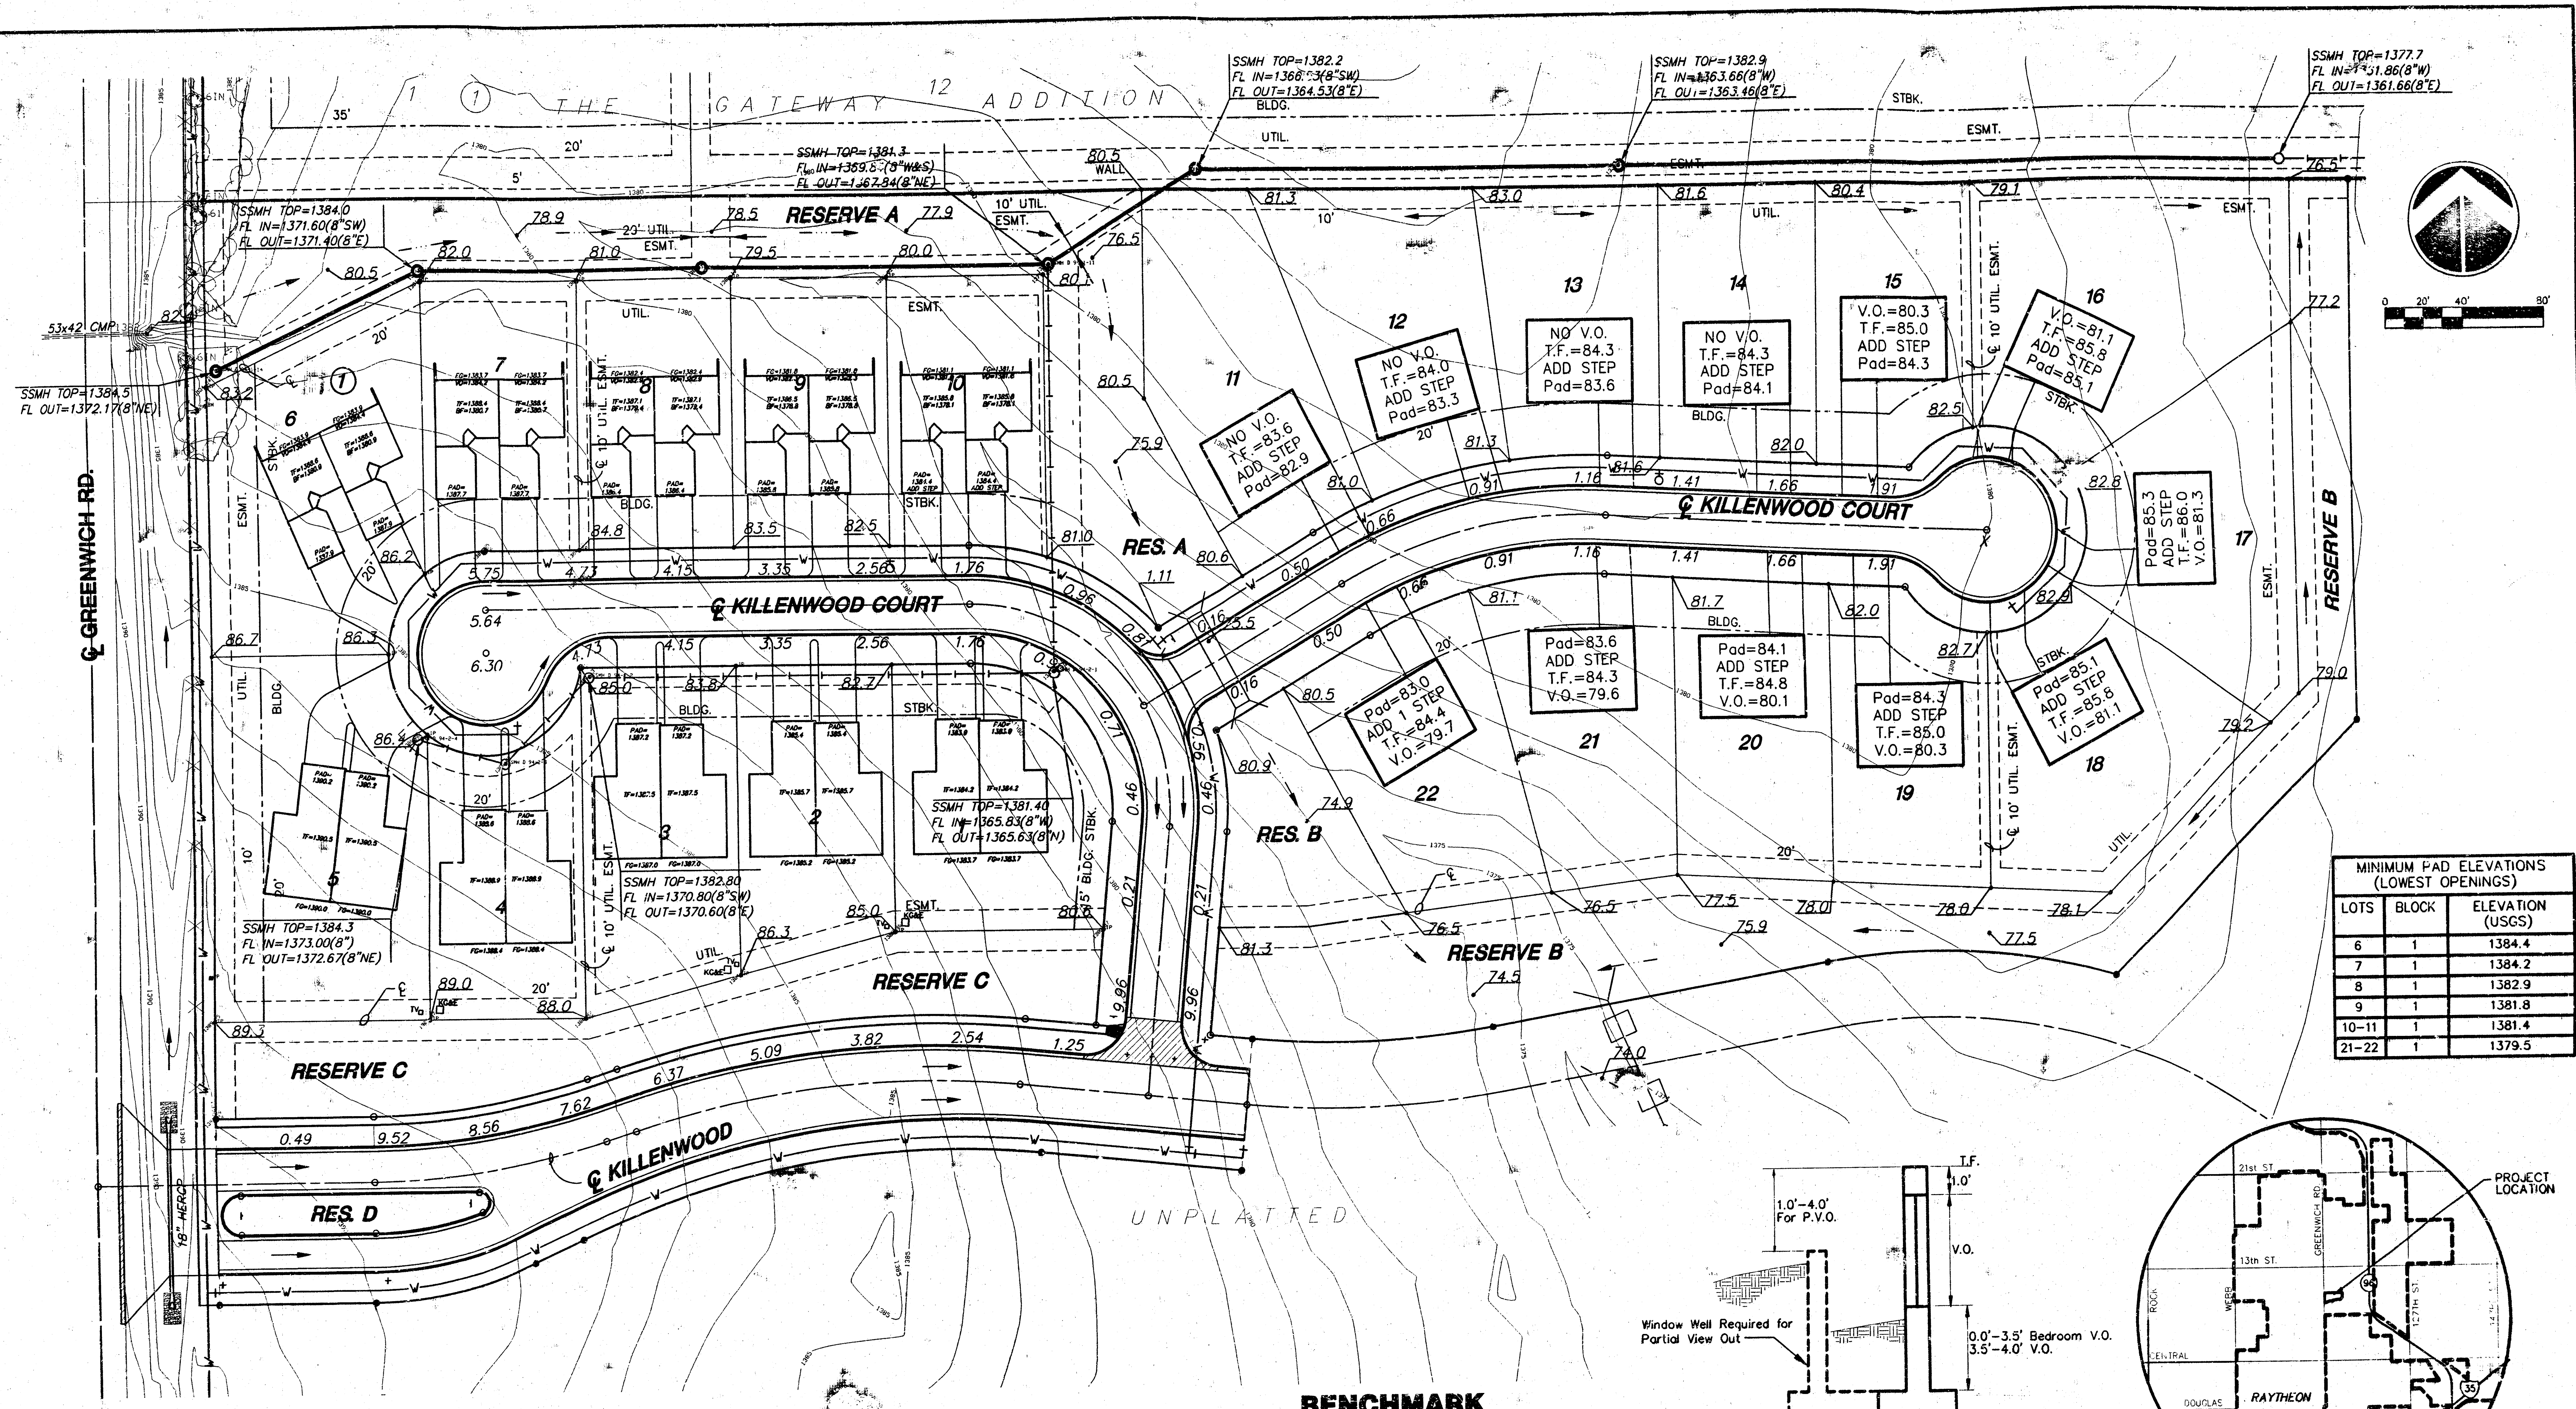


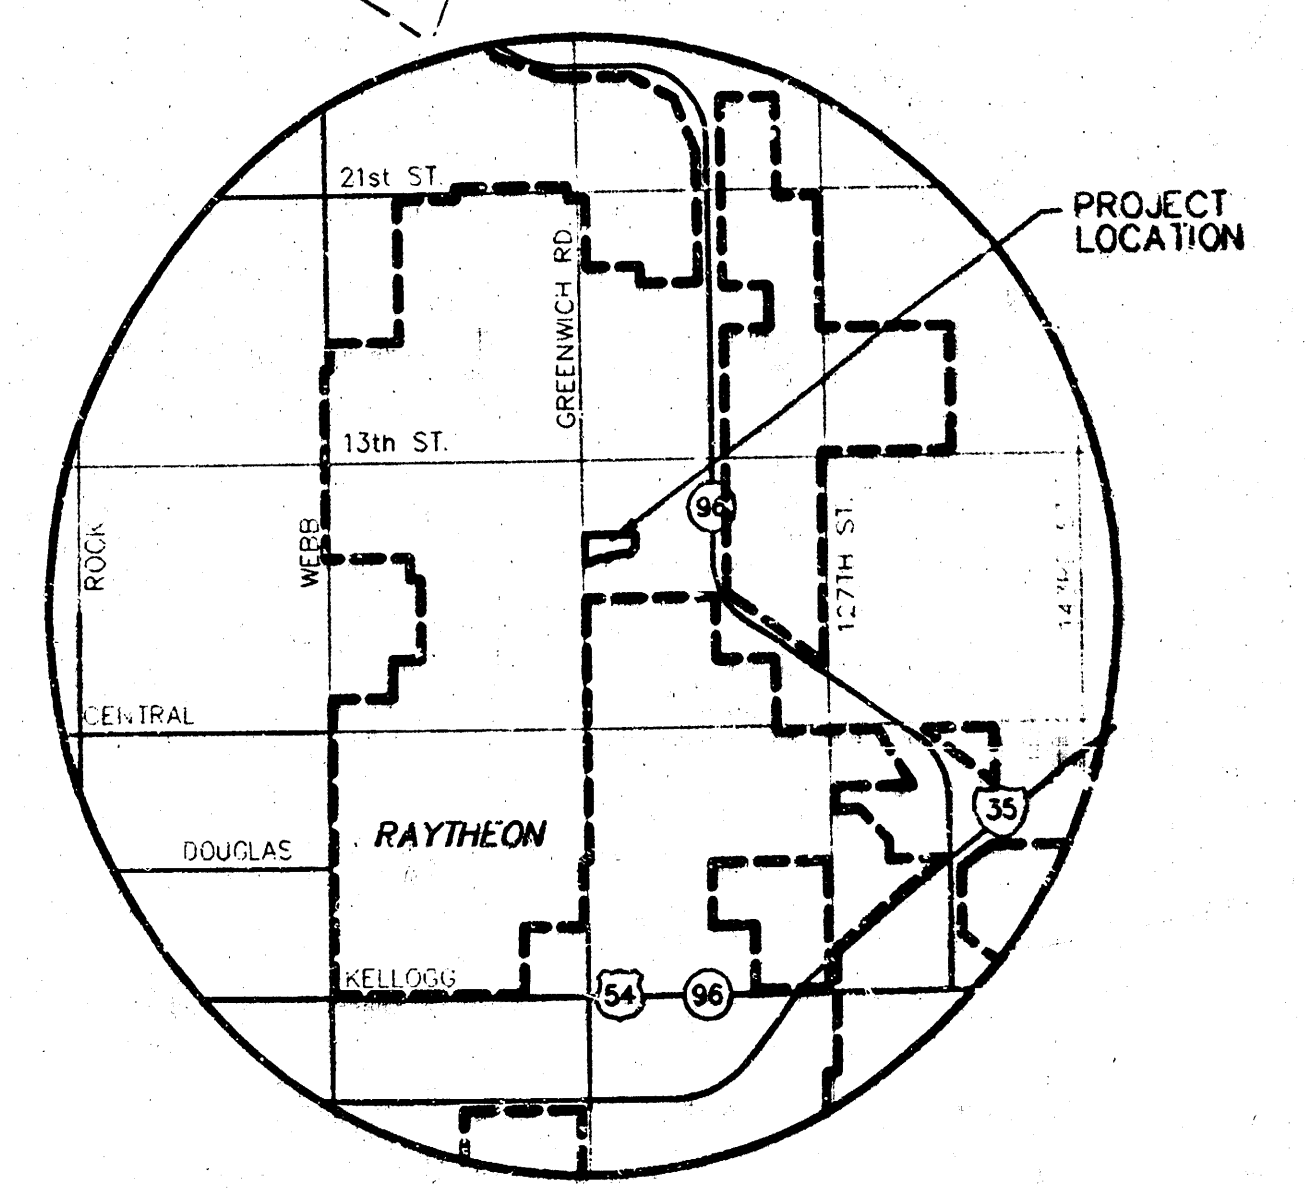

LOTS	BLOCK	ELEVATION (USGS)
6	1	1384.4
7	1	1384.2
8	1	1382.9
9	1	1381.8
10-11	1	1381.4
21-22	1	1379.5

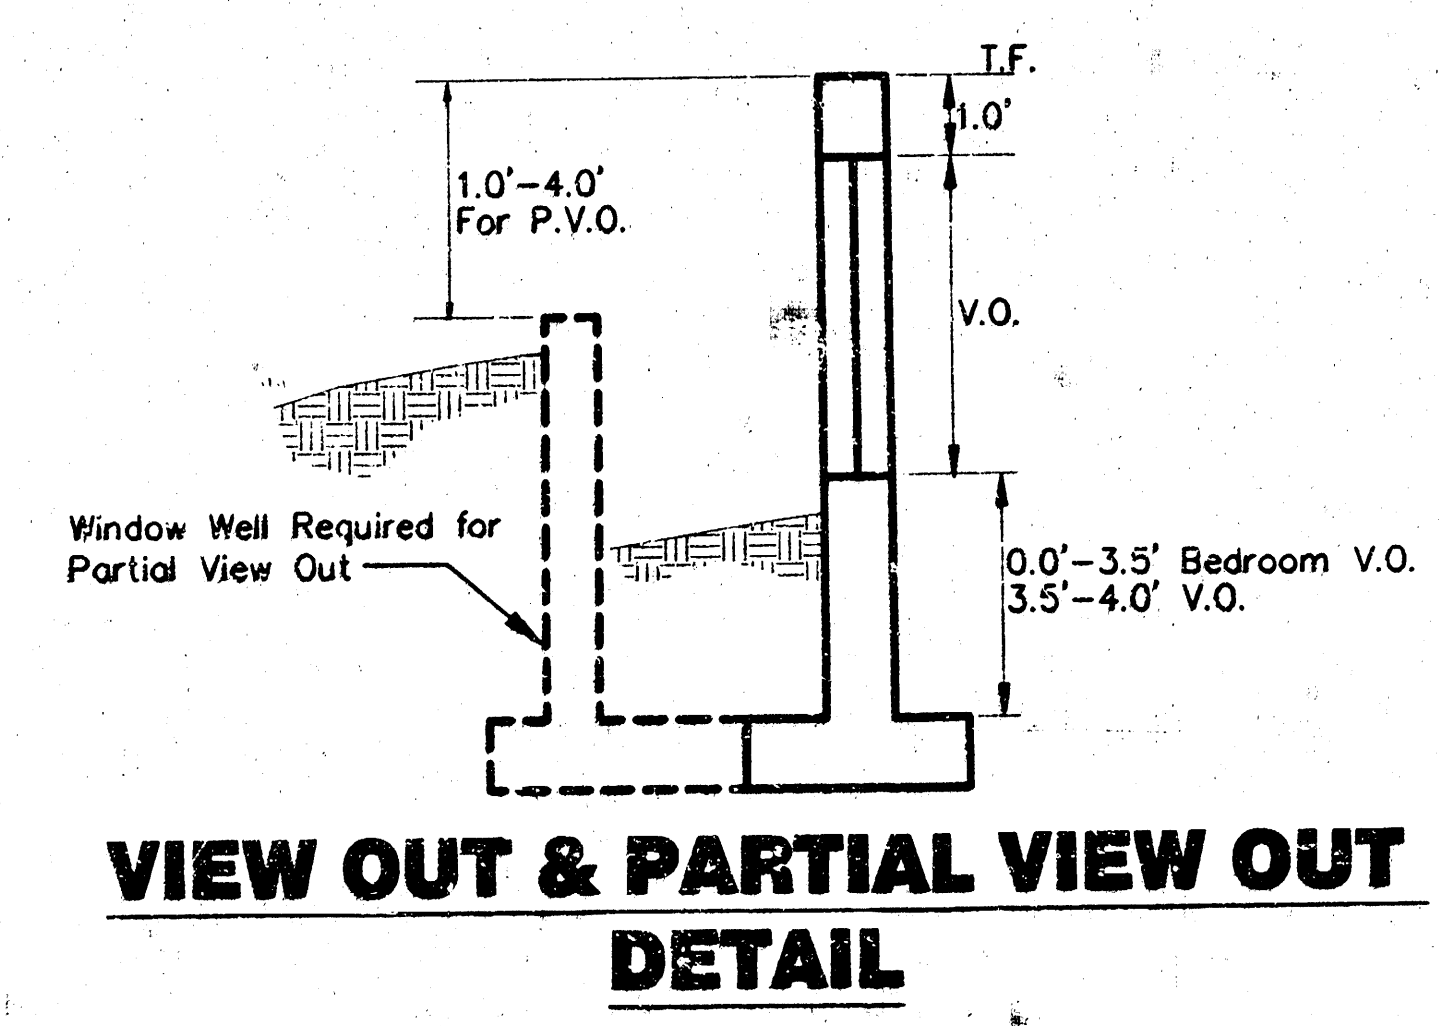


BENCHMARK
 BM#1 T POST 826.63' NORTH 1/4 COR.
 1.45' WEST FENCE LINE.
 ELEV. = 1389.80

GRADING PLAN KILLENWOOD POINTE ADDITION

REVISED: DECEMBER 2001 (LOTS 1-10)
 DATE: AUGUST 2000

OWNERS/DEVELOPER: KISER GATEWAY, LLC & WILLARD J. KISER PROPERTIES, LLC.

**APPROVED
DRAINAGE PLAN**

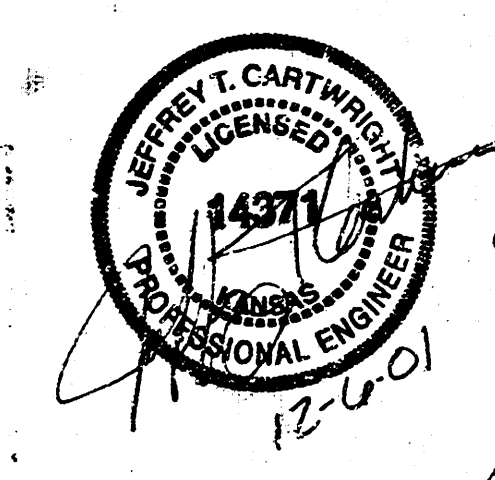

**MKEC
ENGINEERING
CONSULTANTS, INC.**
 411 N. WEBB ROAD
 WICHITA, KS. 67206
 316-684-9600

KILLENWOOD POINTE