


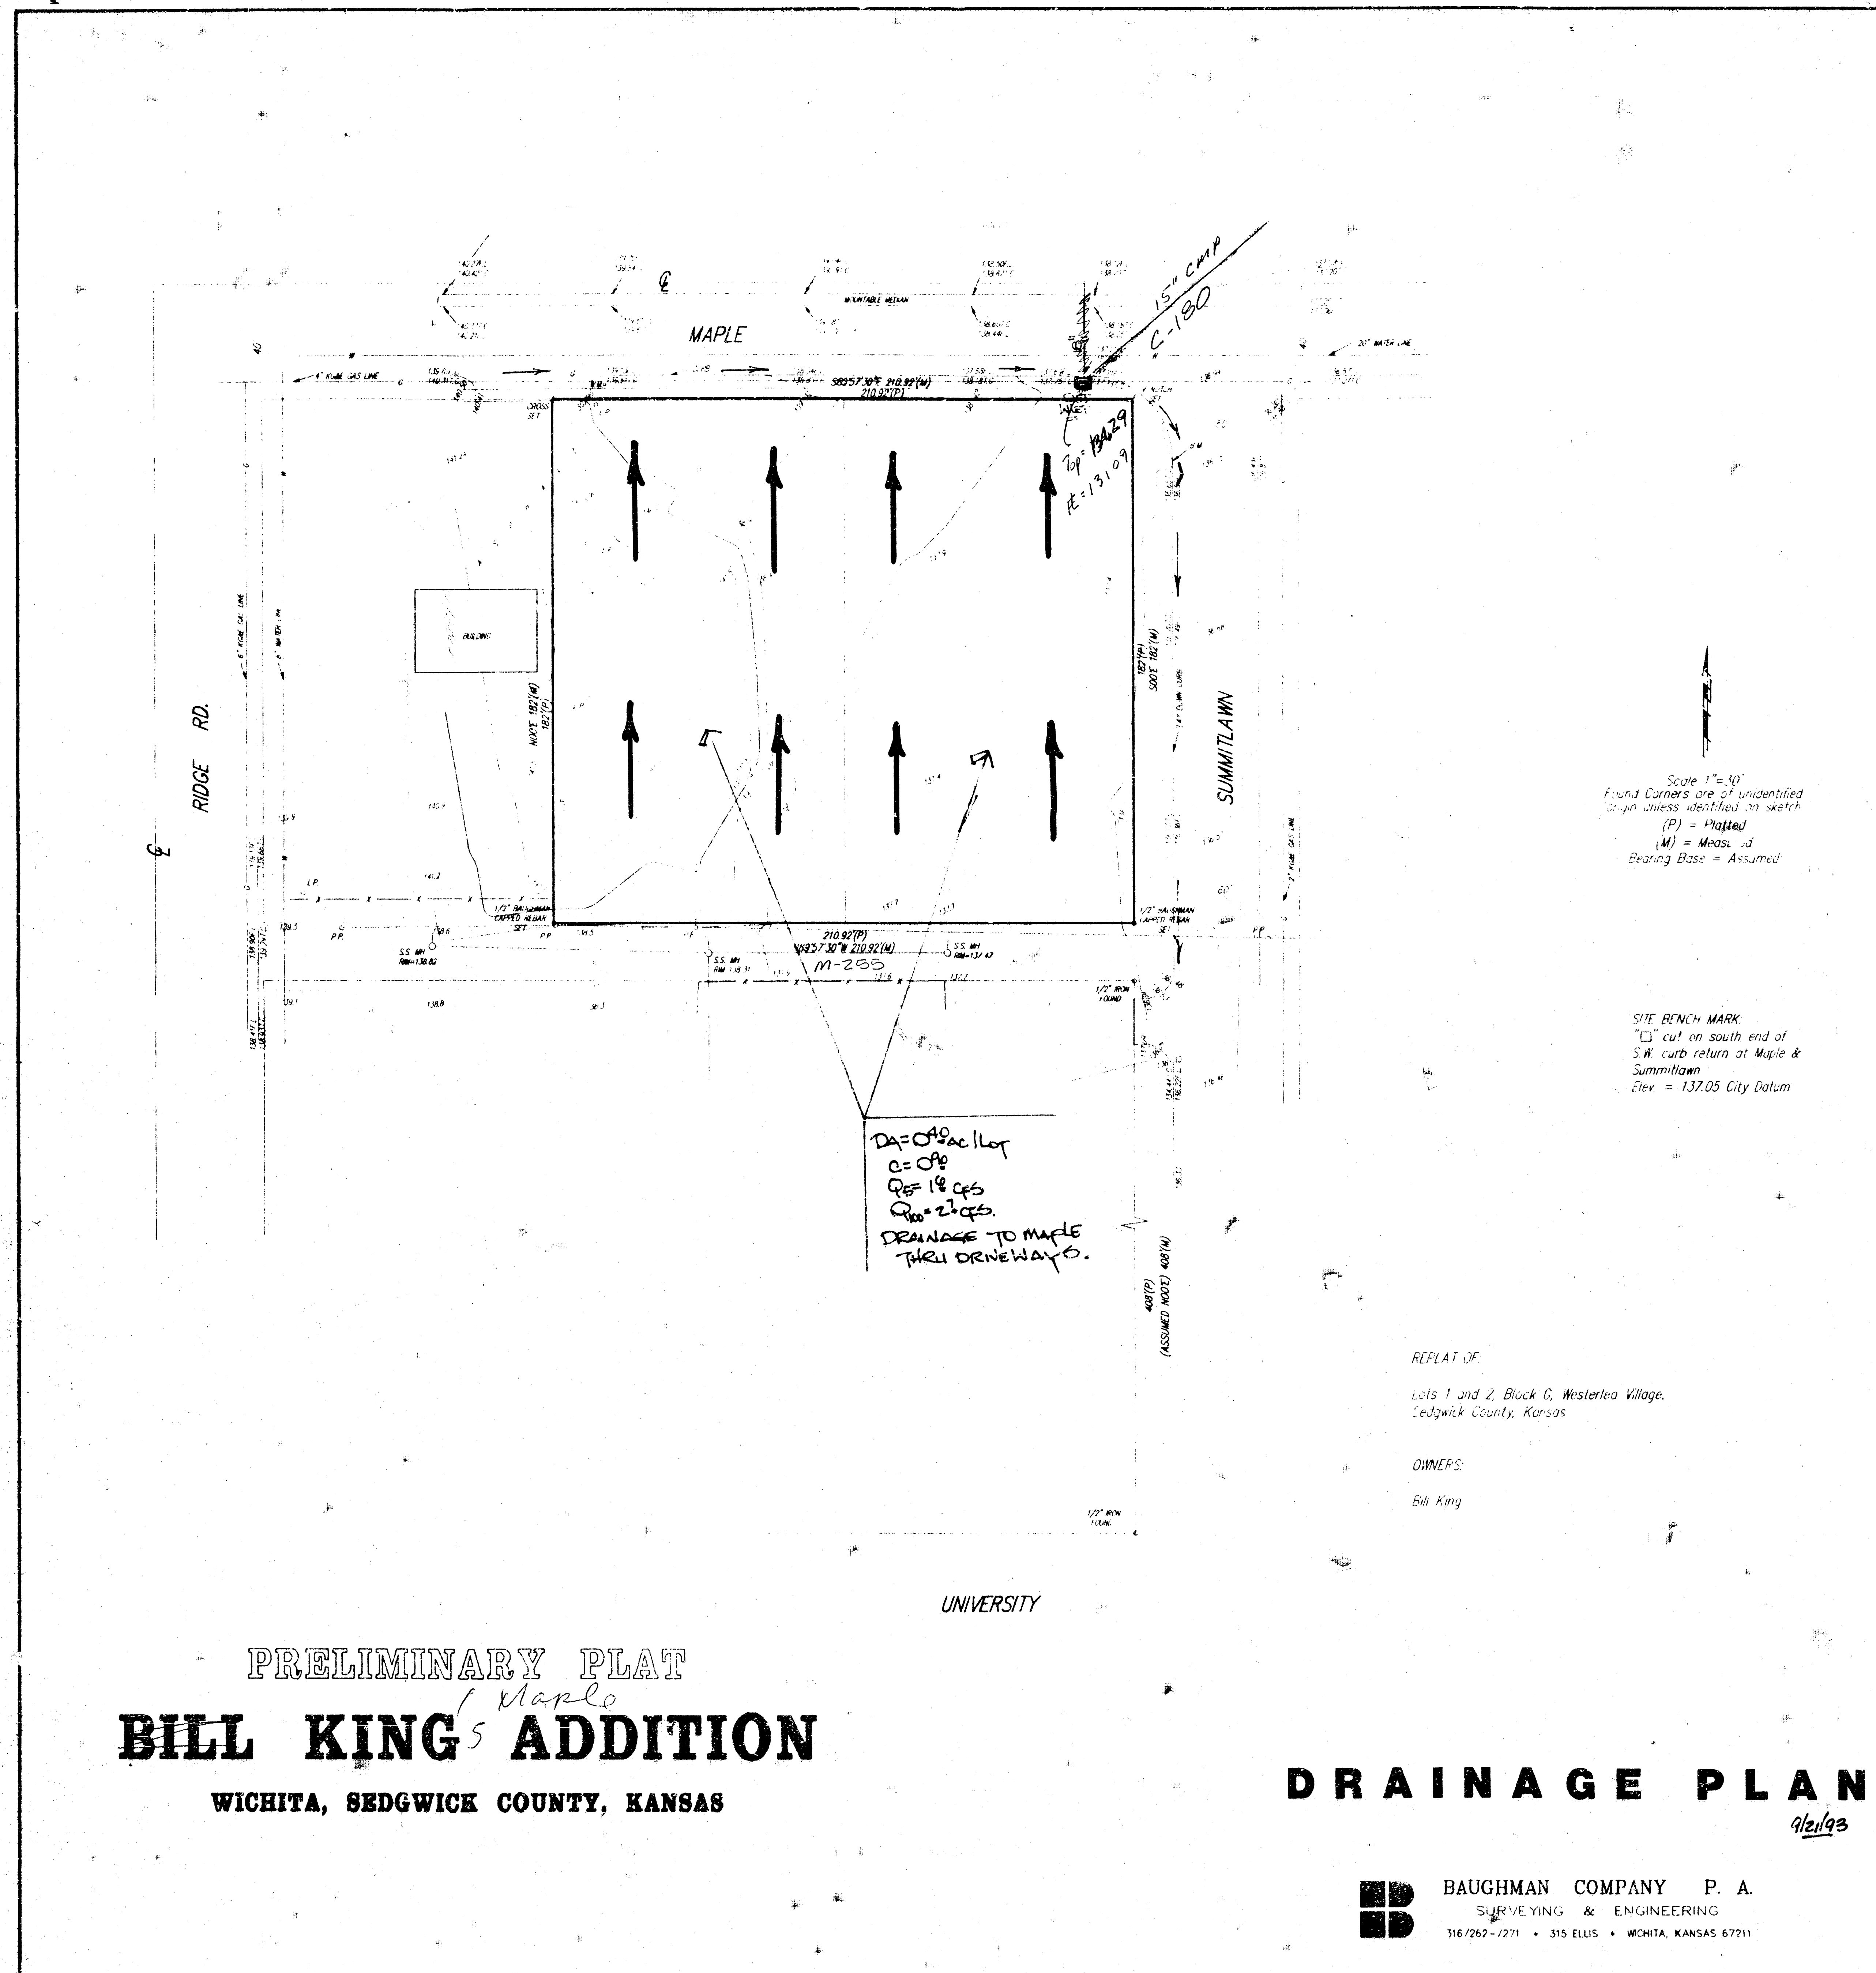

PRELIMINARY PLAT
Maple
BILL KING'S ADDITION
WICHITA, SEDGWICK COUNTY, KANSAS

DRAINAGE PLAN

BAUGHMAN COMPANY P. A.
SURVEYING & ENGINEERING
316/262-1271 • 315 ELLIS • WICHITA, KANSAS 67211