


drainage plan 2-6-84

LAMAR'S ADDITION
(Drainage)

LAMAR'S ADDITION WICHITA, KANSAS

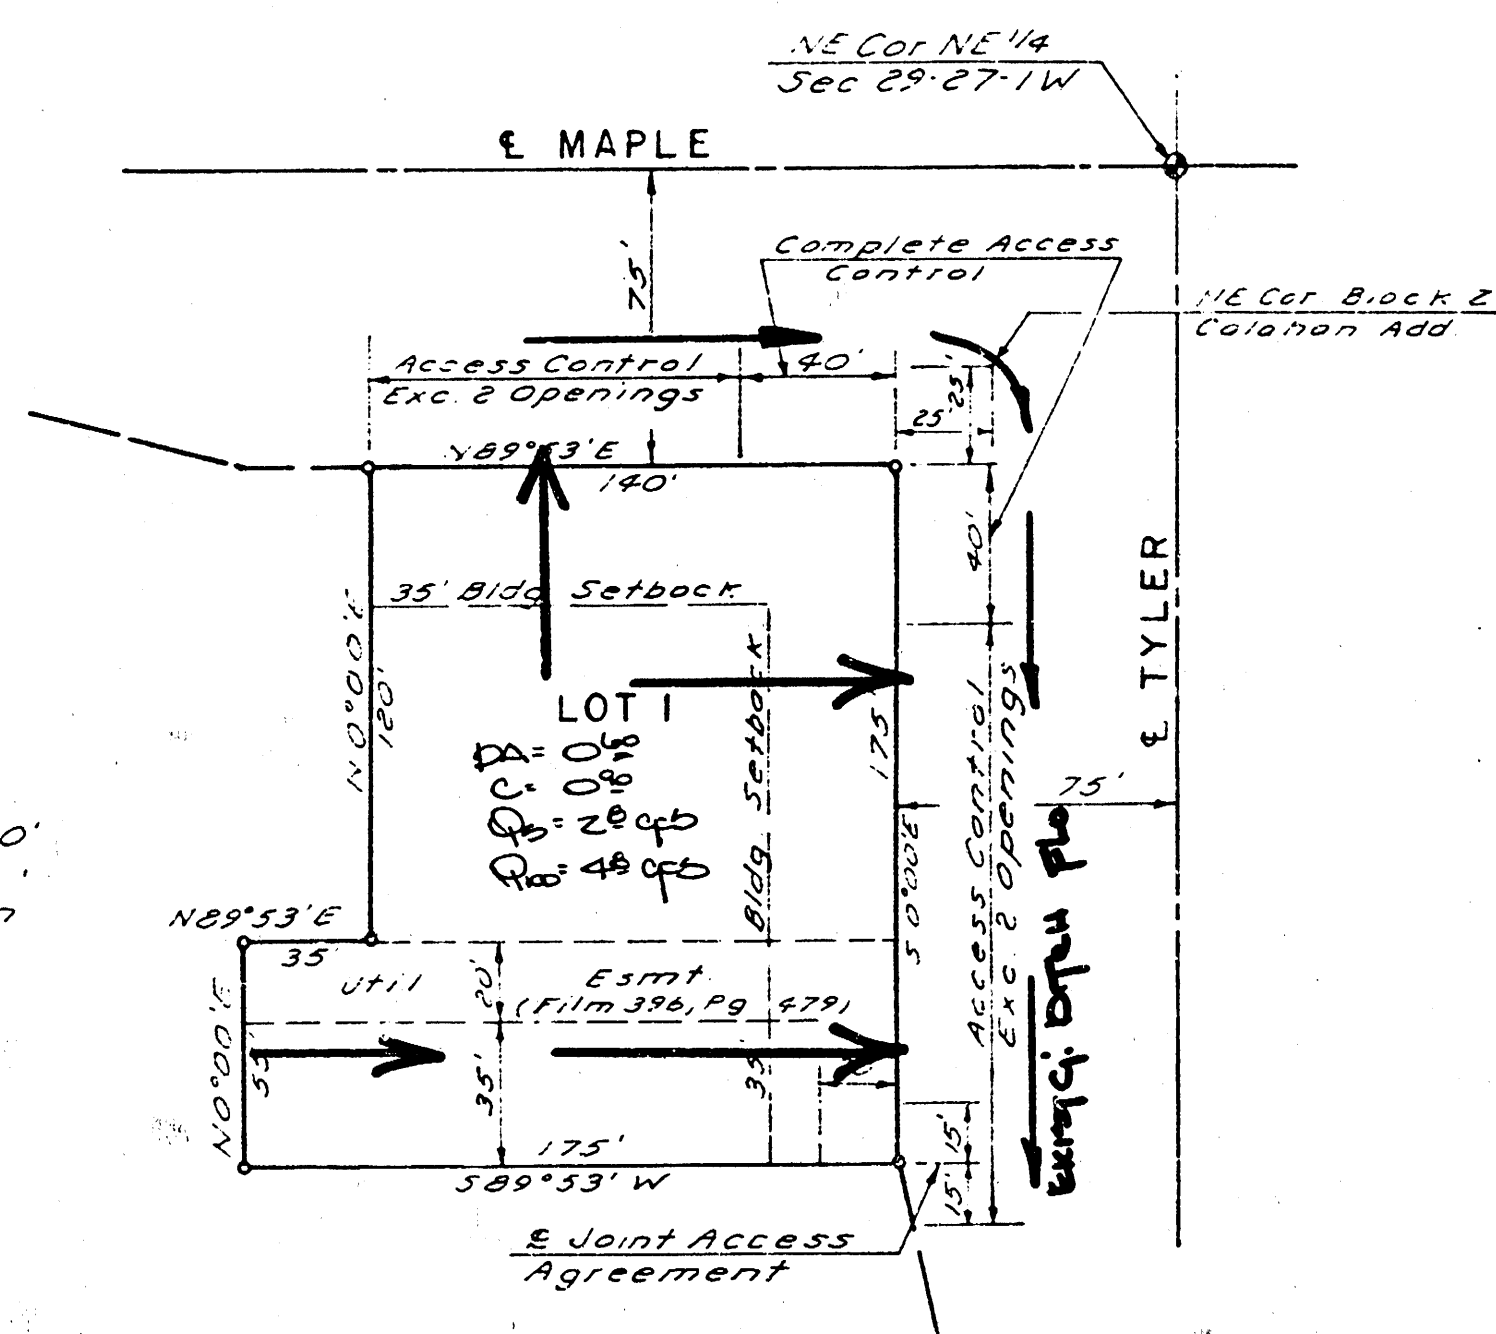

This plot of "LAMAR'S A
Kansas, has been submitted
by the Wichita-Sedgwick Cou
Area Planning Commission, &
this ___ day of ___, 1984
Wichita-Sedgwick County Met.
Area Planning Commission

Robert R. Enthal

Robert A. Lakin

This plot approved and a
hereon accepted by the Board
Wichita, Kansas, this ___ day of

Margaret Wright

Donald C. Blitch

BAUGHMAN COMPANY, P.A.
SURVEYING & ENGINEERING
316/262-7271 • 330 LAURA • WICHITA, KANSAS 67211

CONFIRMATION
MEMO

PROJECT LAMAR'S ADDITION

DATE 2-6-84

COPIES TO:

TO Chris Breitenstein

FROM N. Brent Wooten

REFERENCE Final drainage plan

Final plat is scheduled for subdivision for Feb. 16, 1984.

The lot will be developed for a Quick Trip site with a
runoff factor of 0.90 used.

Lot 1 (0.60') will drain north to Maple and East to Tyler
thru Drives. Tyler and Maple adjacent to this plat are to be paved to
standards with a channelized intersection. Presently both are asphalt
mat streets with ditches.

RECEIVED
FEB 11 1984
Capt. [Signature]

PAGE 1 OF 1