

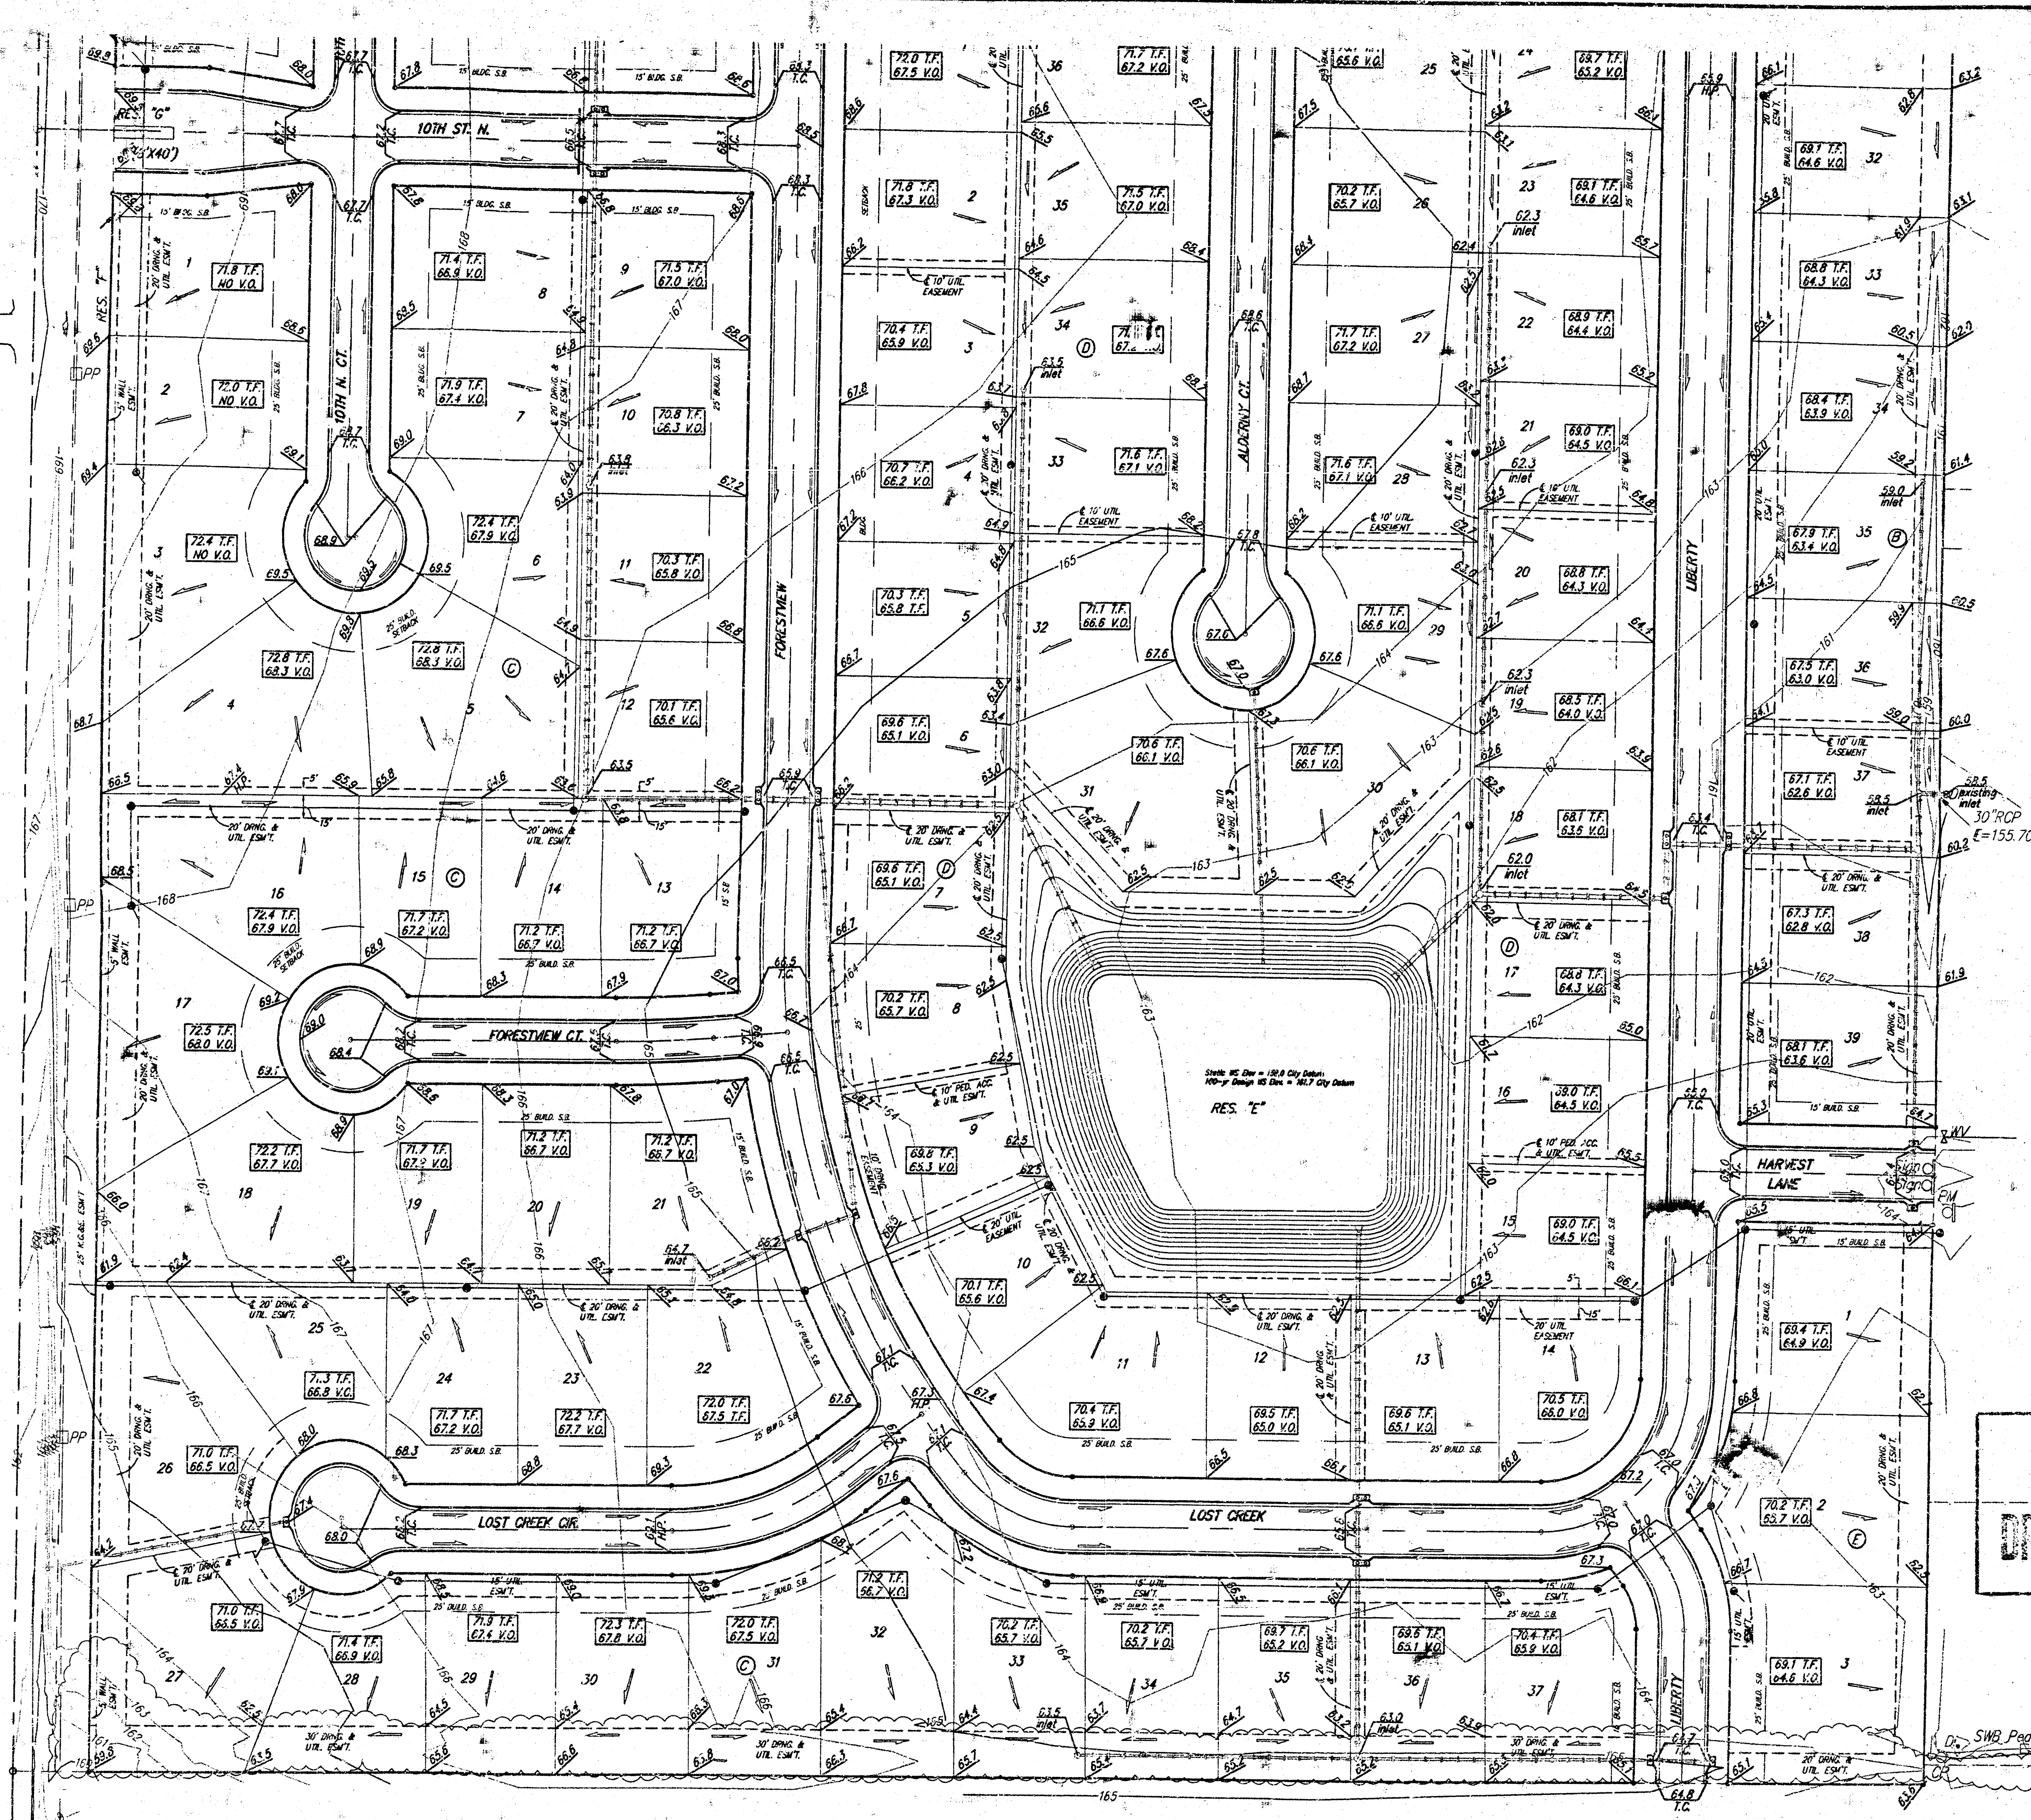
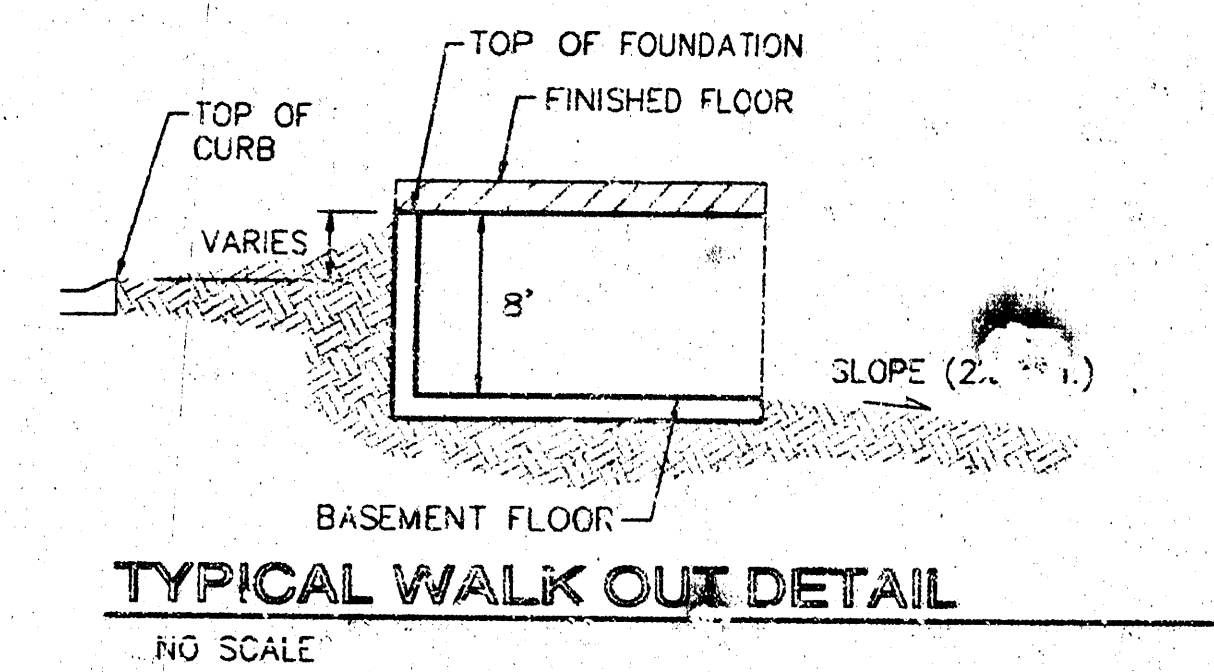


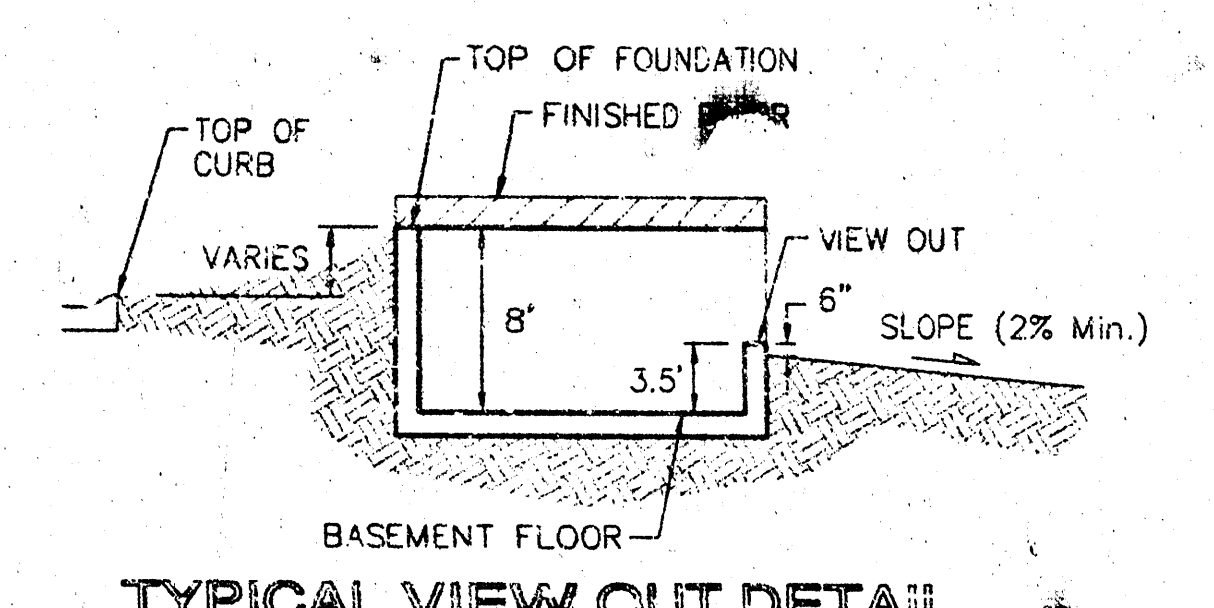

6022M-50K
 Cont. 604' not in H.L.R. 800' west &
 31' north of the NE cor. NW 1/4, Sec.
 15, Twp. 27-S, R-2-W of the 6th
 P.M.
 Elev. = 102.88 City Datum
 1350.00 A.G. 10.29

MINIMUM BUILDING PAD ELEVATIONS FOR LOWEST OPENING TO THE STRUCTURES		
LOT	BLOCK	ELEVATION CITY DATUM
1-19	B	
20-39	D	

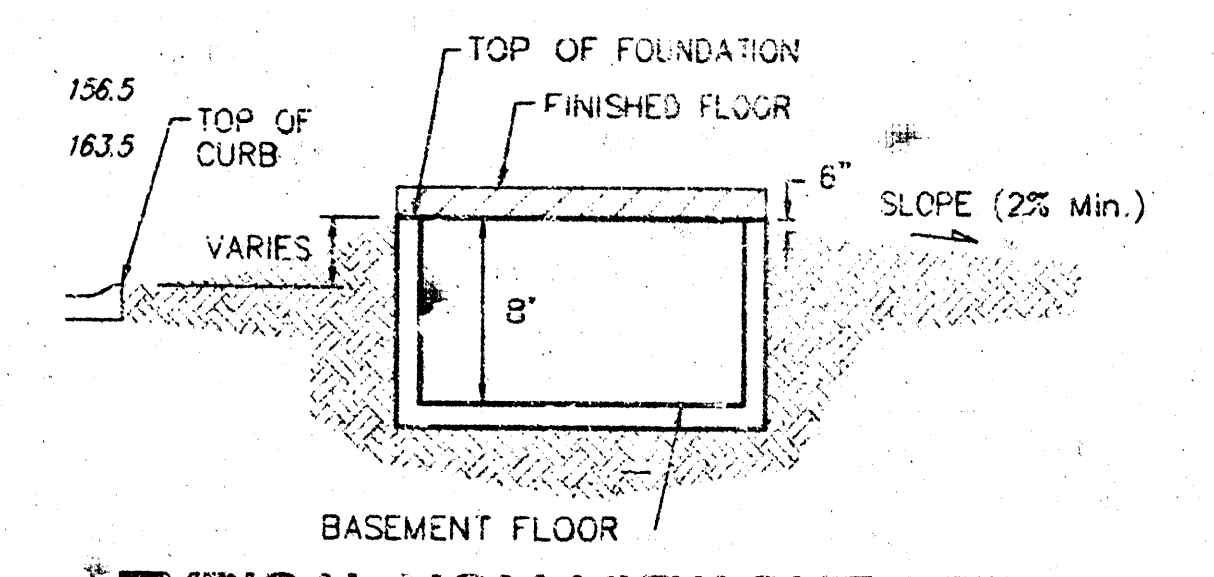

NOTES:
 Proposed Top of Foundation Elevations Are Shown On
 Plans. Contractor to Set Finished Floor Elevations.
 All Street Elevations Shown on Plans Are for Top of
 Curb (Full-Height).
 This Grading Plan is Designed with View-Outs.
 Elevations Shown at Rear of House (XX.X V.O.)
 Lot dimensions have been omitted on this plan,
 refer to the recorded plat for this information.


**APPROVED
 DRAINAGE PLAN**

25 June 03 revised house elev by SHD per NEN
 DIM A: Lots 2, 17-21, 29, 34, 38-39
 DIM B: Lots 5-9

**LIBERTY PARK 2nd ADDITION
 GRADING PLAN**
 WICHITA, KANSAS


BAUGHMAN COMPANY P.A.
 ENGINEERING, SURVEYING, & PLANNING
 316-782-7271 • 315 ELLIS • WICHITA, KANSAS 67211

DESIGN BLG	DRAWN BLG	APPROVED	DATE 03/24/03	SCALE NOTED	SHEET 1
---------------	--------------	----------	------------------	----------------	------------

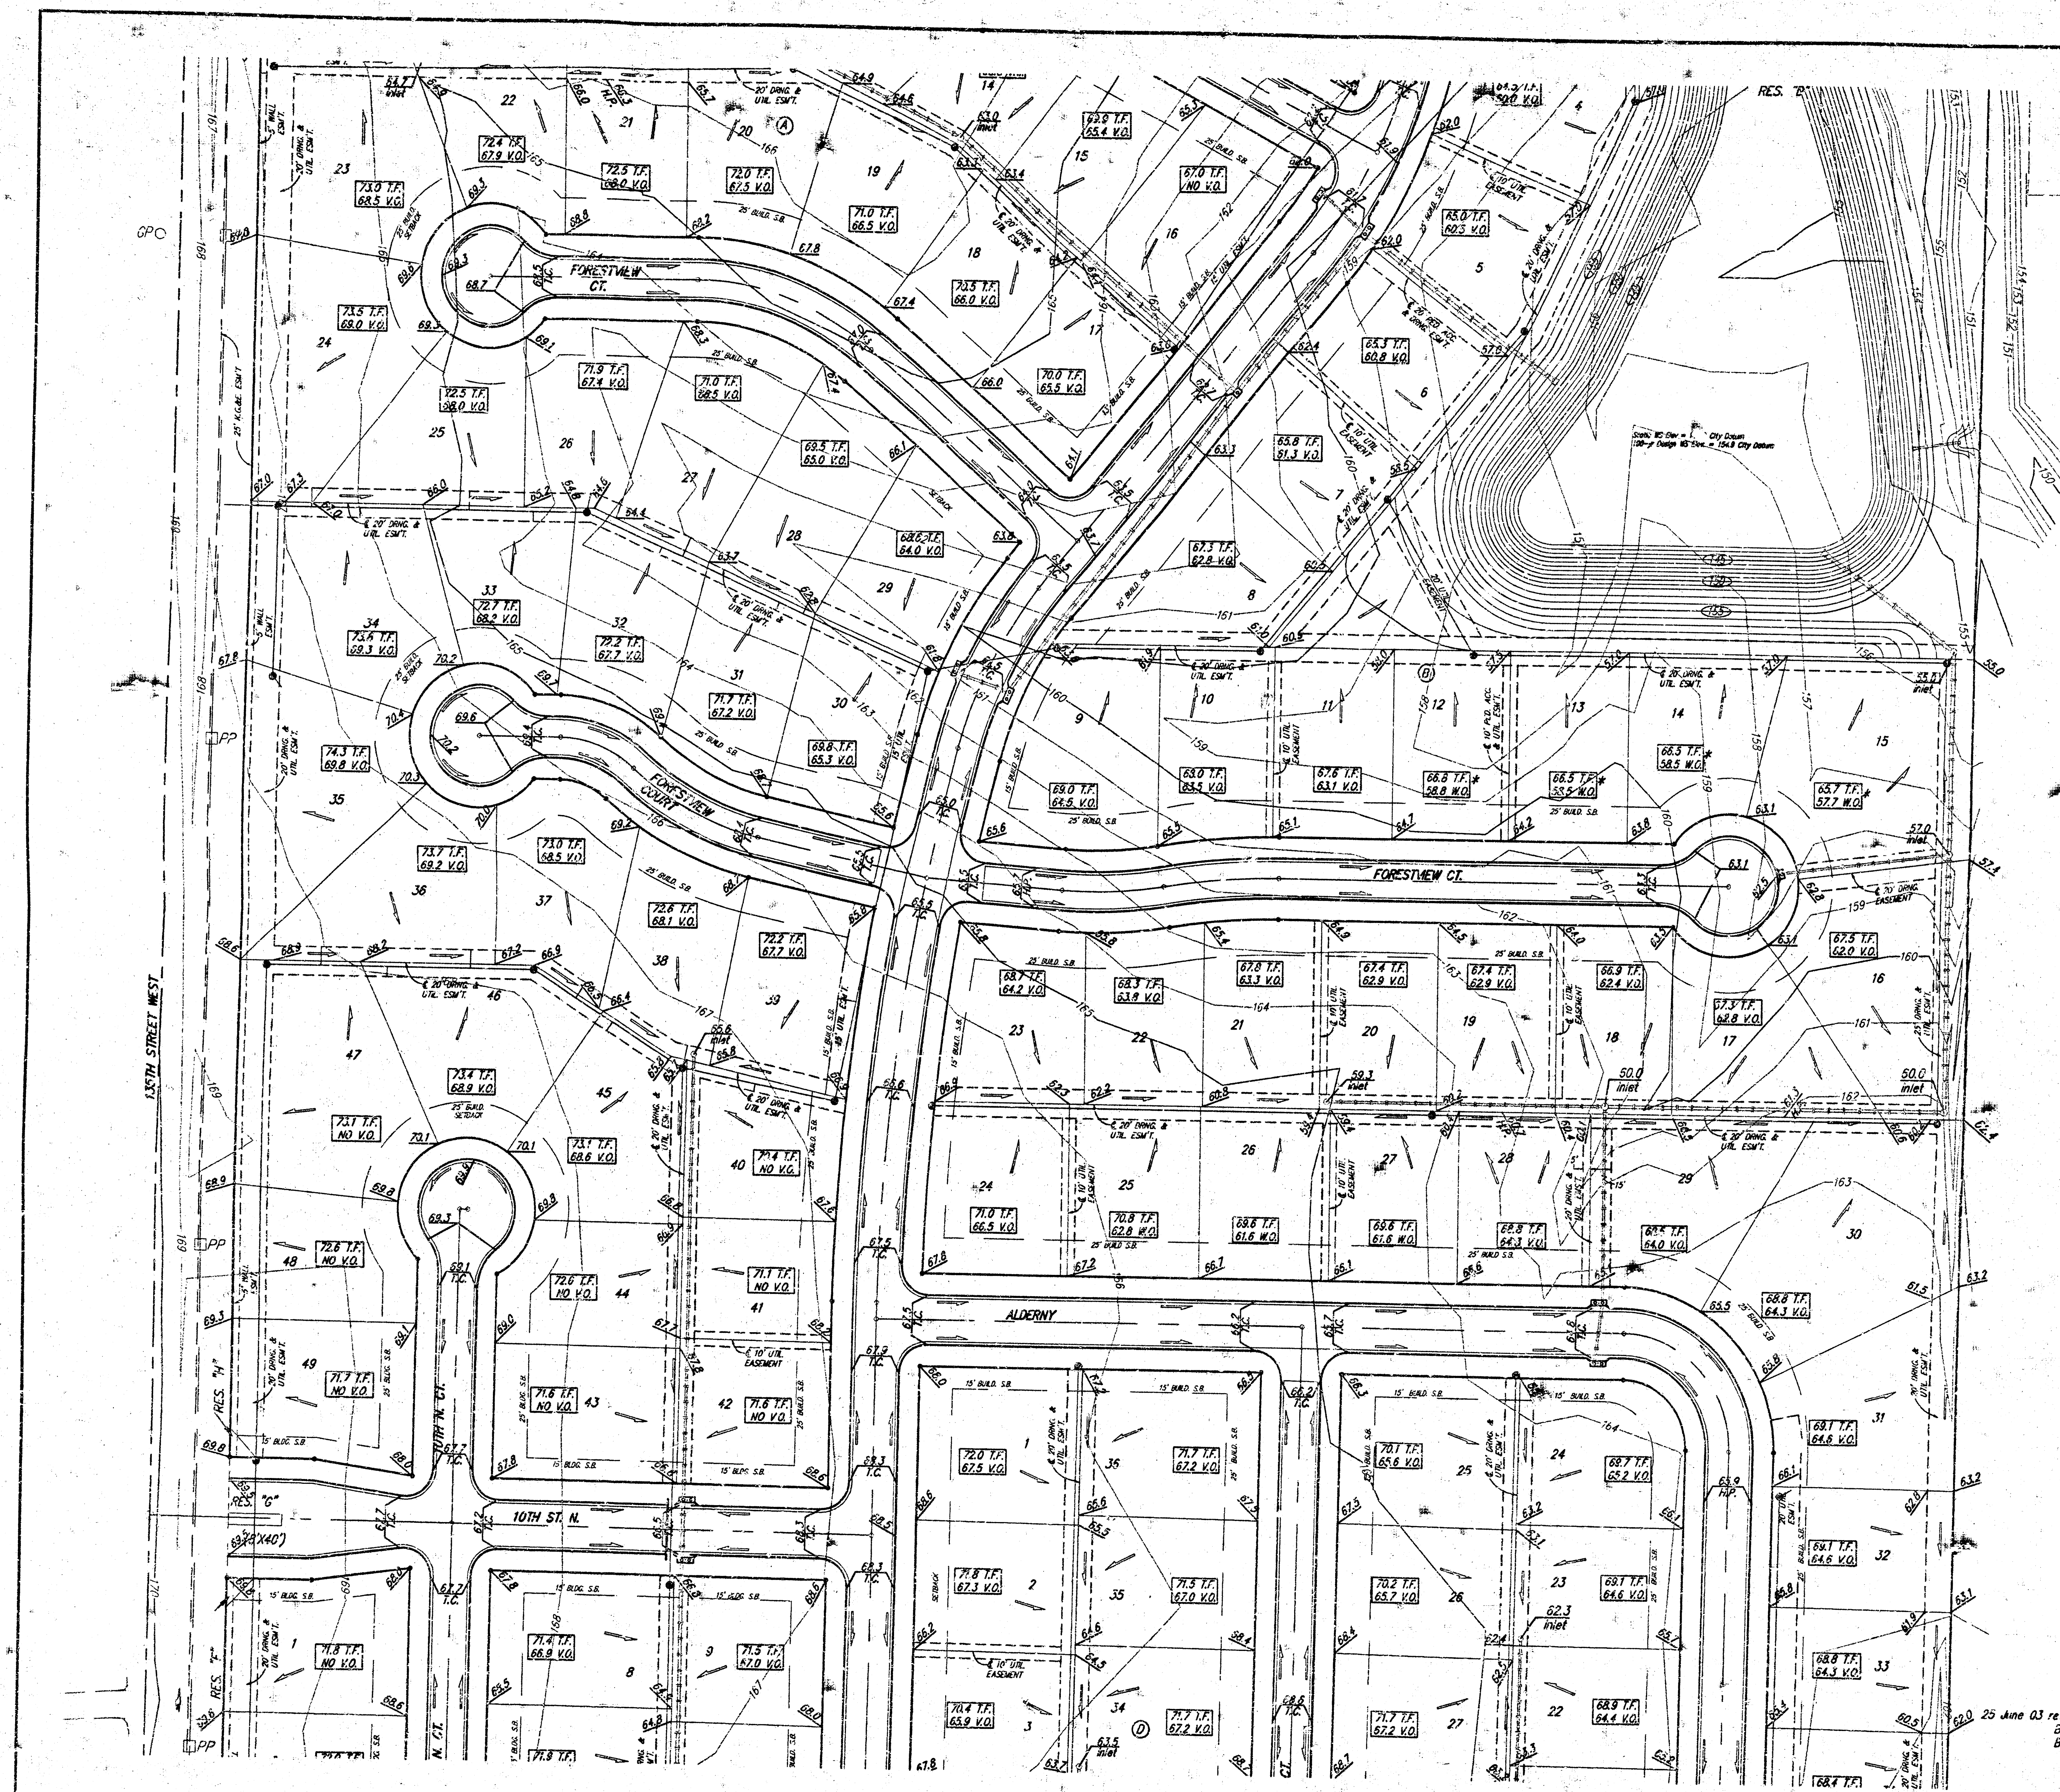


BENCHMARK
 County 600' not in K.L.P. 800' west &
 31' north of the NE cor. NW 1/4 Sec.
 12, Twp. 27-S, R-2-W of the 6th
 P.M.
 Elev. = 152.88 City Datum
 1330.08 H.G. V.O. 29


MINIMUM BUILDING PAD ELEVATIONS FOR LOWEST OPENING TO THE STRUCTURES		
LOT	BLUCK	ELEVATION
1-19	B	156.5
20-22, 33-36	D	156.5

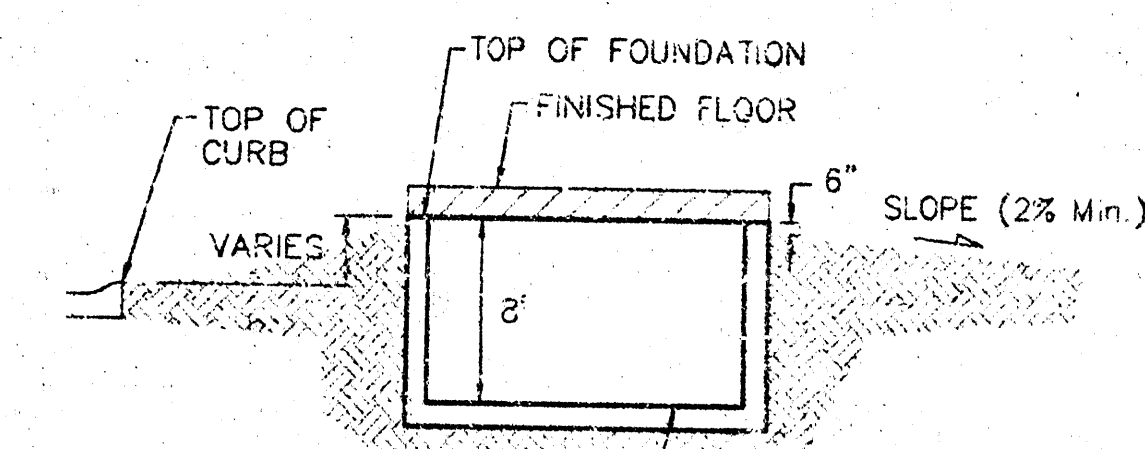

TYPICAL NON-VIEW OUT DETAIL
 NO SCALE

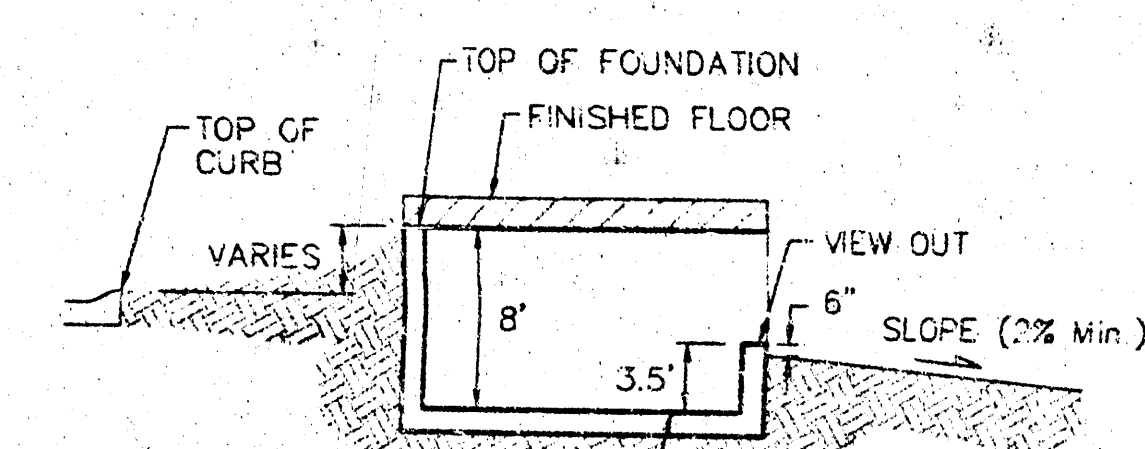

TYPICAL VIEW OUT DETAIL
 NO SCALE

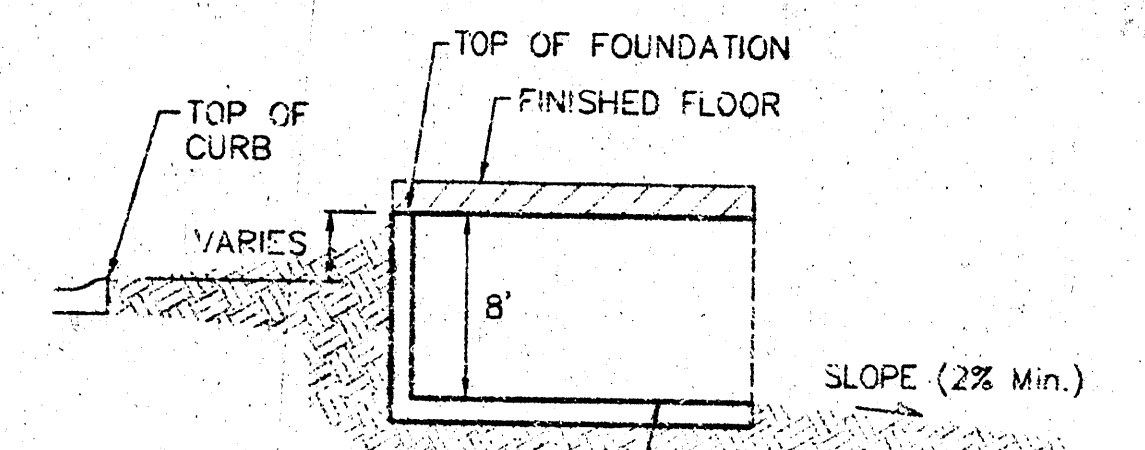

TYPICAL WALK OUT DETAIL
 NO SCALE

NOTES

Proposed Top of Foundation Elevations Are Shown On Plans. Contractor to Set Finished Floor Elevations.


All Street Elevations Shown on Plans Are for Top of Curb (Full-Height).

This Grading Plan is Designed with View-Outs. Elevations Shown at Rear of House (XX.X V.O.).

Lot dimensions have been omitted on this plan, refer to the recorded plat for this information.



* Indicates extra deep foundation may be required

LIBERTY PARK 2nd ADDITION GRADING PLAN WICHITA, KANSAS			
BAUGHMAN COMPANY P.A. ENGINEERING, SURVEYING, & PLANNING 315-262-2271 • 315 ELLIS • WICHITA, KANSAS 67211			
PROJECT NUMBER		SHEET	
215-262-2271		2	
DESIGN	DWG	APPROVED	DATE
ELG	BLG	03/24/03	SCALE
			NOTED
			3

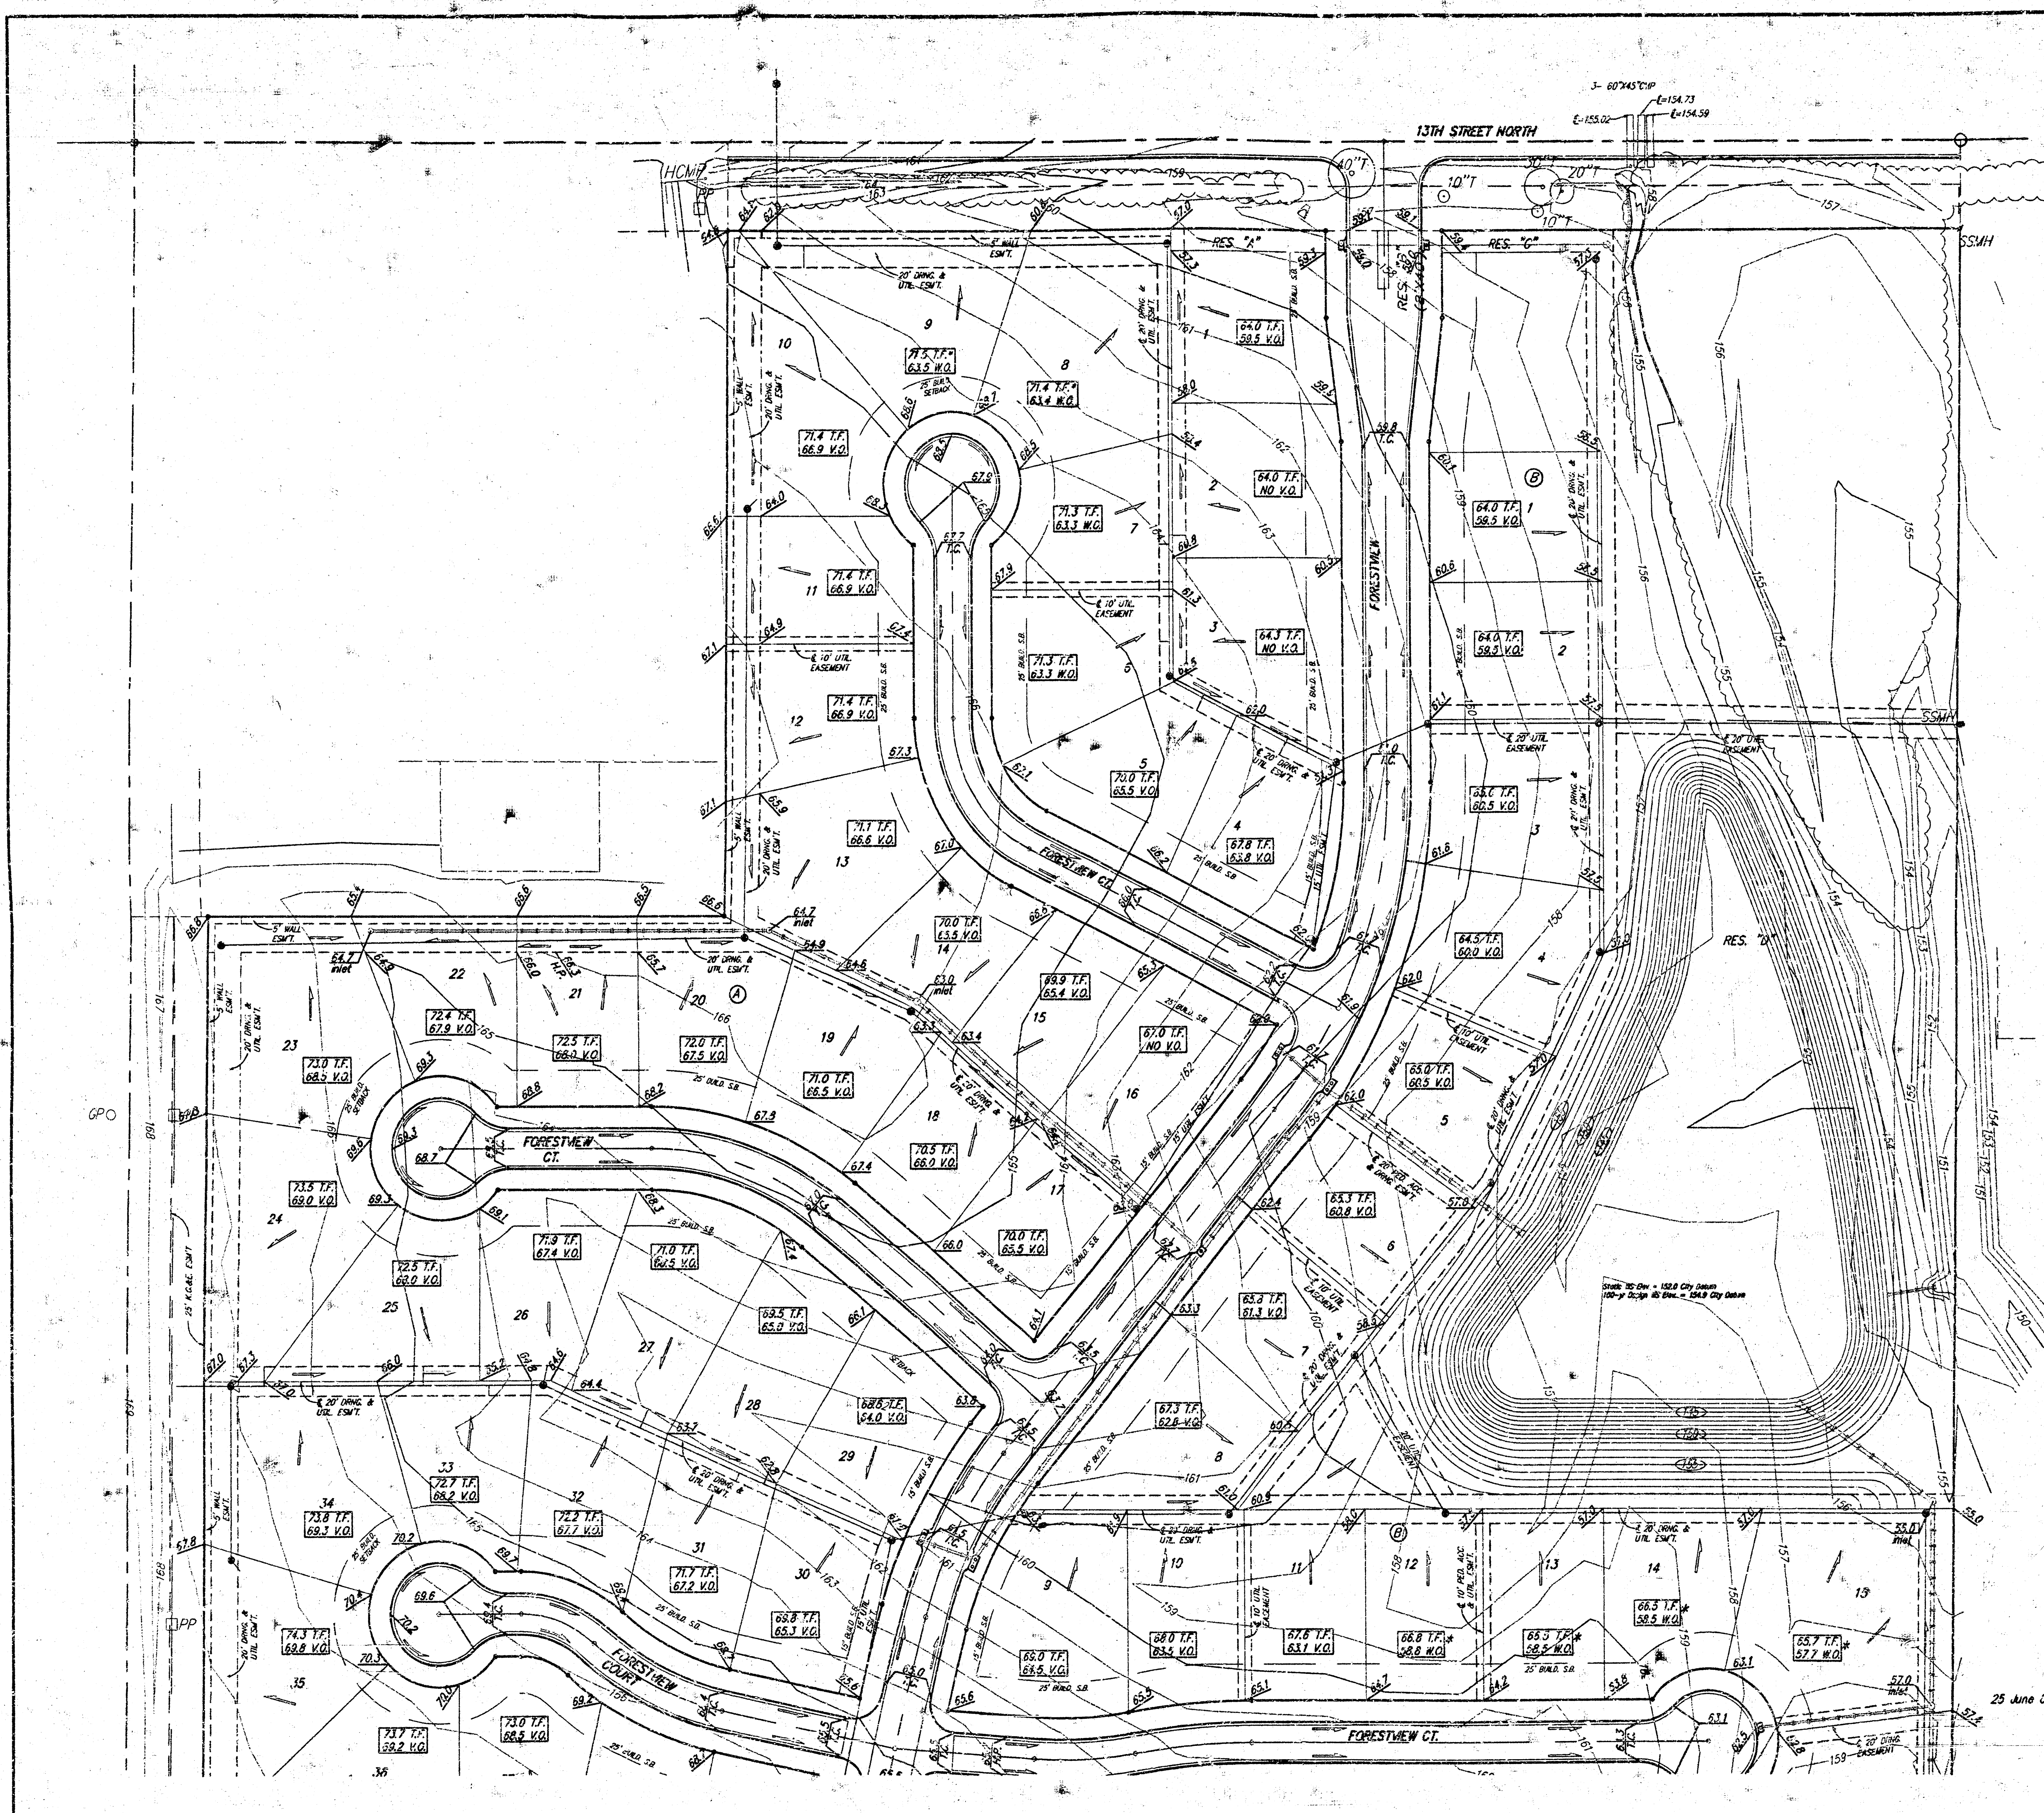


GENERAL NOTE:
 31' north of the NE cor. NW 1/4, Sec.
 13, Twp. 27-S, R-2-W of the 6th
 P.M.
 Elev=162.88 City Datum
 1350.09 H.G. V.O. 29


LOT	BLOCK	ELEVATION CITY DATUM
1-19	B	156.5
20-22, 33-35	D	163.5

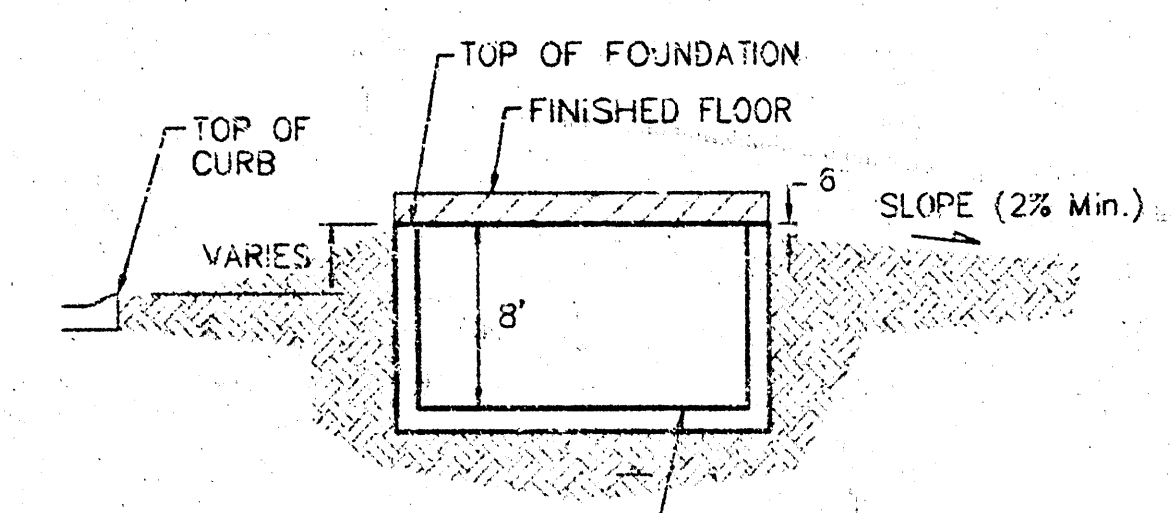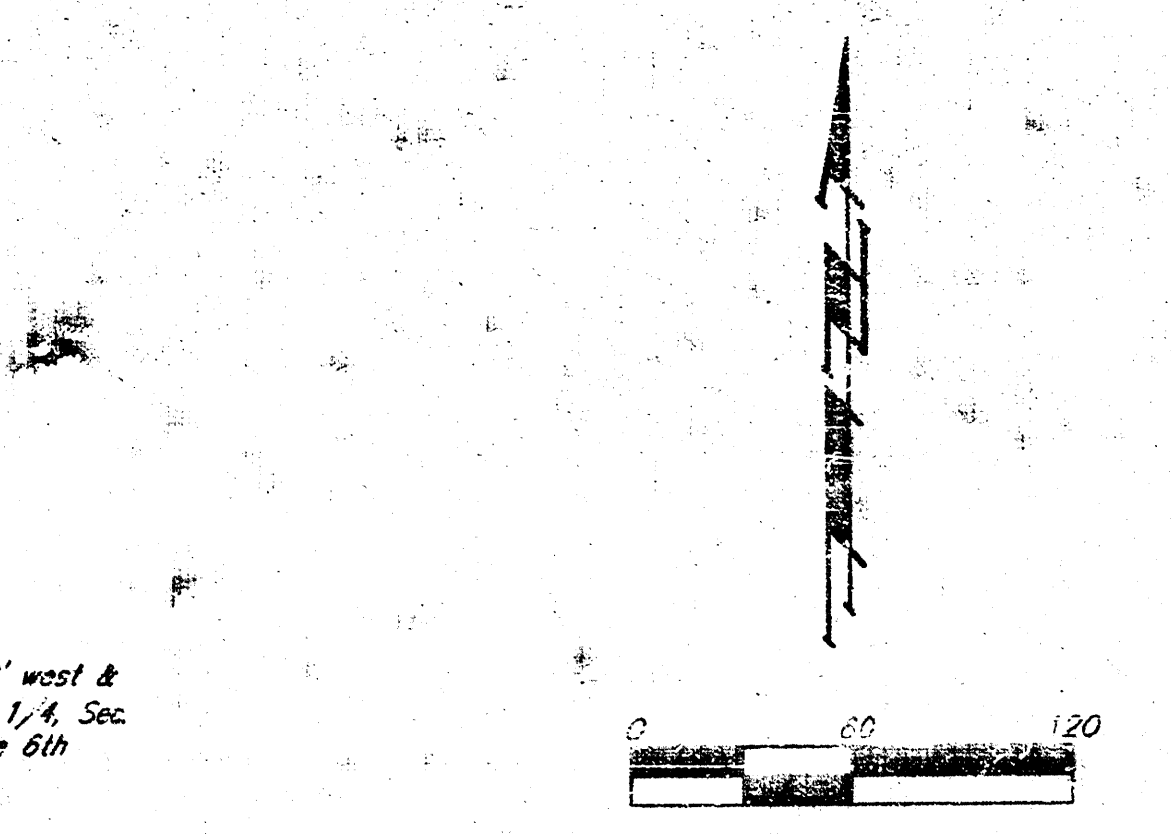

TYPICAL NON-VIEW OUT DETAIL
 NO SCALE

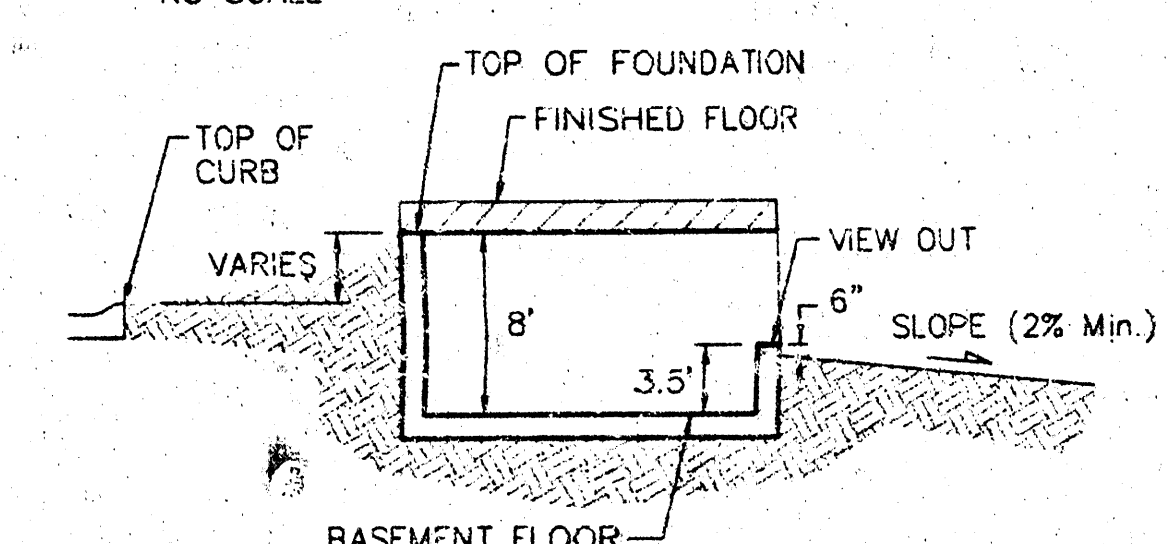

TYPICAL VIEW OUT DETAIL
 NO SCALE

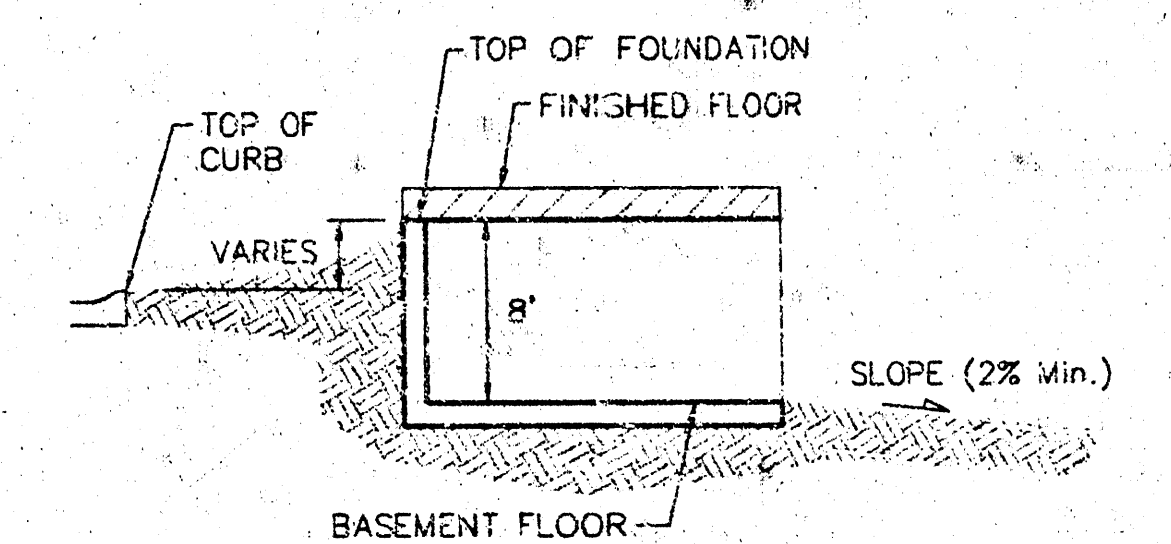

TYPICAL WALK OUT DETAIL
 NO SCALE

NOTES:
 Proposed Top of Foundation Elevations Are Shown On
 Plans. Contractor to Set Finished Floor Elevations.
 All Street Elevations Shown on Plans Are for Top of
 Curb (Full-Height).
 This Grading Plan is Designed with View-Outs.
 Elevations Shown at Rear of House (XX.X V.O.).
 Lot dimensions have been omitted on this plan,
 refer to the recorded plat for this information.

LIBERTY PARK 2nd ADDITION
GRADING PLAN
 WICHITA, KANSAS

BAUGHMAN COMPANY P.A.
 ENGINEERING, SURVEYING, & PLANNING

316-283-2711 • 315 FLUOR • WICHITA, KANSAS 67211

DESIGN BLG	DRAWN BLG/SMD	APPROVED	DATE 06/25/03	SCALE NOTED
---------------	------------------	----------	------------------	----------------

 SHEET: 3 OF 8

25 June 03 revised house elev by SMD per NWH
 28 A: Lots 2, 17-21, 28, 34, 38-39
 28 B: Lots 5-9