


EXISTING DRAINAGE DEDICATION FILM 414, PAGE 845

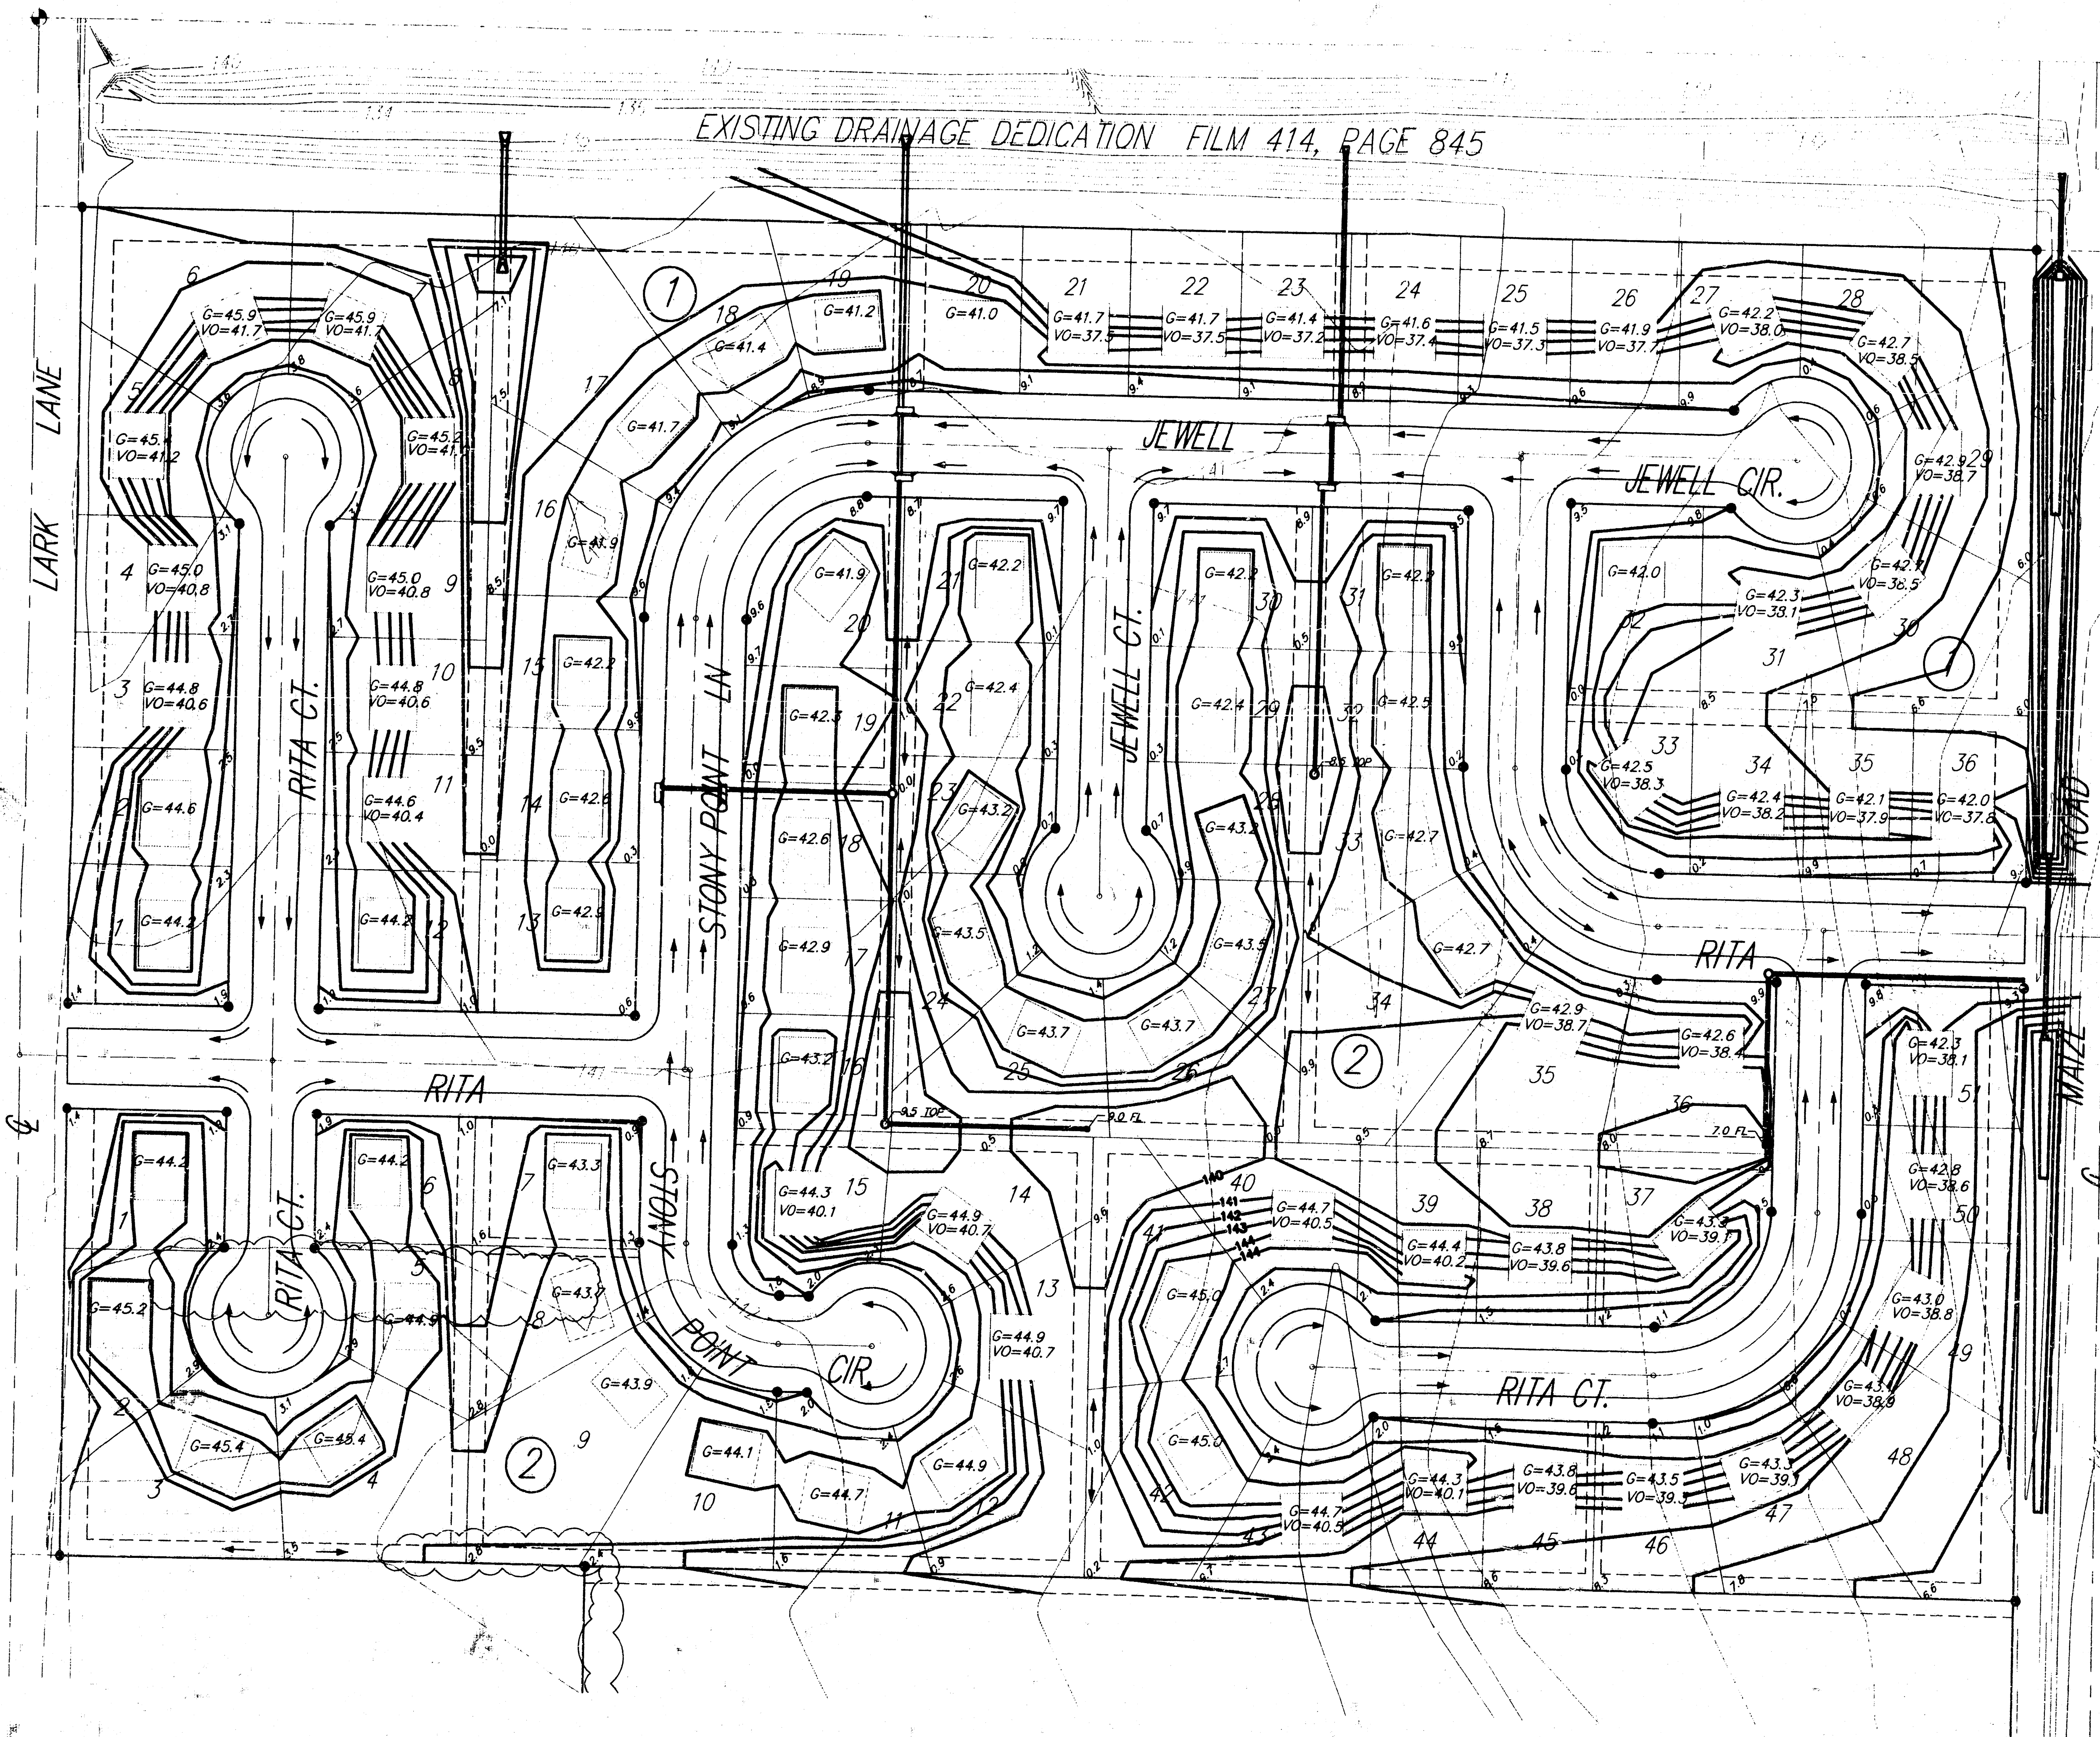

SCALE: 1" = 60'

REMOVED
DRAINAGE PLAN

LOT GRADING PLAN LINDSAY'S ADDITION WICHITA, KANSAS					
SRB	924 NORTH MAIN WICHITA, KANSAS 67203 http://www.fest.com/~srb		316-264-8008 FAX 264-4621 E-mail: srbs@fast.com		SHEET 1 OF 1
	SAVOY, RUGGLES & BOHM, P. A. ENGINEERING & SURVEYING				
PROJECT NUMBER					
DESIGN AML	DRAWN AML	UTILITY	REVIEW	DATE Jan. 13, 1998	REVISED