


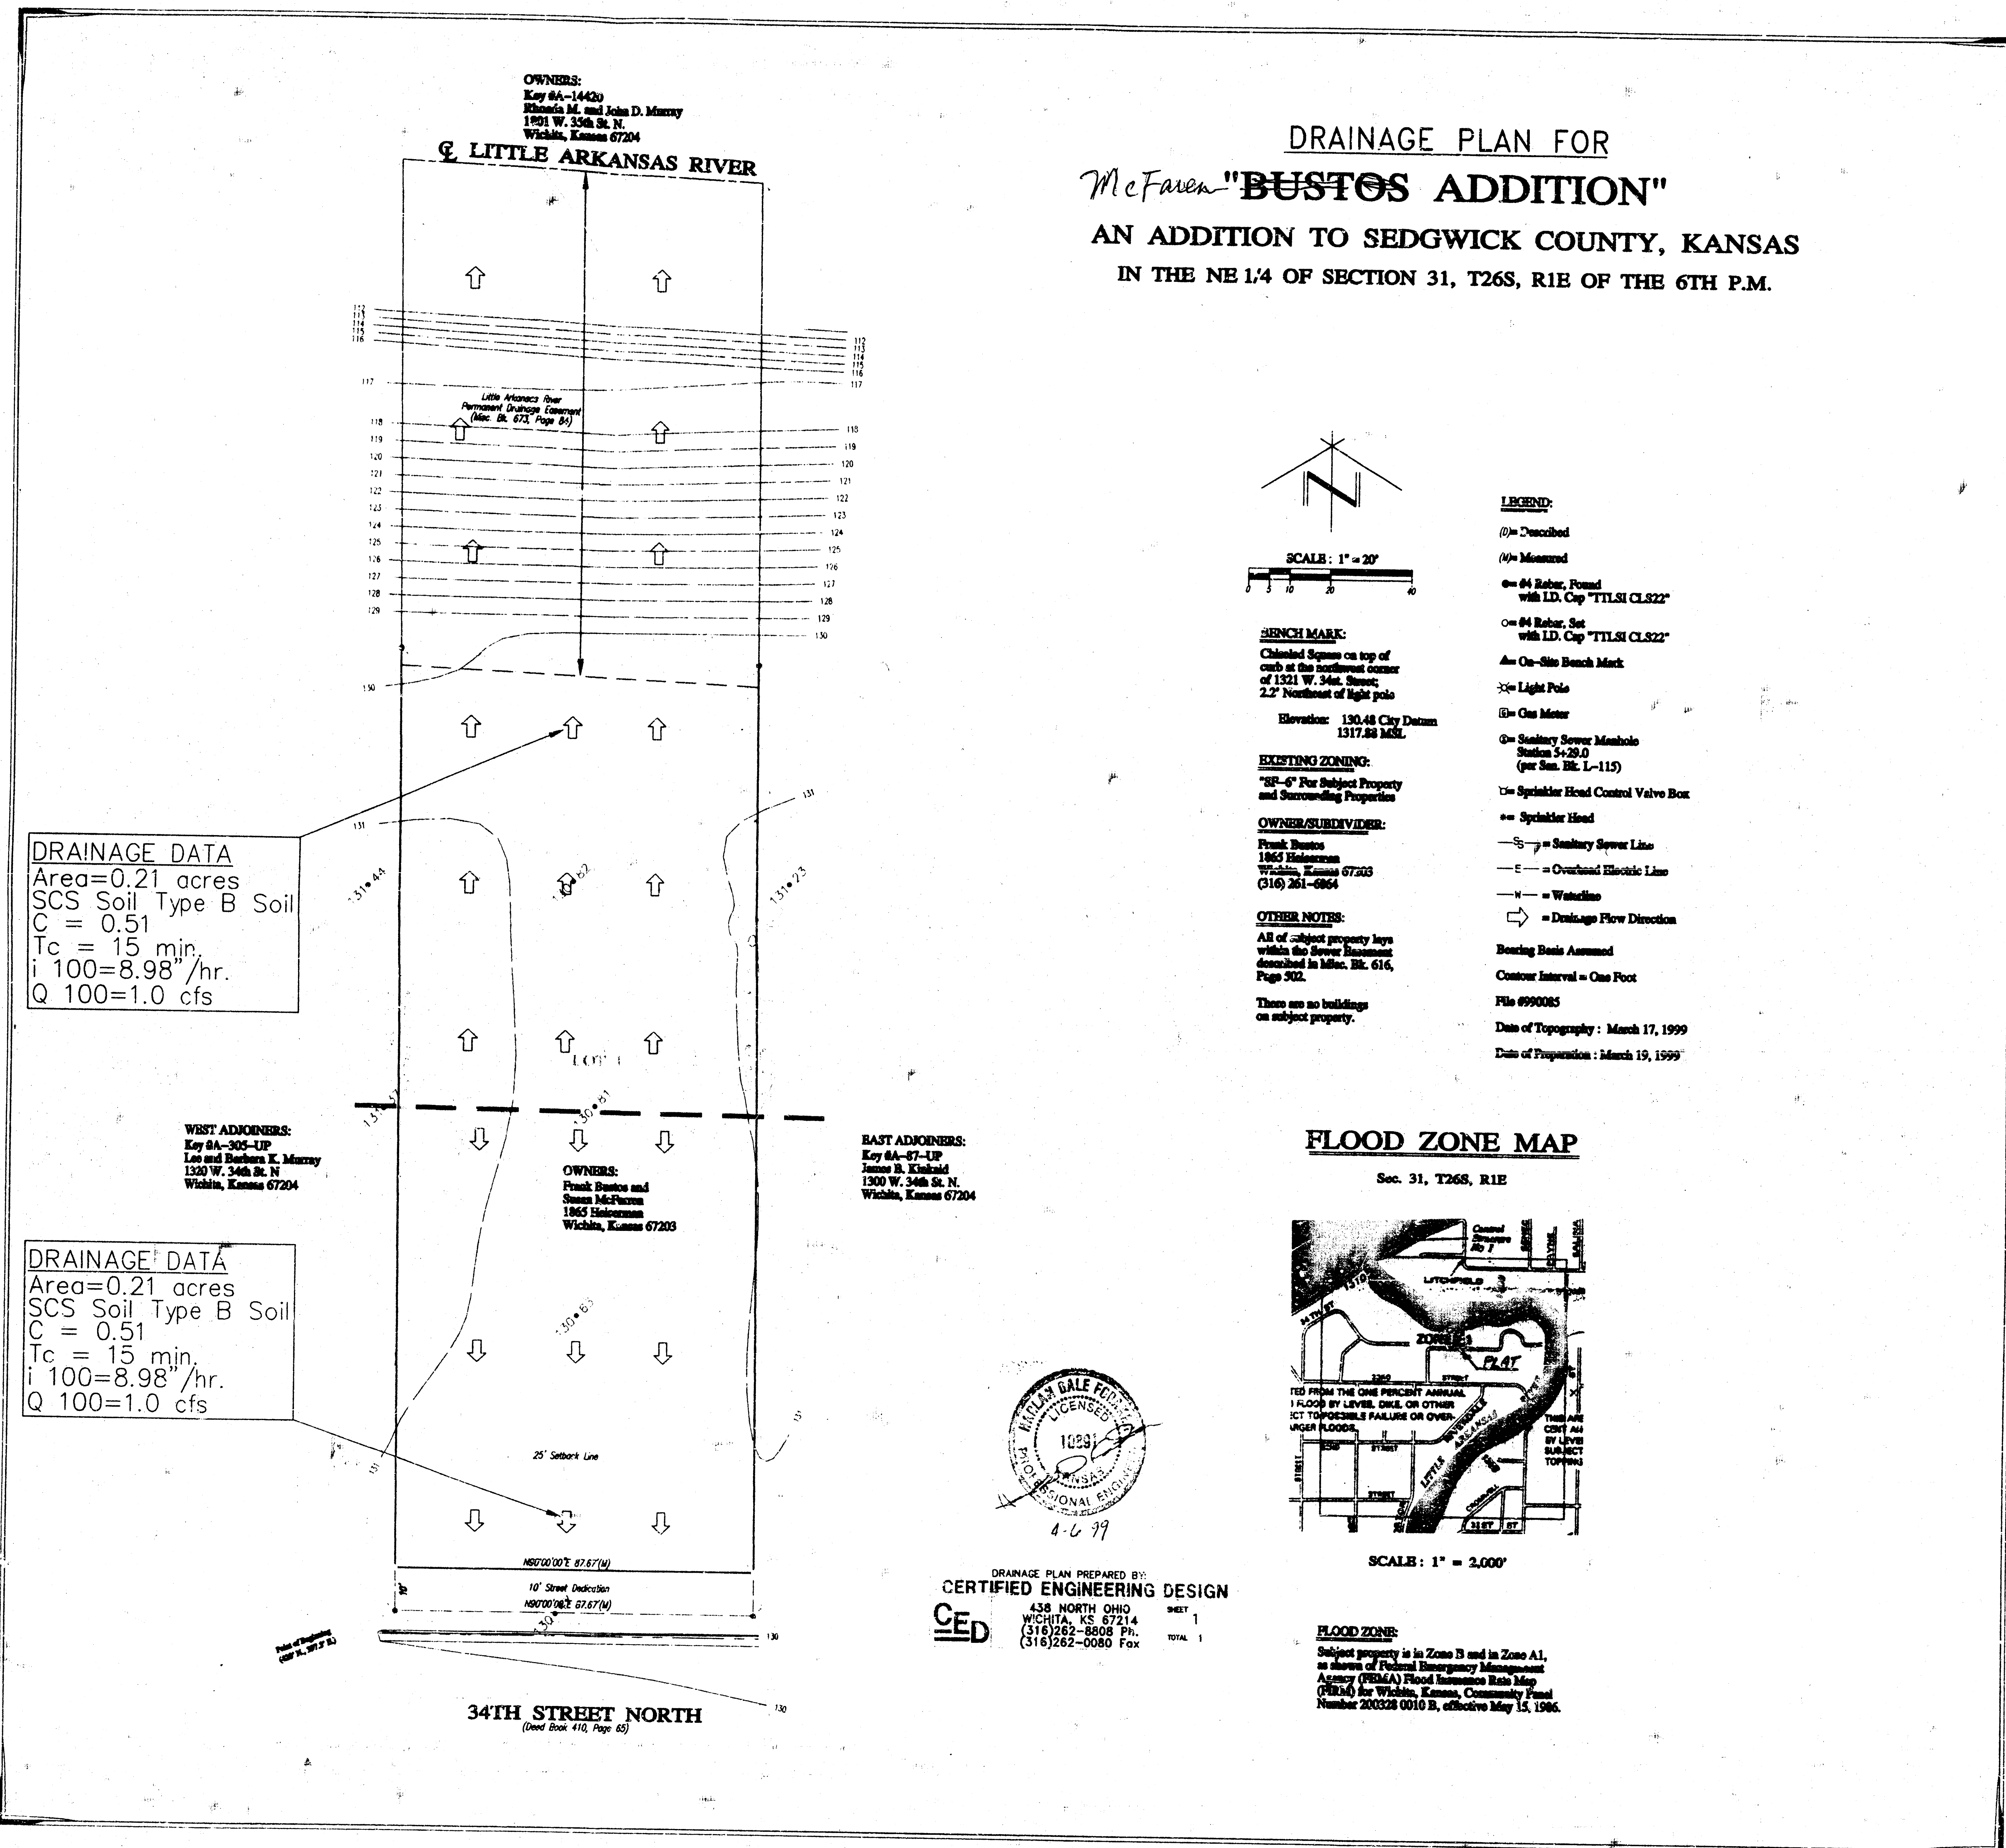

LEGAL DESCRIPTION FOR
"BUSTOS ADDITION"

