


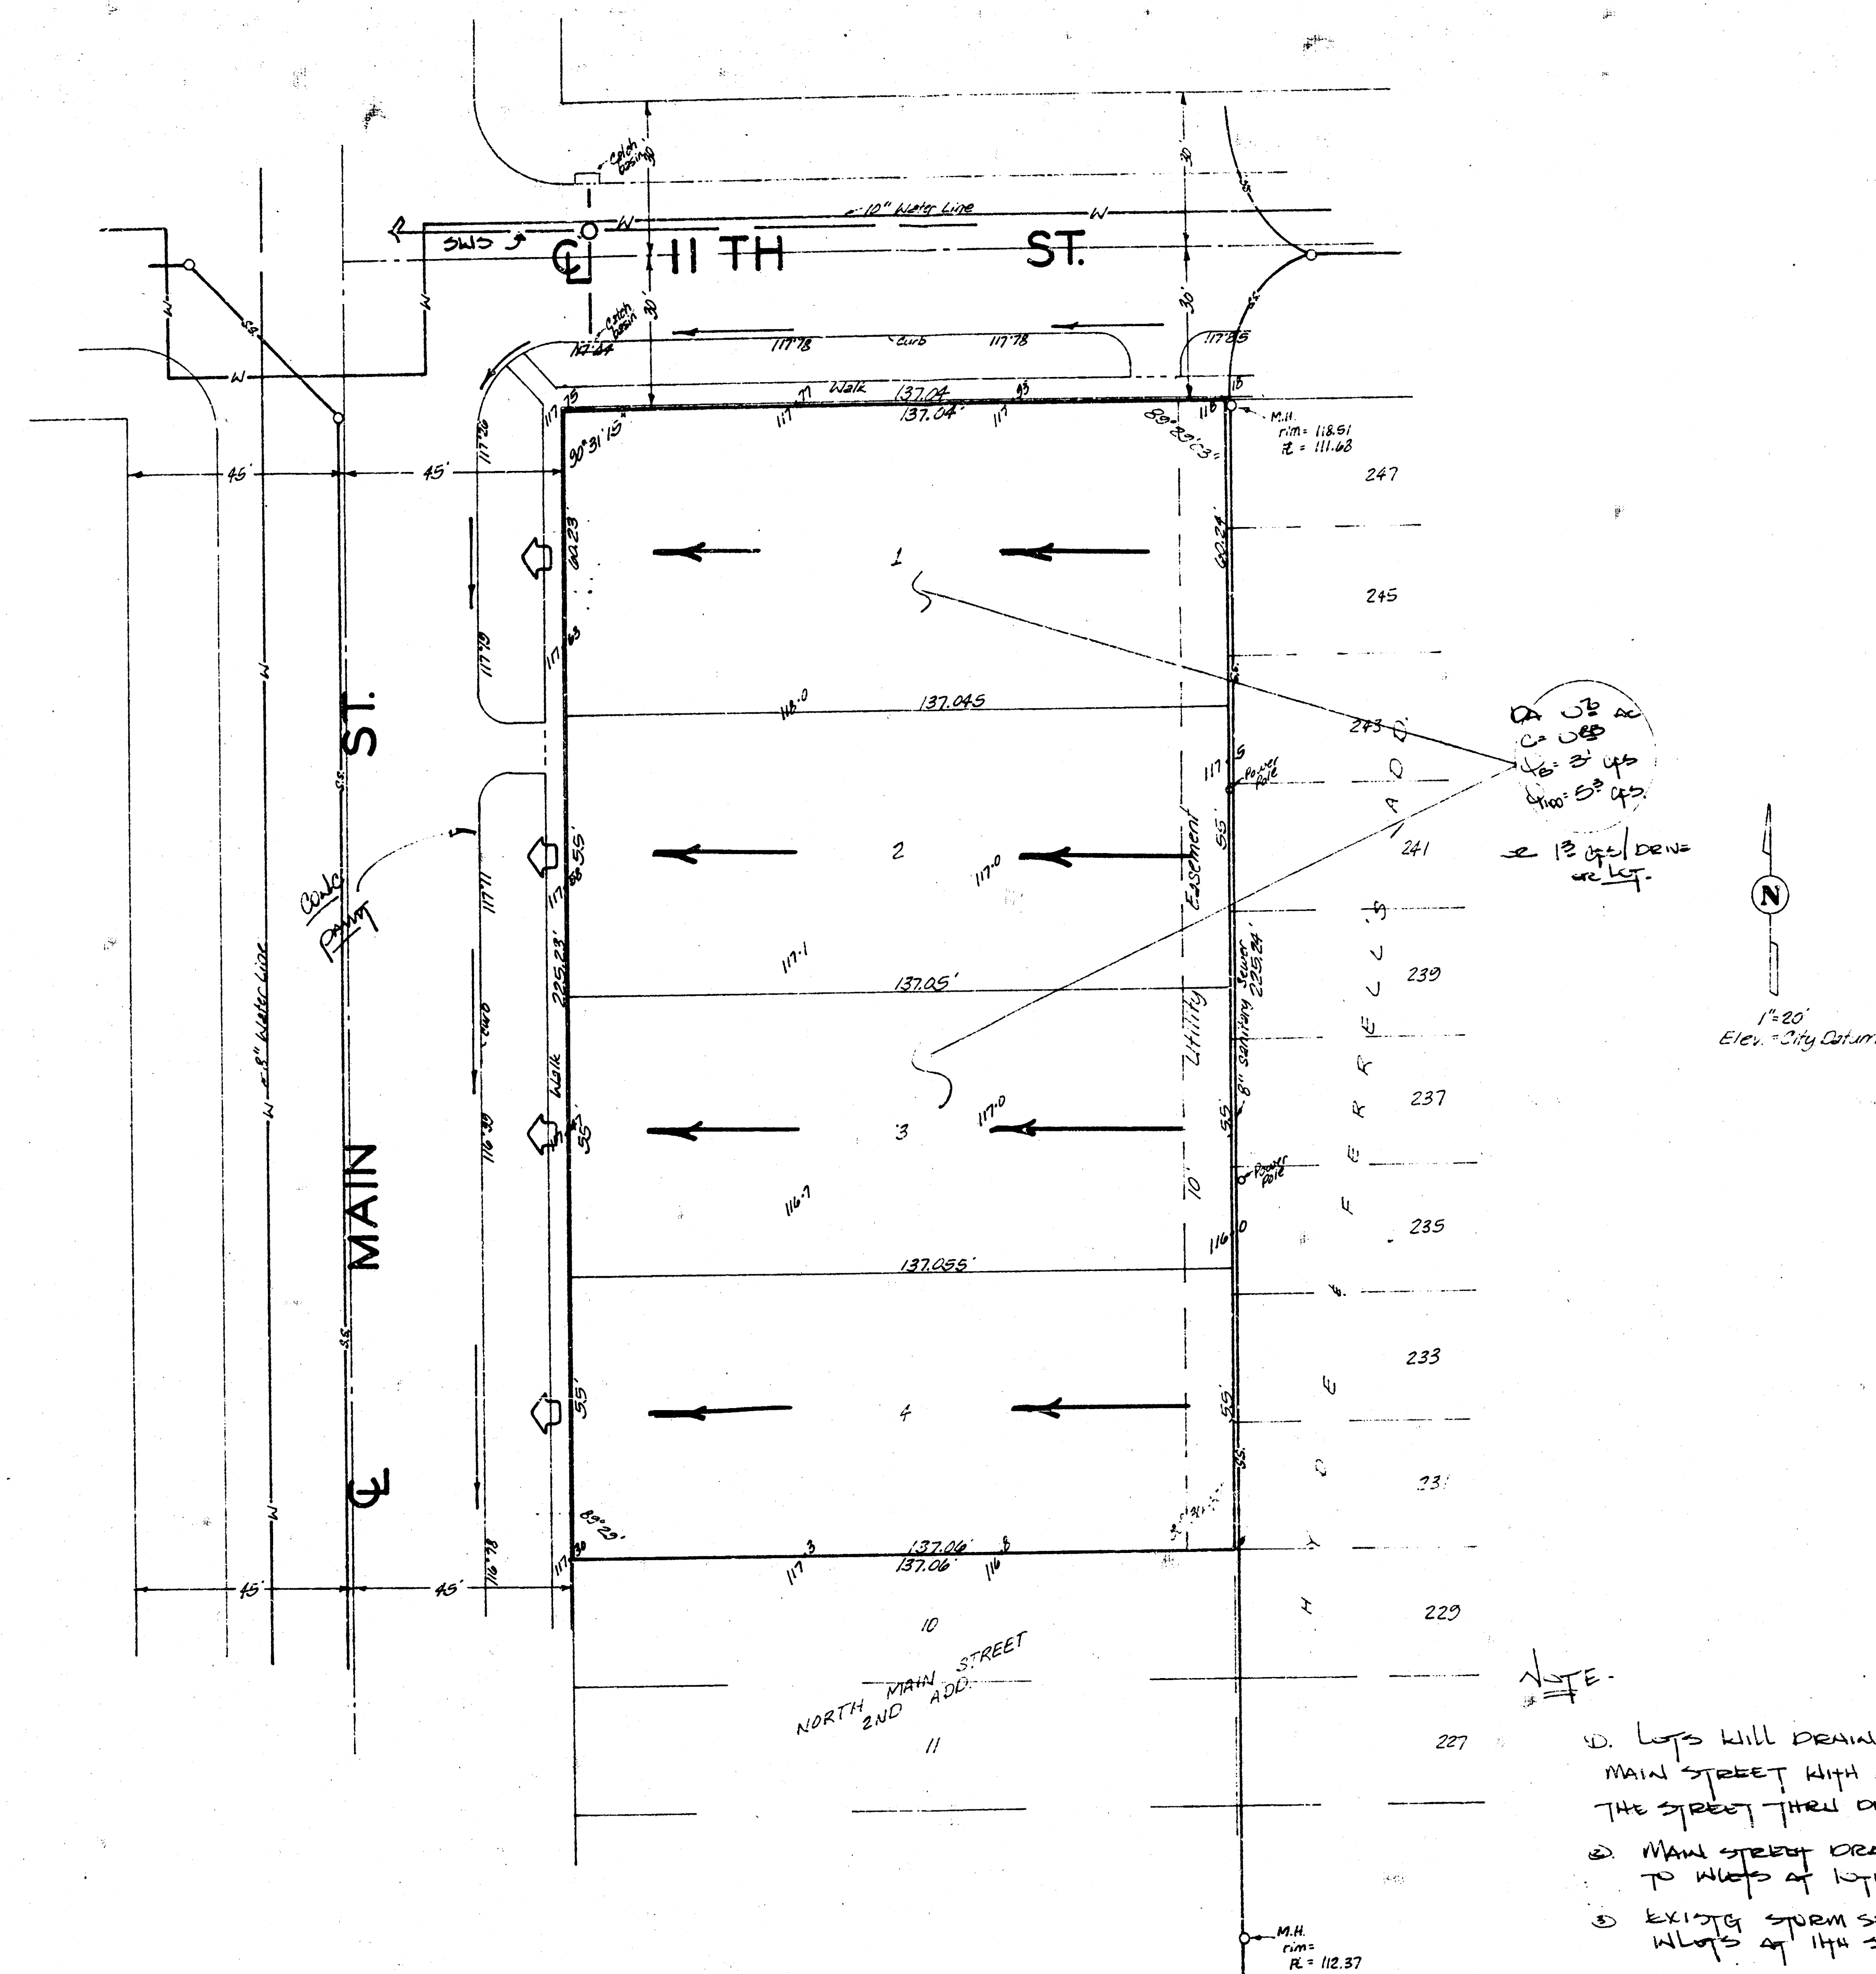

SKETCH PLAT
MIDTOWN 2ND ADDITION

LOT 1, BLOCK 1, NORTH MAIN STREET 3RD
ADDITION TO WICHITA, SEDGWICK COUNTY, KANSAS,
AND LOTS 8 AND 9 ON MAIN ST., NORTH MAIN
STREET 2ND ADDITION TO WICHITA, KANSAS
OWNER: CITY OF WICHITA

FINAL DRAINAGE PLAN

BAUGHMAN COMPANY, P.A.
SURVEYING & ENGINEERING
316-262-7271 • 330 LAURA • WICHITA, KANSAS 67211

4-13-