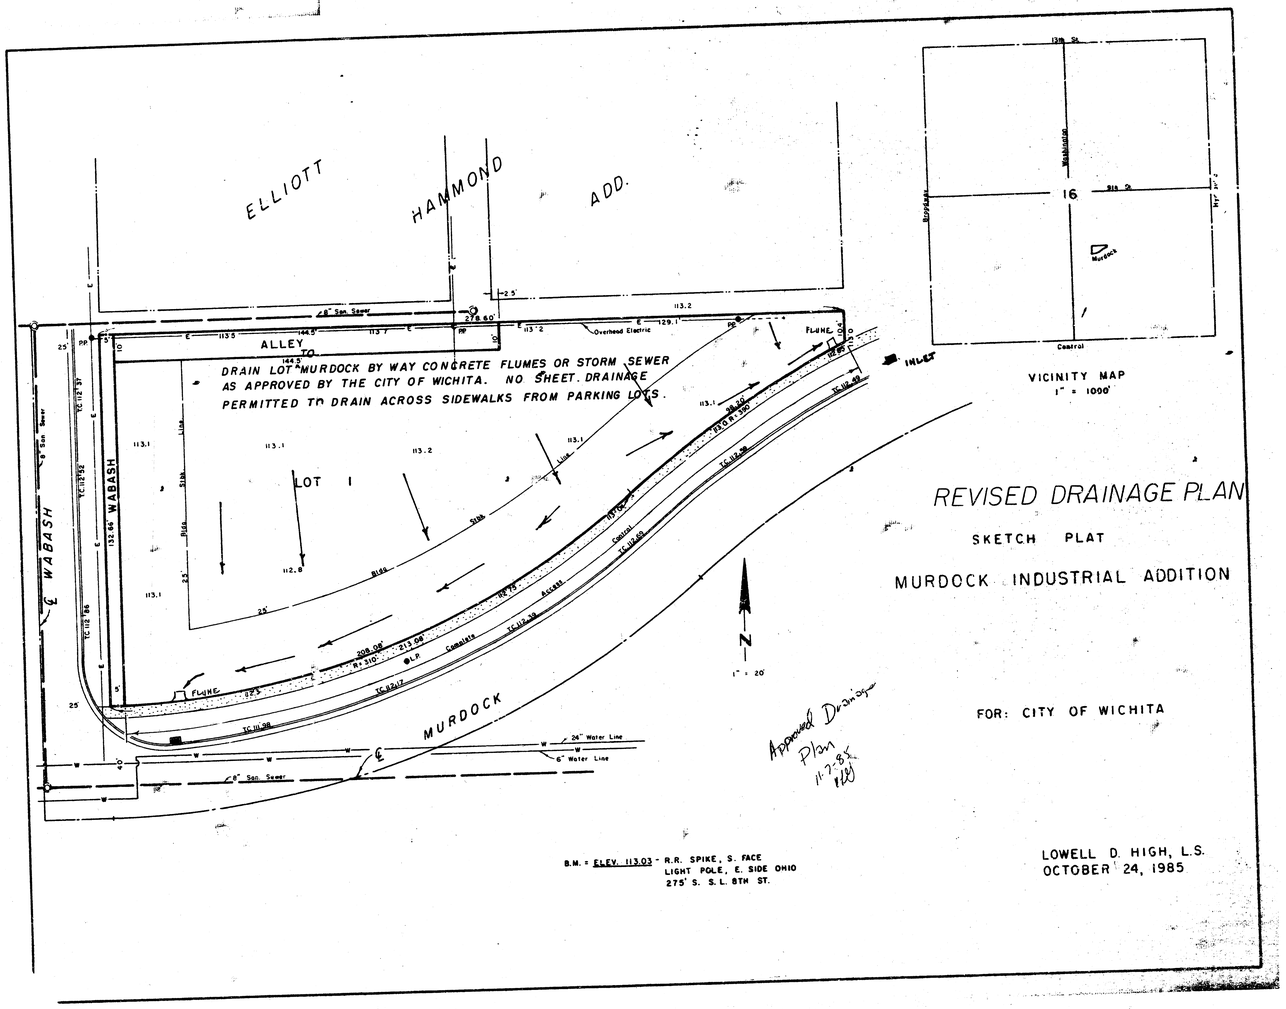MURDOCK INDUSTRIAL ADDITION
(Drainage)