NORTHBOROUGH 4TH ADDITION
(Drainage)

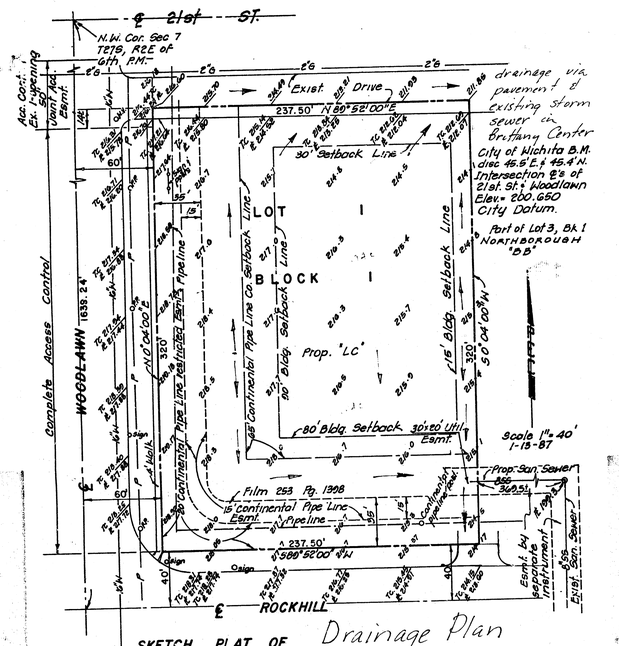

SKETCH PLAT OF Drainage Plan

NORTHBOROUGH 4th ADDITION

Wichita, Sedgwick County, Kansas.

OWNER: BRITTANY DEVELOPMENTS COMPANY
C/O Richard Boushka
500 Fourth Financial Center
Wichita, Ks. 67202

ENGINEER: P.E.C. p.a.
1440 English
Wichita, Ks. 67211

This lot shall be graded to drain via pavement, drives, and the existing storm sewer system.

Does joint lice. Easment allow for drainage?