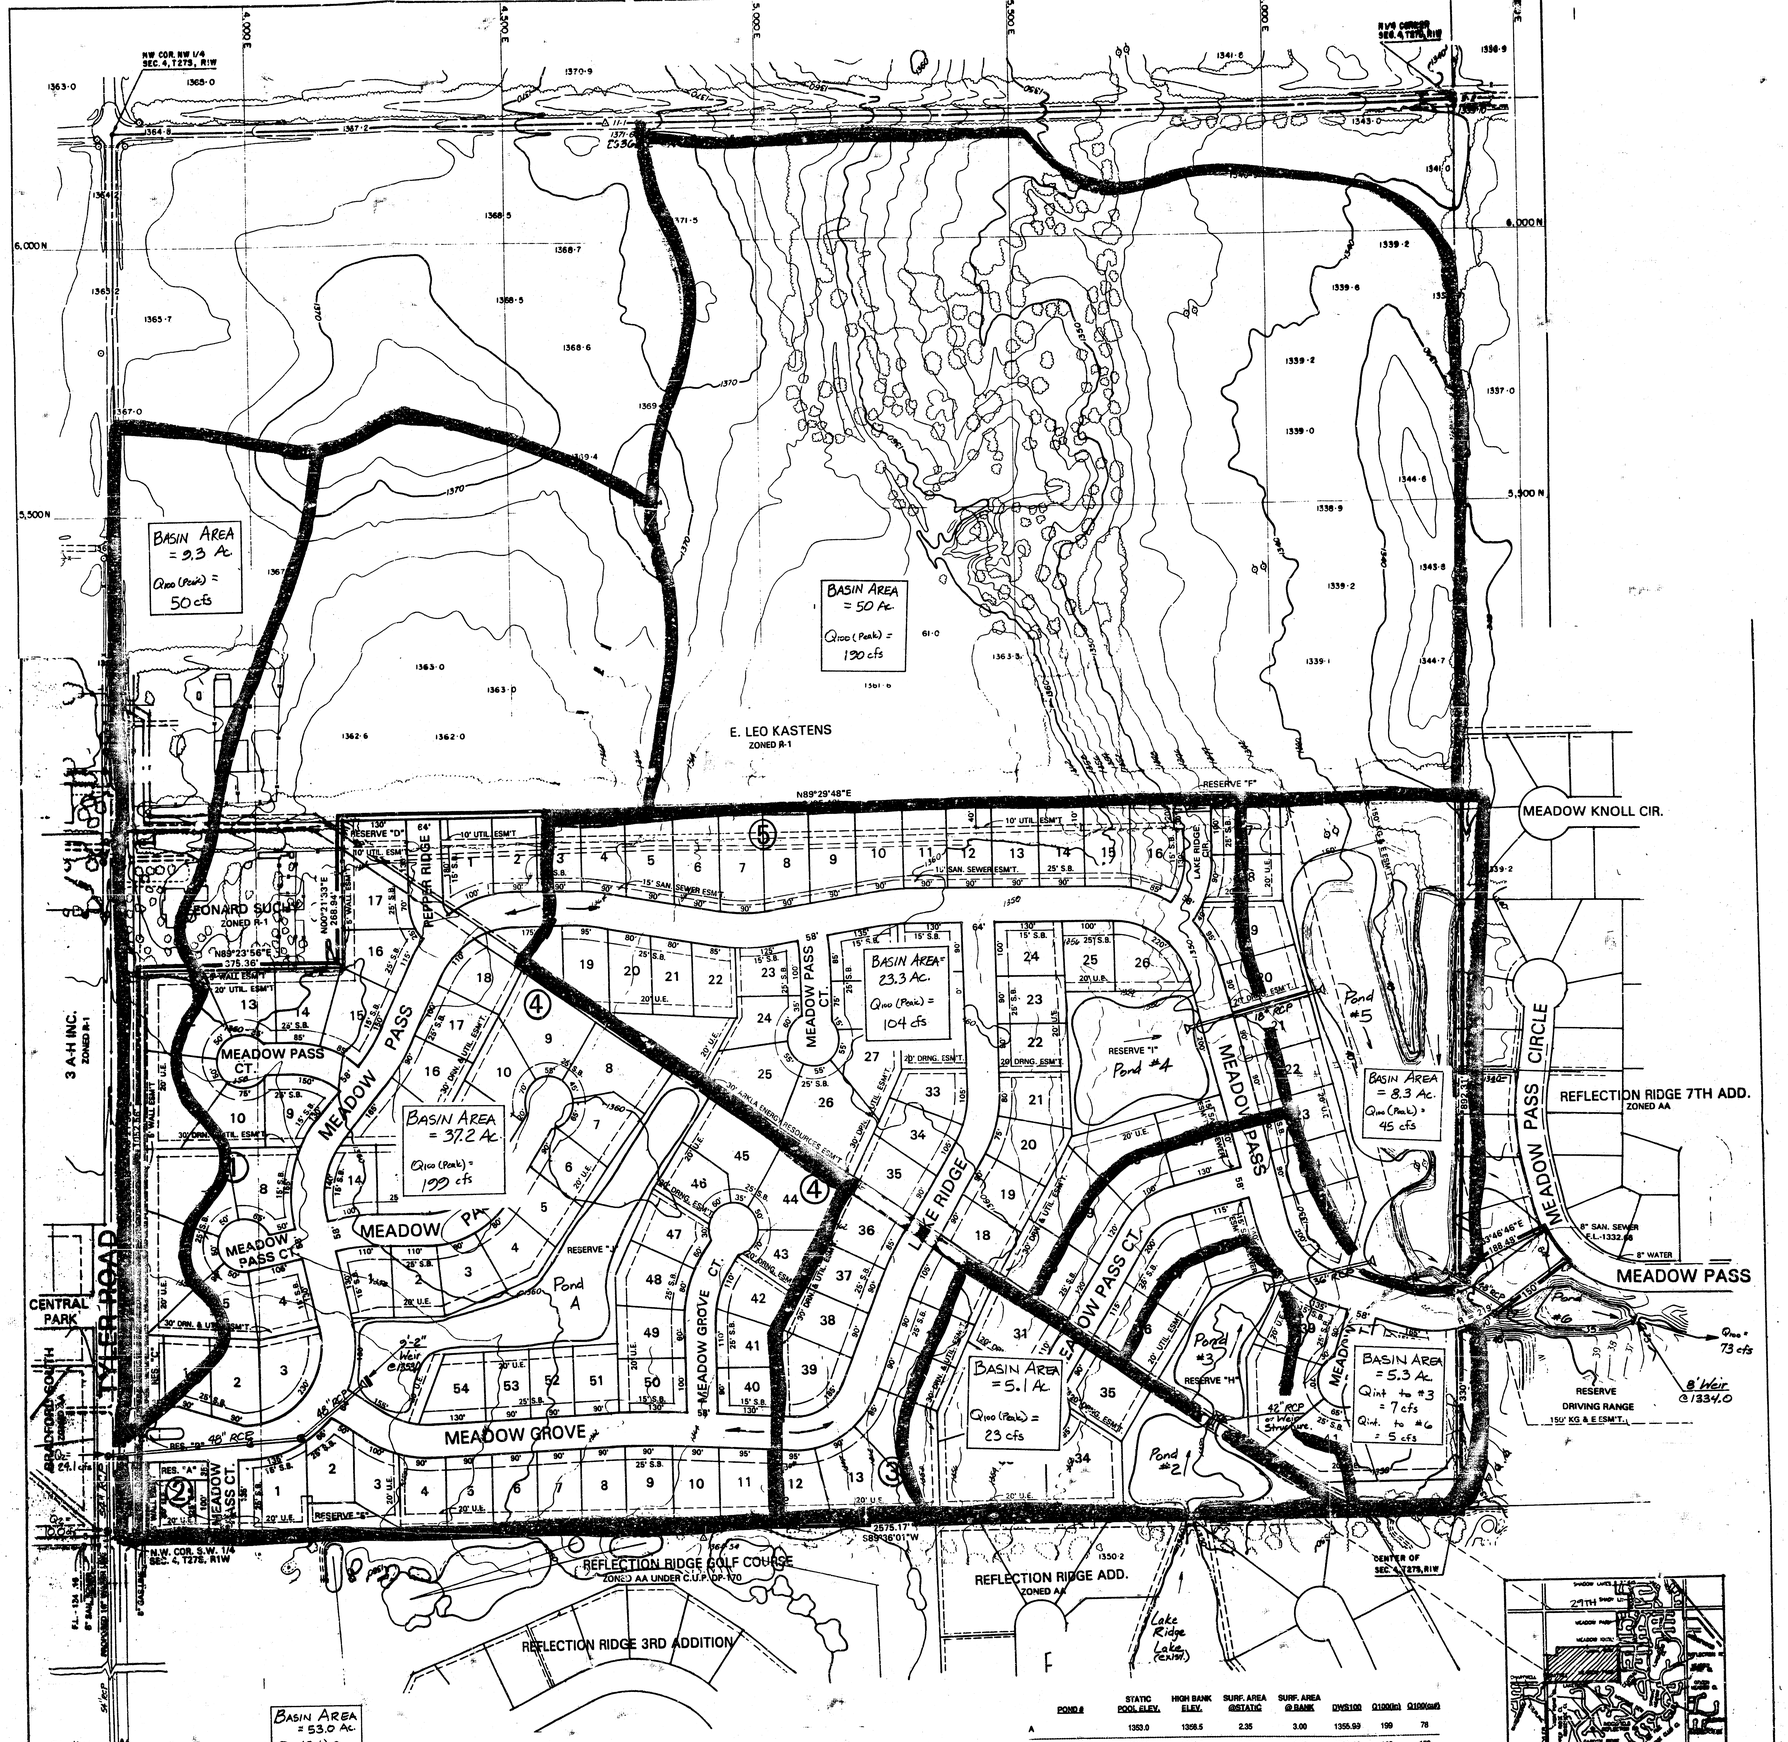

DRAINAGE CONCEPT

POND #	STATIC POOL ELEV.	HIGH BANK ELEV.	SURF. AREA @STATIC	SURF. AREA @ BANK	DWS100	Q1000(in)	Q100(out)
A	1353.0	1358.5	2.35	3.00	1355.99	199	78
B	1350.0	1352.5	1.00	1.35	1351.69	169	158
Ster. Farms 2nd # 1 & 2	1348.5	1351.5	No Change	No Change	1349.84	423	330
2	1345.4	1349.0	1.30	1.90	1348.65	172	79
3	1339.0	1346.0	0.40	0.70	1343.59	89	69
4	1345.0	1349.0	0.90	1.40	1348.51	104	18

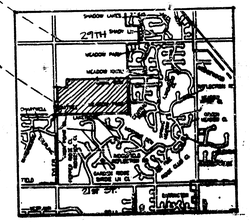

LOCATION MAP