


PEMBROOK

AN ADDITION, TO WICHITA, SEDGWICK COUNTY, KANSAS

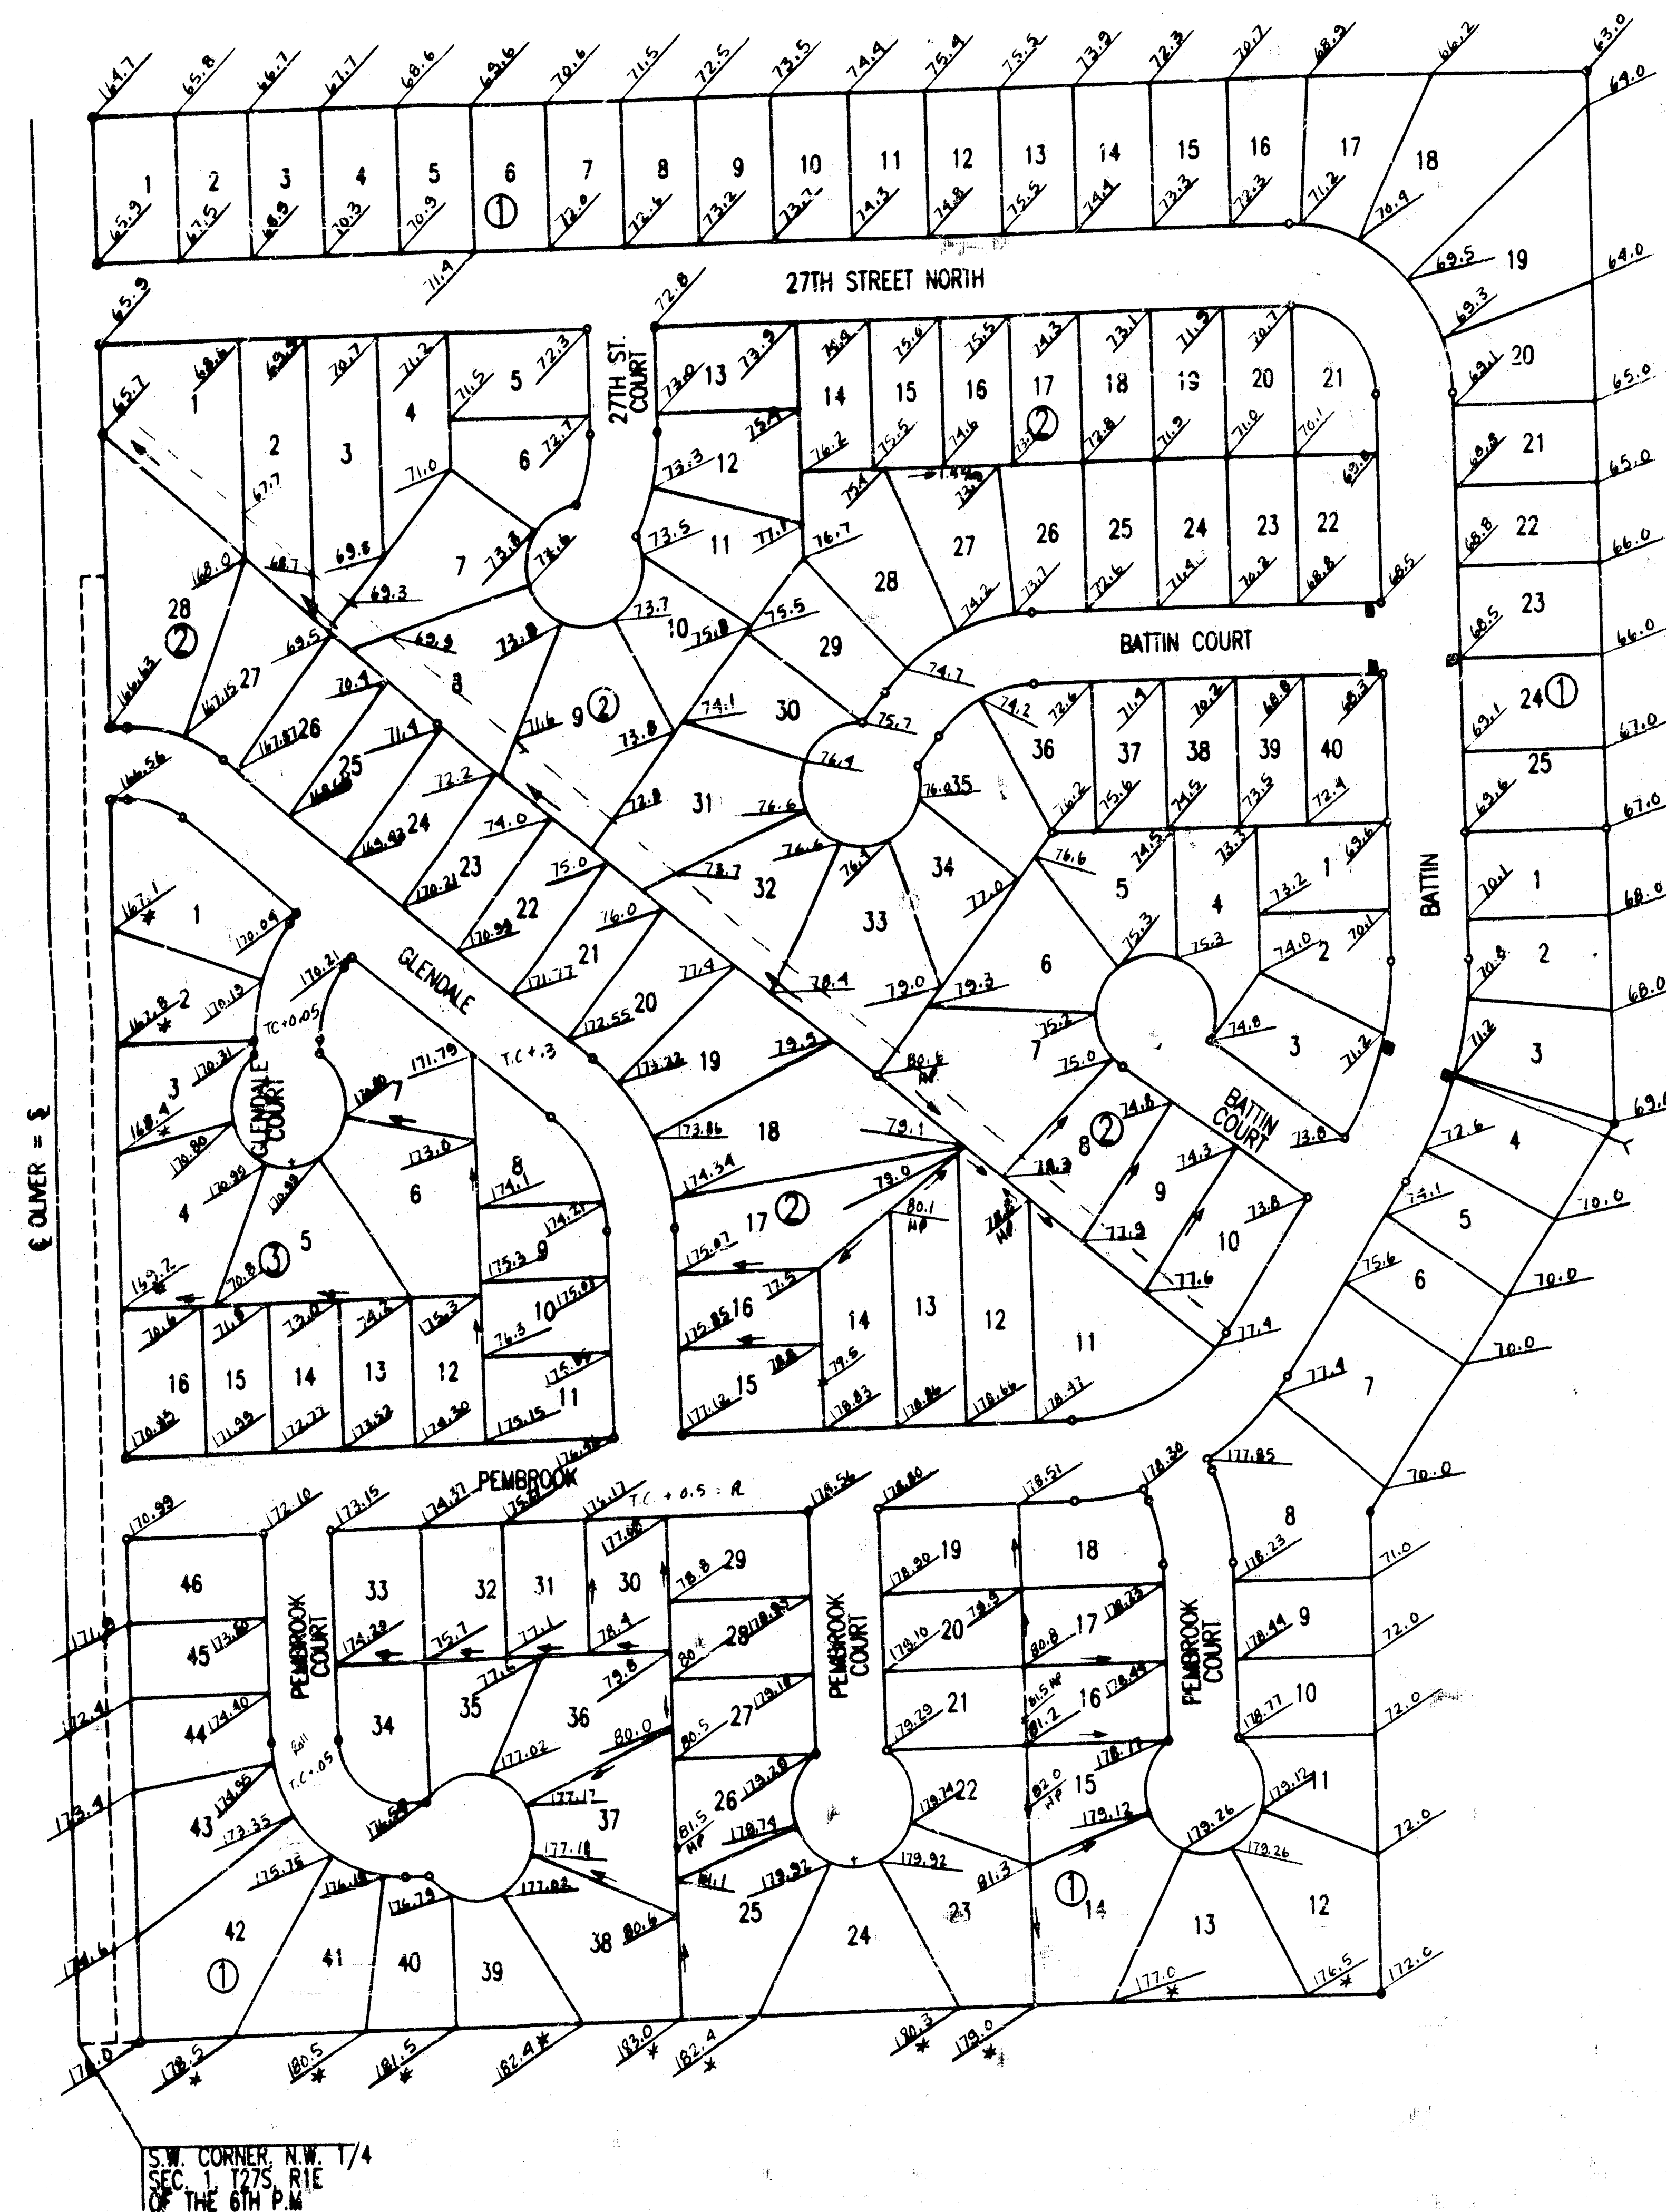

SCALE: 1"=100'

• = IRON SET

• = IRON FOUND

CALC. MEAS. = CALCULATED FROM MEASUREMENT

MEAS. = MEASURED

S.S. = SANITARY SEWER

B.S.L. = BUILDING SETBACK LINE

B.M. - DISC 29' NORTH AND 33' EAST OF
CENTERLINE OLIVER AND 29TH STREET
NORTH.
ELEV.=159.68 CITY DATUM

B.M. - RAILROAD SPIKE IN S.W. FACE OF
POWER POLE 26.5' NORTH OF 1/16
CORNER, 1/4 MILE EAST OF 29TH
STREET NORTH AND OLIVER.
ELEV.=161.18 CITY DATUM

MINIMUM PAD ELEVATION (LOWEST OPENING) AS
FOLLOWS:

BLOCK 1	ELEV. 167.00	CITY DATUM
LOT 1	ELEV. 168.00	CITY DATUM
LOT 2	ELEV. 169.00	CITY DATUM
LOTS 3 AND 4	ELEV. 170.00	CITY DATUM
LOTS 5 THROUGH 7	ELEV. 171.00	CITY DATUM
LOTS 8 AND 9	ELEV. 172.00	CITY DATUM
LOTS 10 THROUGH 12	ELEV. 173.00	CITY DATUM

THIS ADDITION IS SUBJECT TO THE REQUIREMENTS
OF THE BEACON HILL, C.U.P., DP-147 ON FILE
WITH THE METROPOLITAN AREA PLANNING
DEPARTMENT.

* Match Existing Elevation

Pembroke & Pembroke 2nd

APPROVED
SURVEY PLAN

Revised 7-27-98 KER

234 A