


PHelps ADDITION
(Drainage)

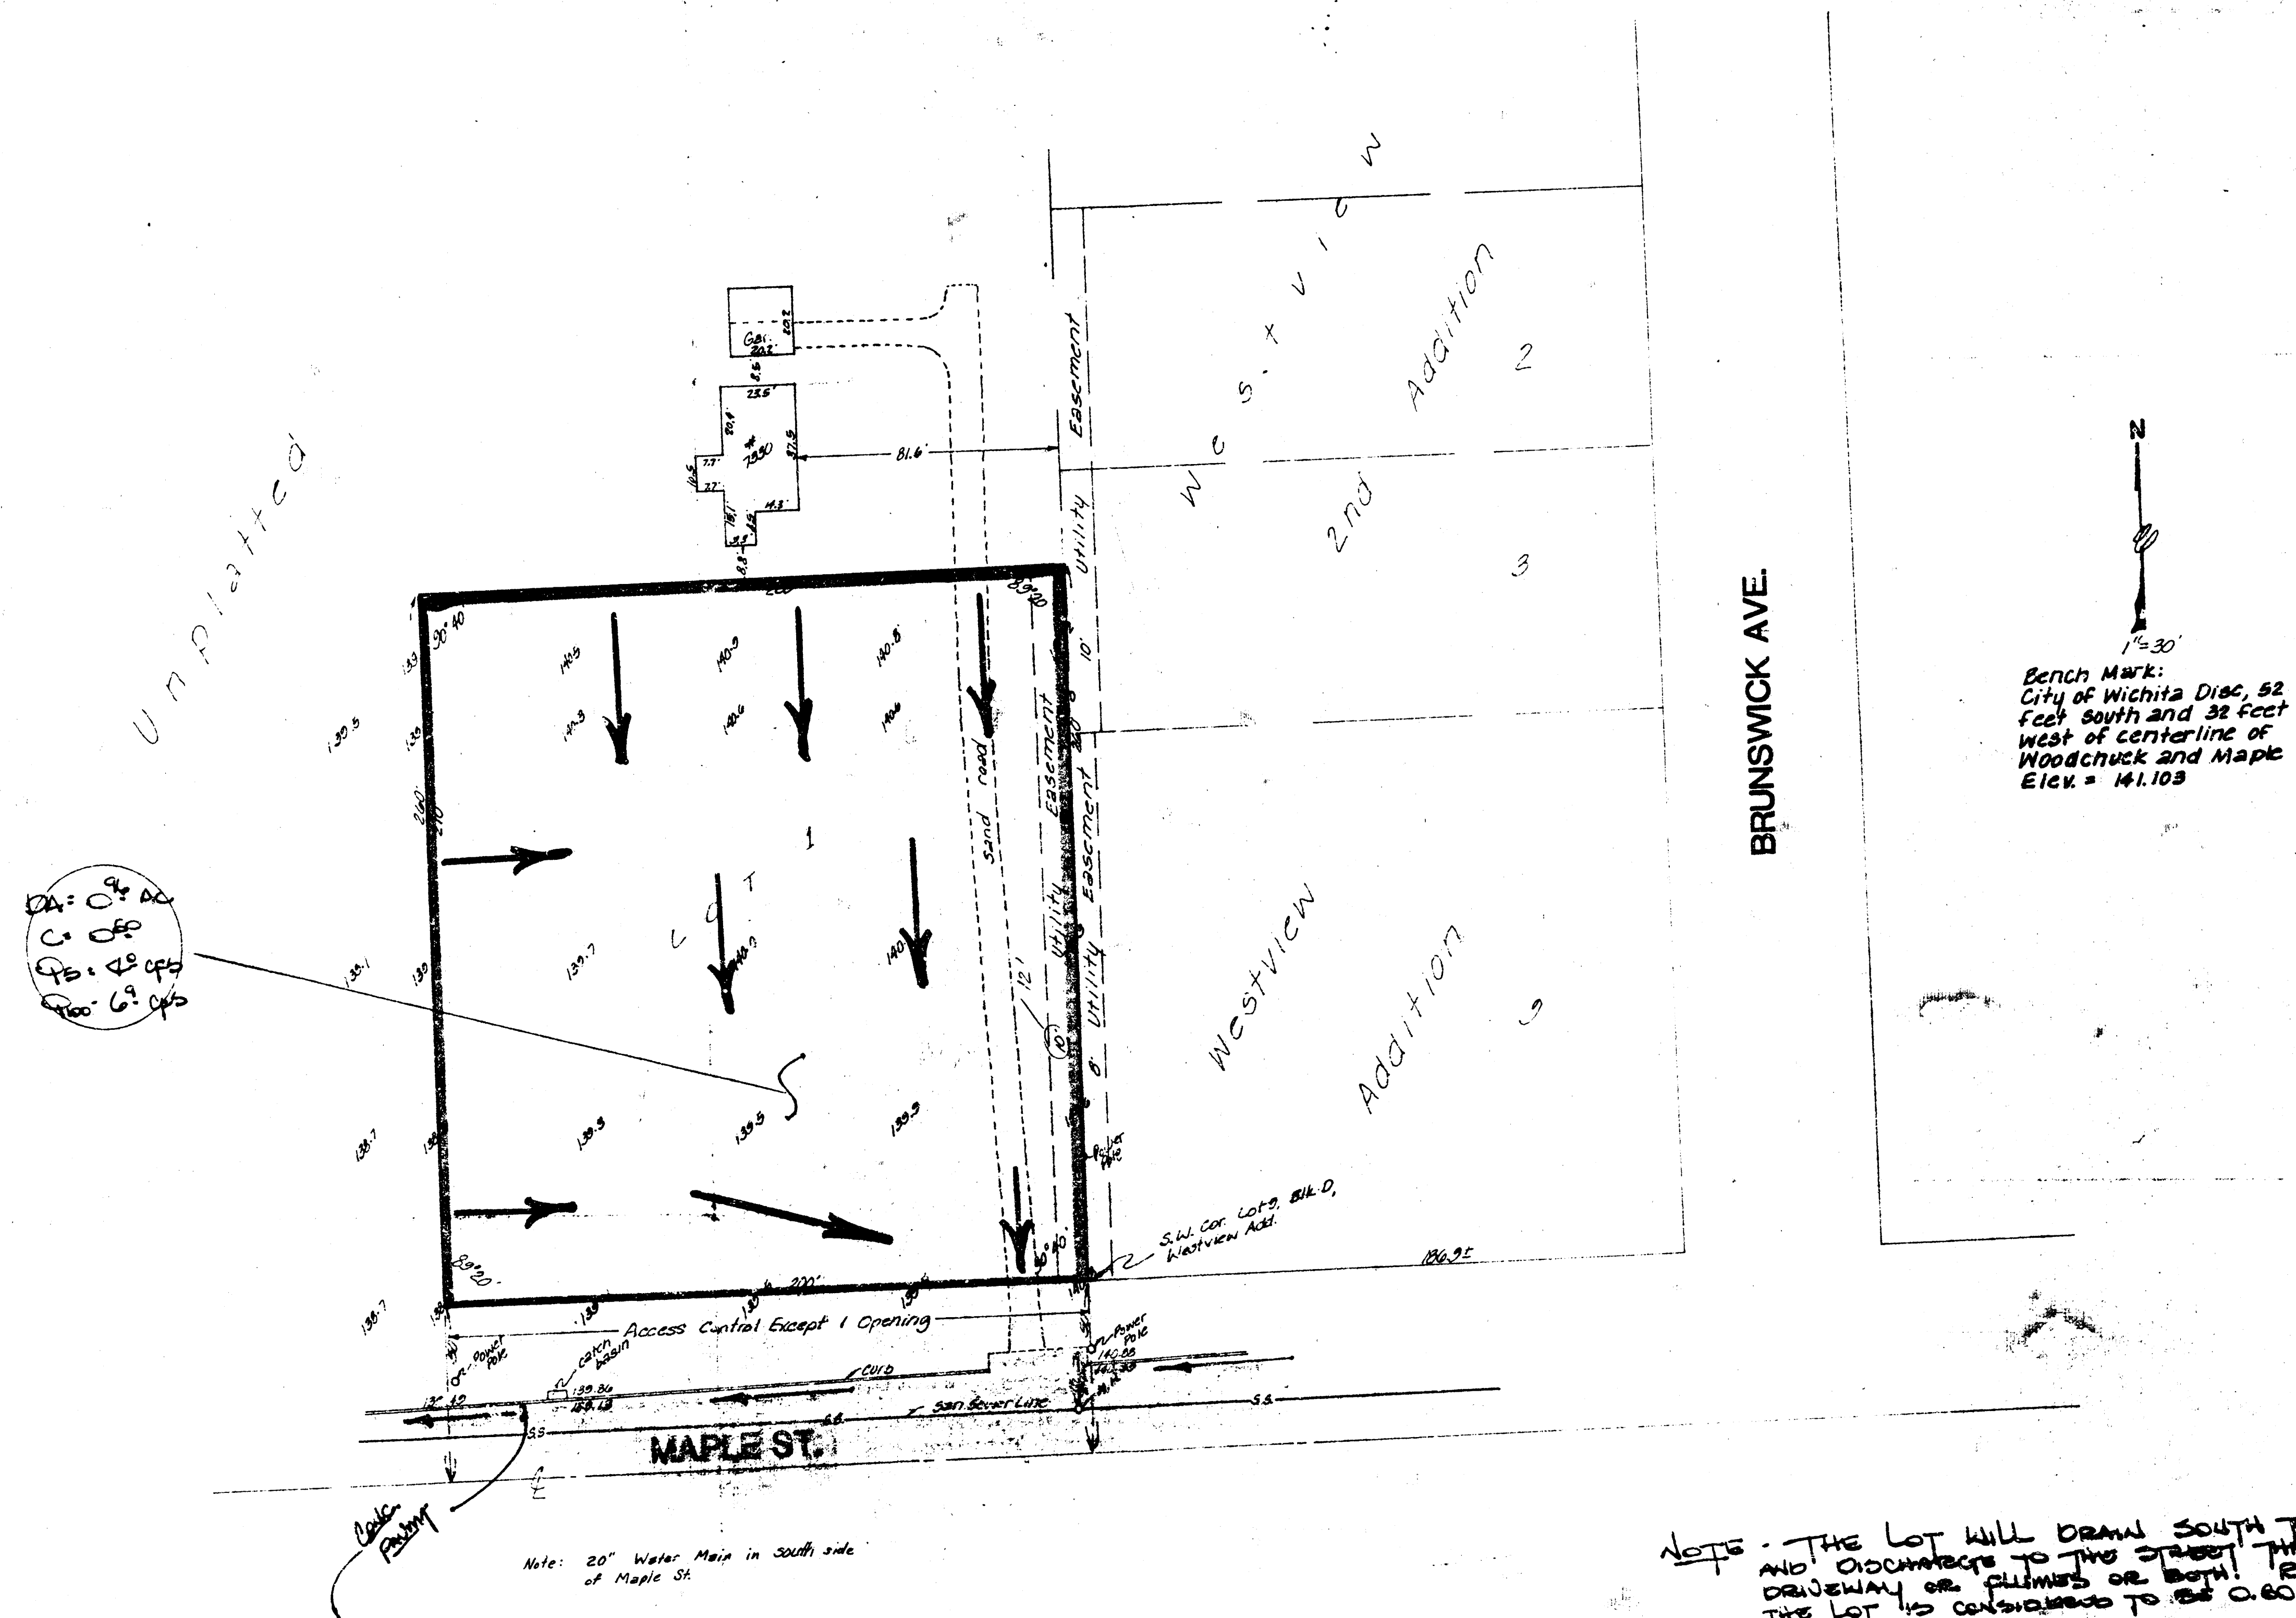

DRAINAGE PLAN