


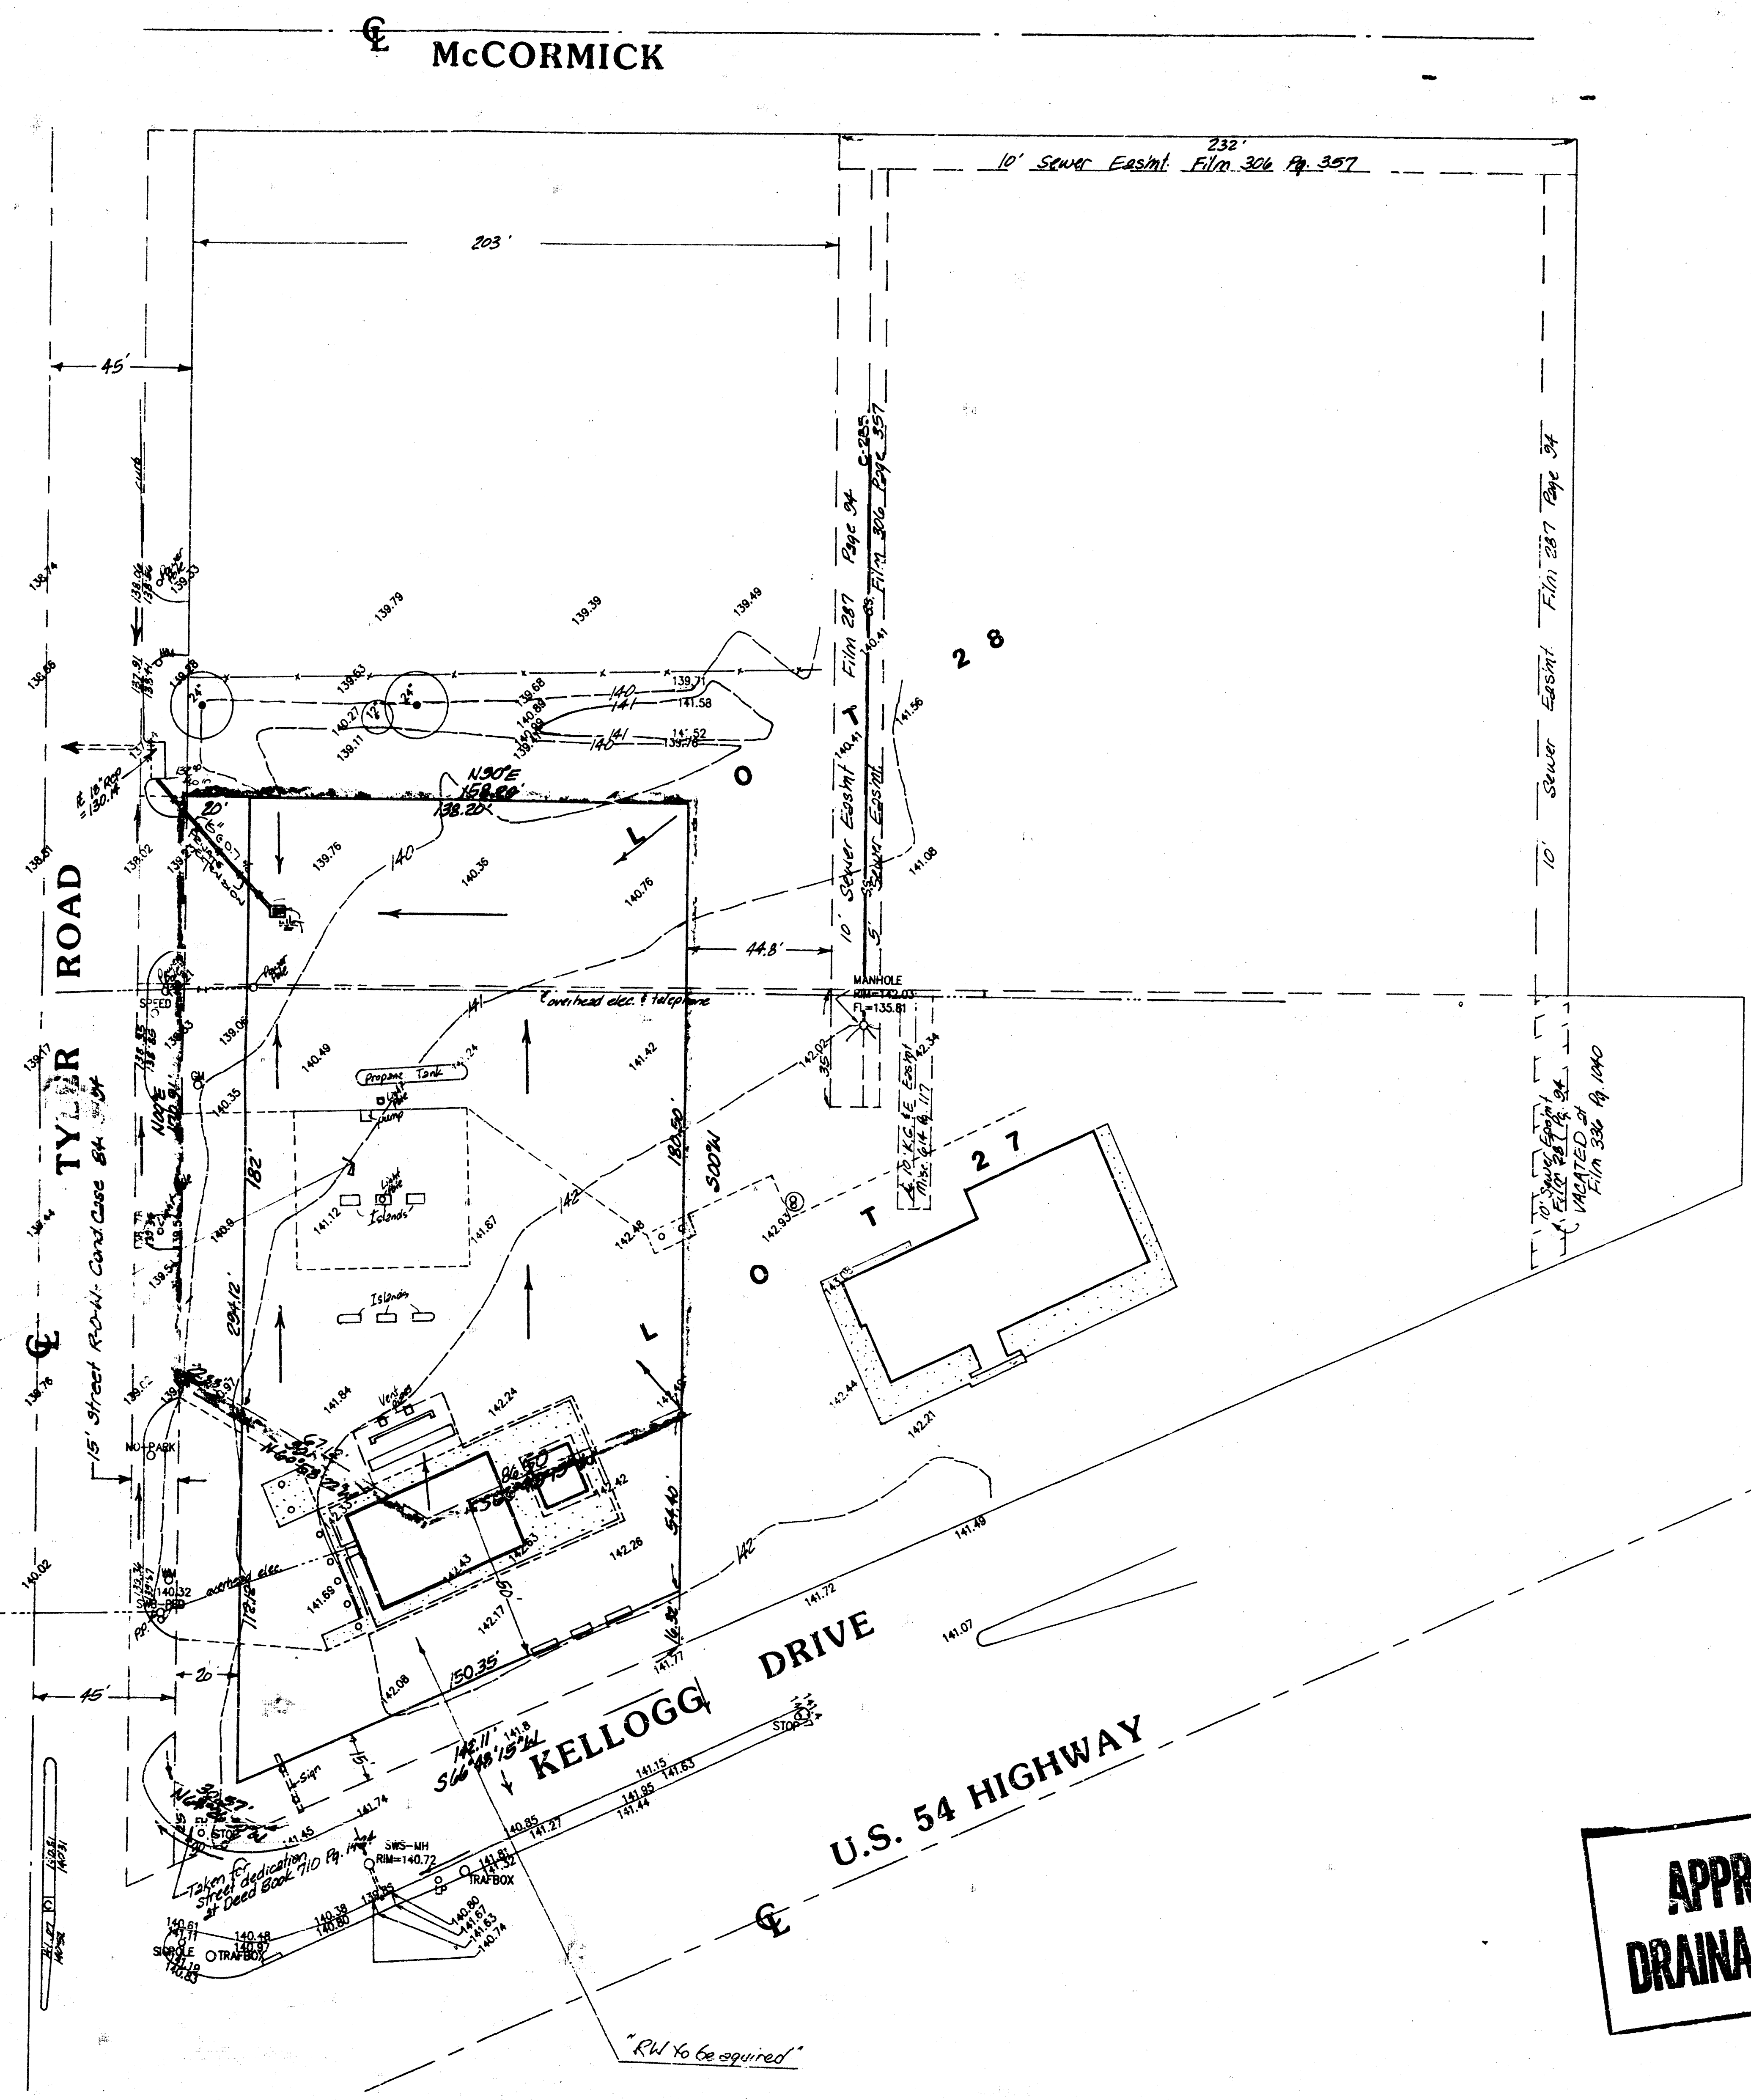

Bench mark:
Chiseled square on top of curb
east side inlet, north side of
Kellogg frontage road on south
side of U.S. 54, approx 330' west
of Tyler
Elev. = 135.35 City Datum

**APPROVED
DRAINAGE PLAN**

Phillips 66 Center - Tyler
Add'n
DRAINAGE PLAN