


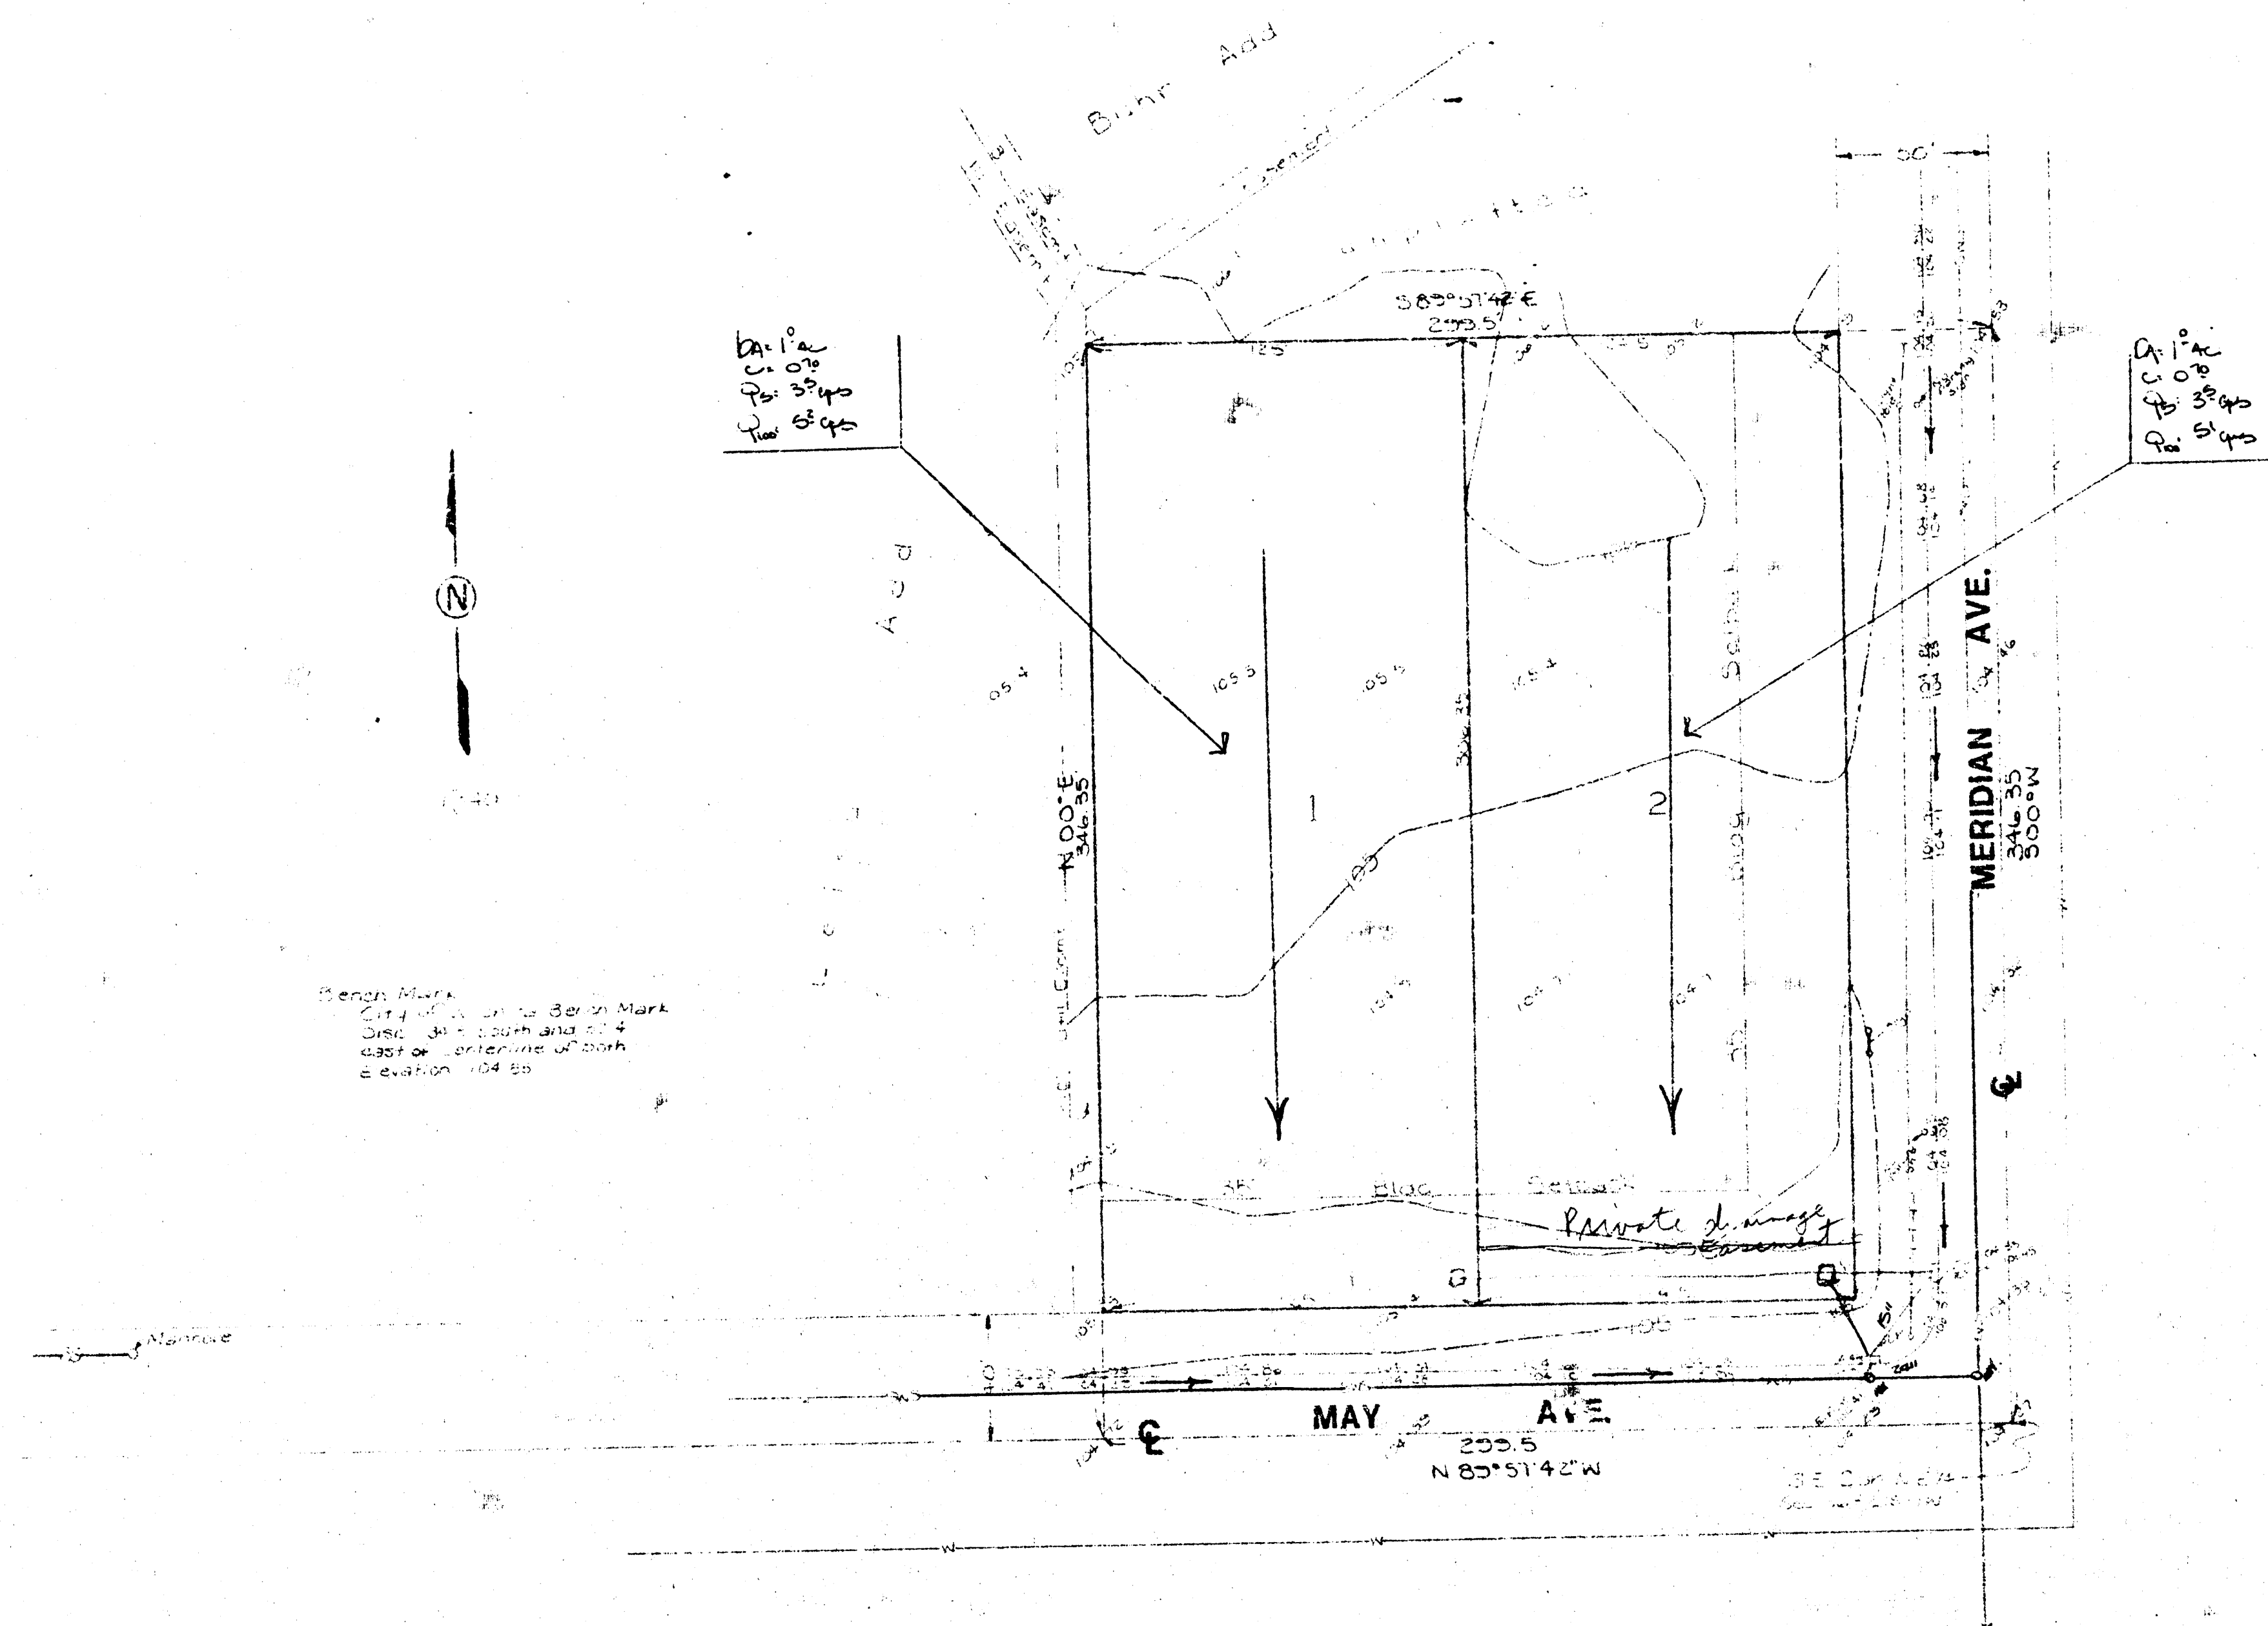

SKETCH PLAT

Q-TECH ADDITION

THE SOUTH 346.35 FEET OF THE EAST 299.5 FEET OF THE S.E. 1/4 OF THE N.E. 1/4 OF SEC. 36, TWP. 27-S, R-1-W OF THE 6TH P.M., SEDGWICK COUNTY, KANSAS, EXCEPT THE SOUTH 40 FEET AND THE EAST 50 FEET FOR STREET

OWNER: MID AMERICA DAIRYMEN

DRAINAGE PLAN

HB BAUGHMAN COMPANY, P.A.
SURVEYING & ENGINEERING
31822-7271 • 315 ELLIS • WICHITA, KANSAS 67211