


Quik Trip 2nd

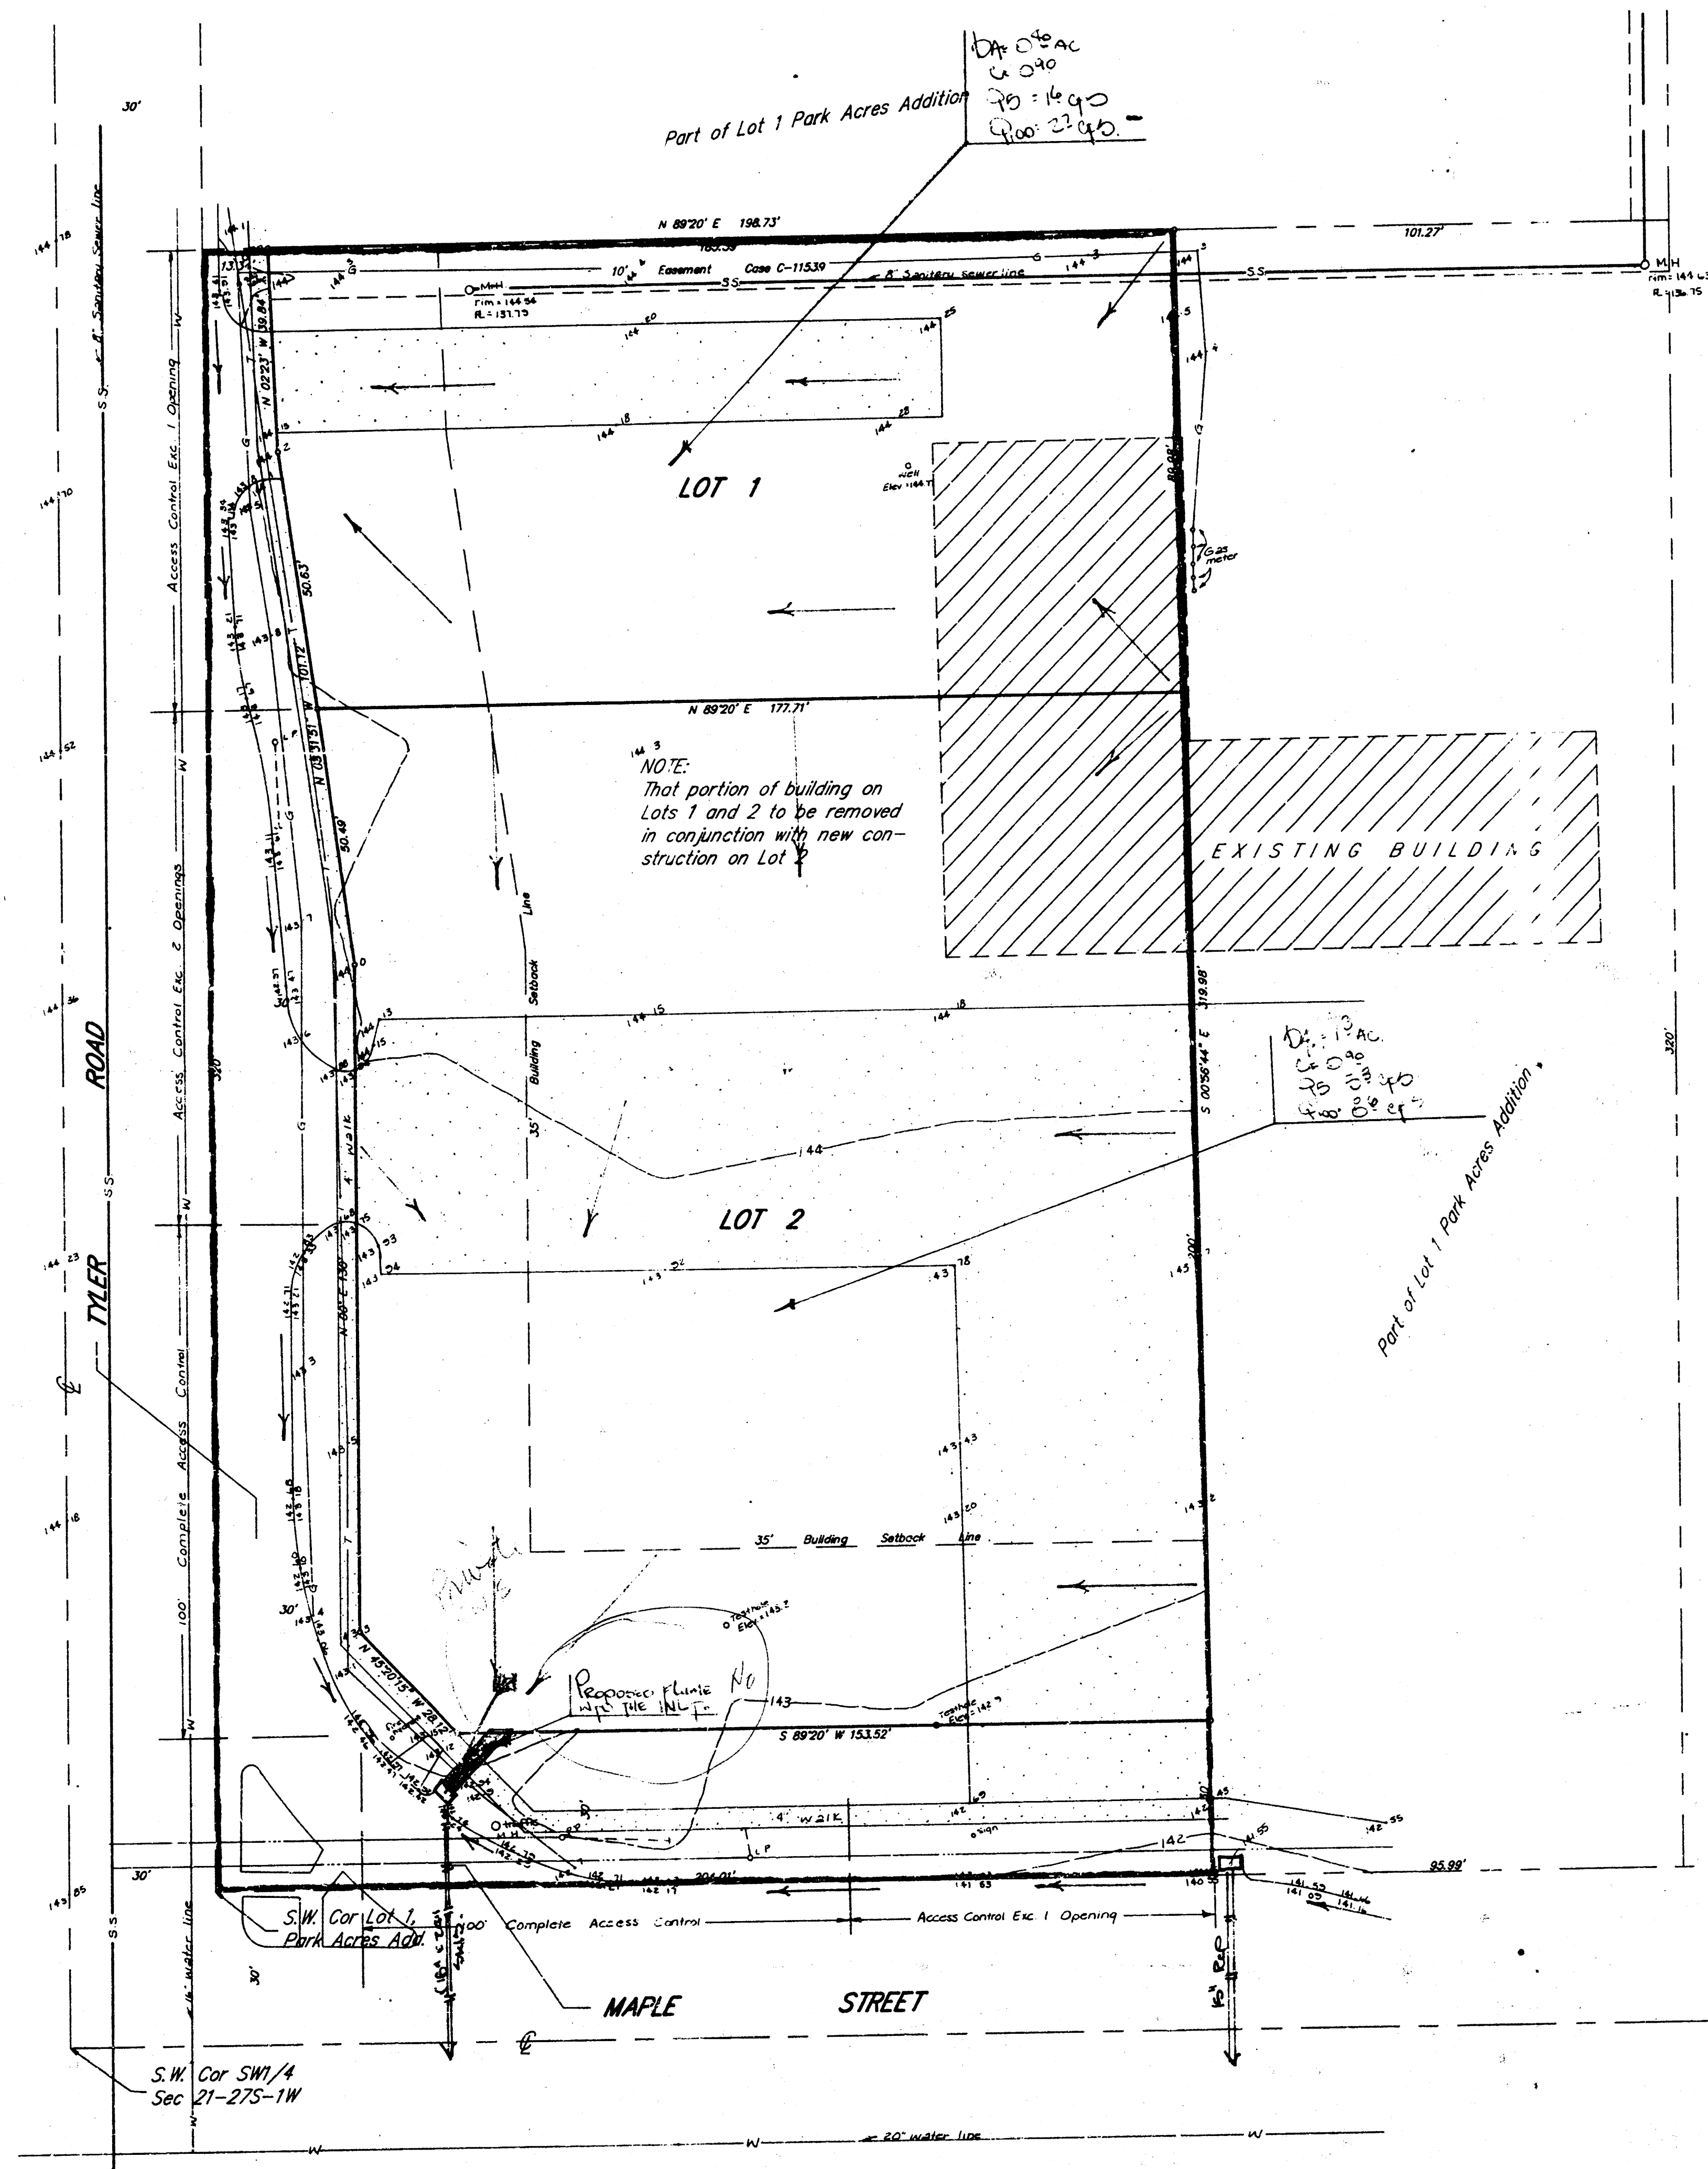

SKETCH PLAT
QUIKTRIP 2ND ADDITION
 WICHITA, SEDGWICK COUNTY, KANSAS

Part of Lot 1, Park Acres Addition, Sedgwick County, Kansas.

RON GROVES

DRAINAGE PLAN