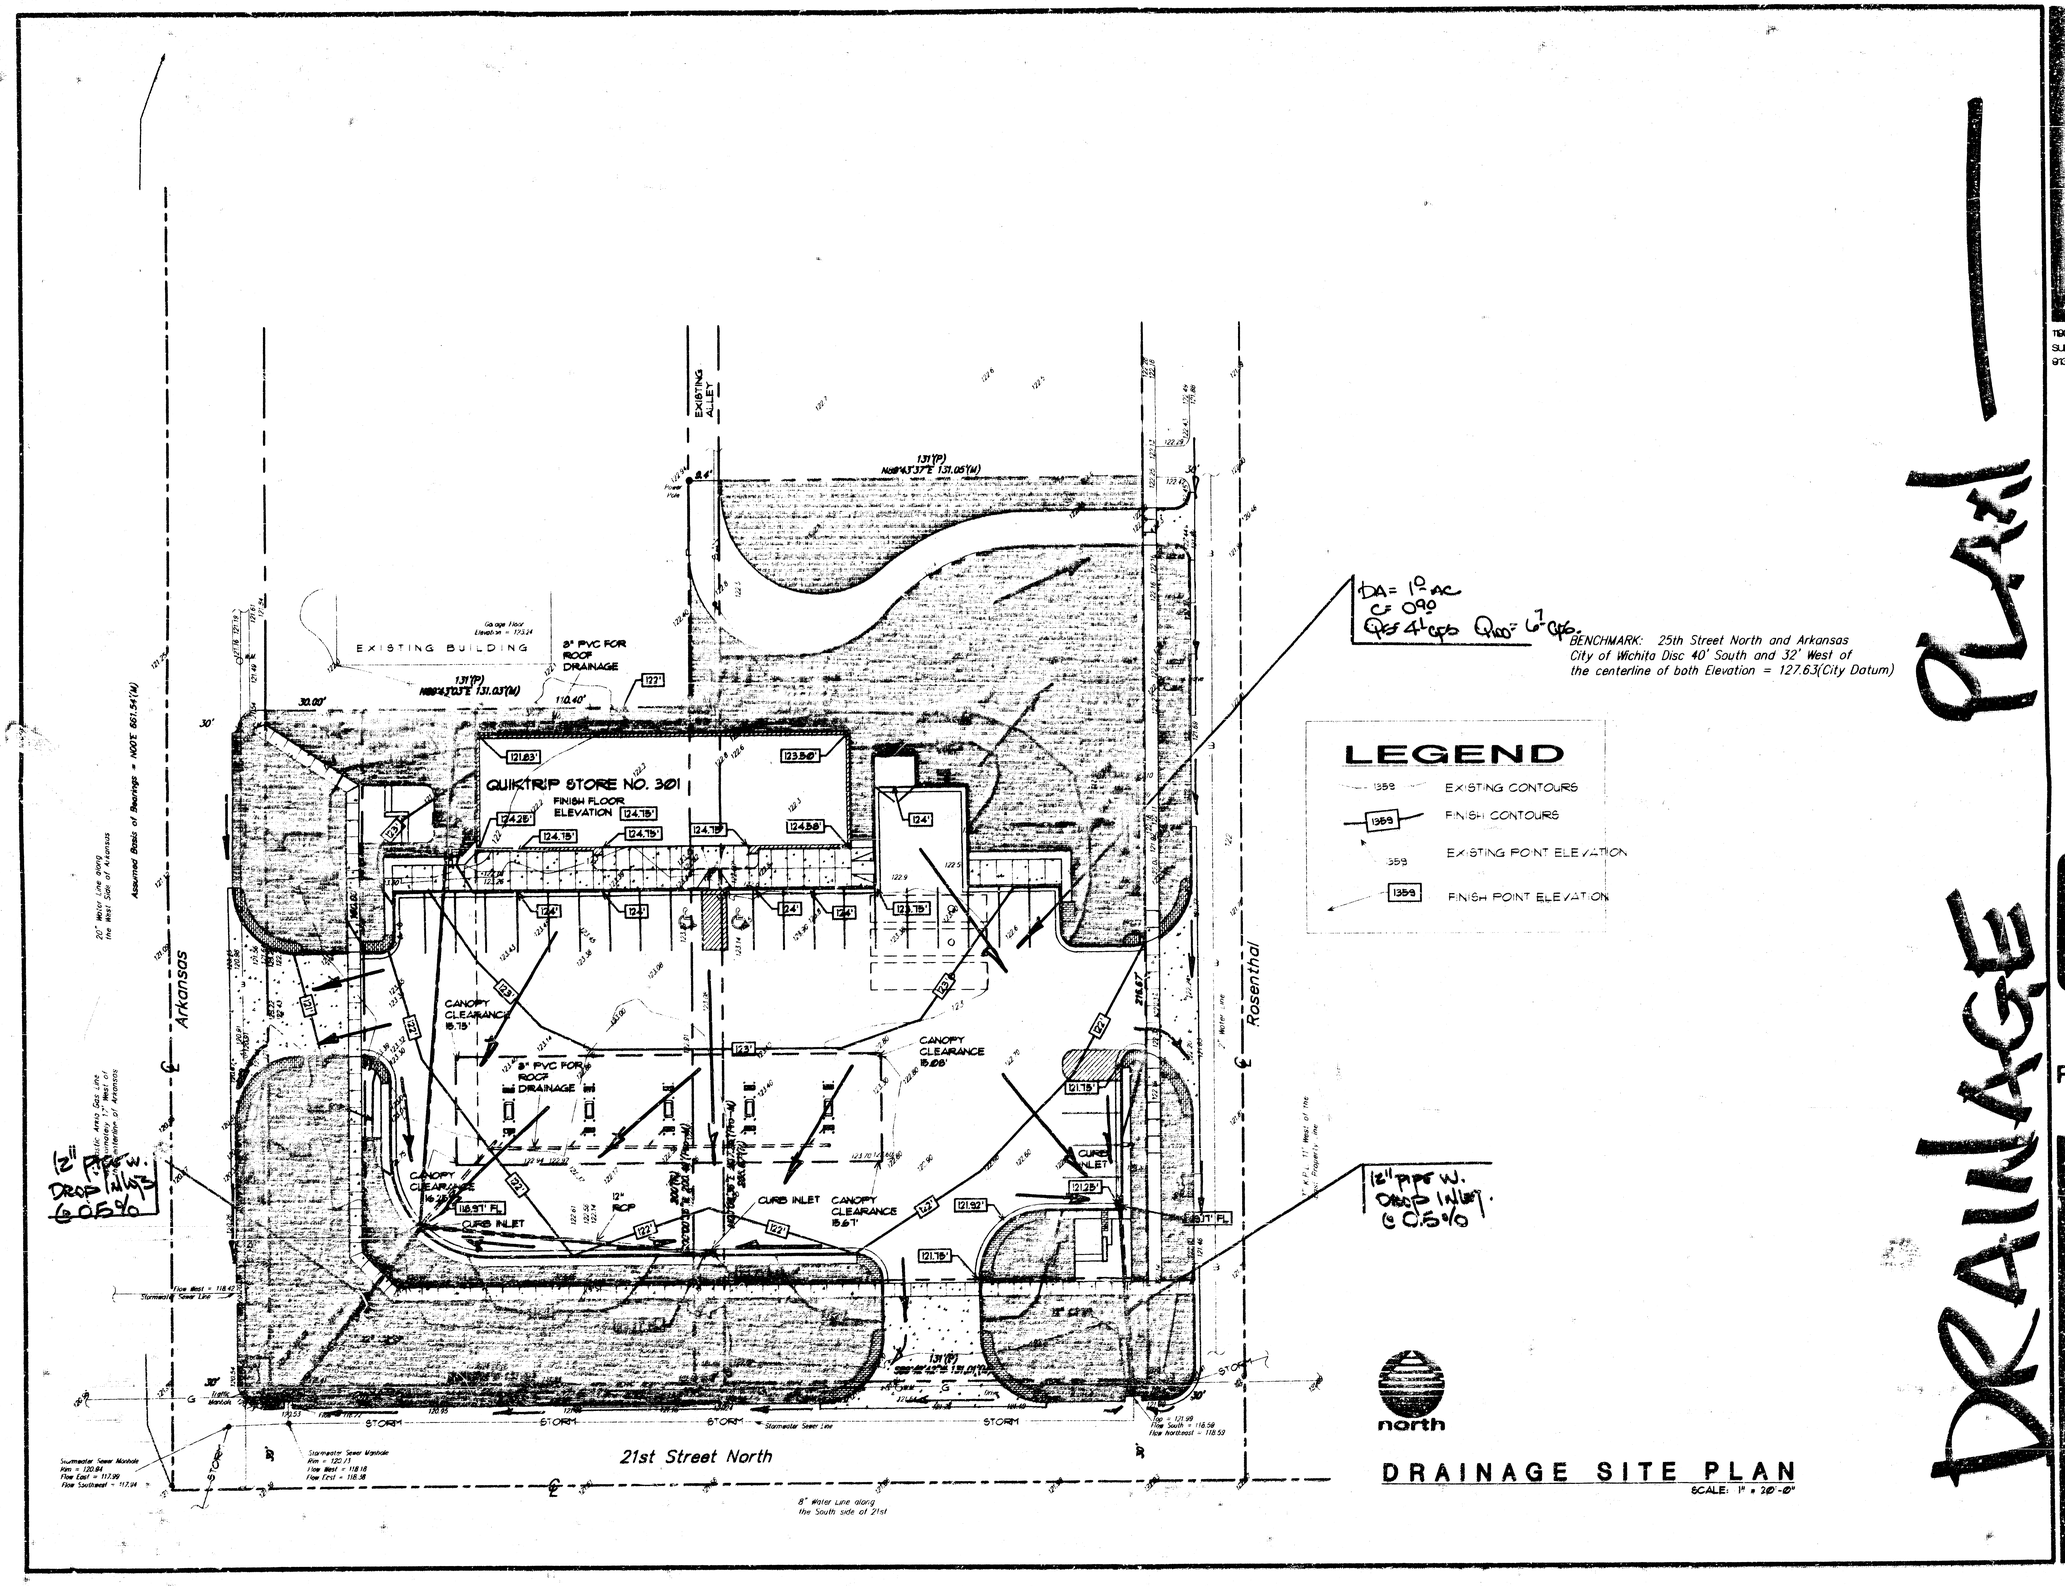
EXISTING BUILDING
QUIKTRIP STORE NO. 301
FINISH FLOOR ELEVATION
CANOPY CLEARANCE
CURB INLET
21st Street North
Arkansas
Rosenthal
STORM
north
DA = 1.0 ac
C = 0.90
Q25 = 4.1 cfs Q100 = 6.7 cfs
BENCHMARK: 25th Street North and Arkansas City of Wichita Disc 40' South and 32' West of the centerline of both Elevation = 127.63(City Datum)
12" pipe w. drop inlet @ 0.5%
LEGEND
EXISTING CONTOURS
FINISH CONTOURS
EXISTING POINT ELEVATION
FINISH POINT ELEVATION
DRAINAGE SITE PLAN
SCALE: 1" = 20'-0"
DRAINAGE PLAN
HOLLOWAY ARCHITECTS
11800 WEST 87TH STREET PARKWAY
SUITE 150, LENEXA, KANSAS 66215
913-894-0707 FAX 913-894-9291
QUIKTRIP NO. 301
21ST ST. & ARKANSAS
WICHITA, KANSAS
QuikTrip
PRELIMINARY
FILE GT30 DWG
REVISIONS
DATE 6/8/95
SHEET NUMBER
2