Rebecca

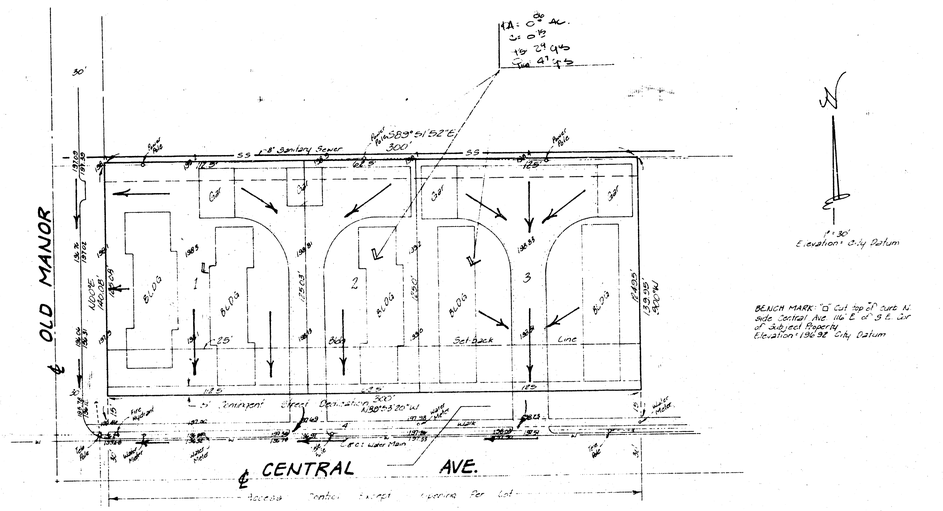

SKETCH PLAT

REBECCA ADDITION

REPLAT OF LOTS 27, 28, 29, 30, 31, 32, 33, 34, 35, 36, 37 & 38, BLOCK 12, EAST HIGHLANDS, AND A PORTION OF STREET R-O-W

OWNER: **DEAN L. BUSSART** (PROPOSED LOTS 1 AND 3)
REBECCA B. BUSSART

C. D. SMITH (PROPOSED LOT 2)
H. E. SMITH

RECEIVED AUG 30 1985 ENGINEERING DIVISION

DRAINAGE PLAN

BAUGHMAN COMPANY, P.A.
SURVEYING & ENGINEERING
316/262-7271 • 315 ELLIS • WICHITA, KANSAS 67211

25 Aug 1985