


TYPICAL VIEW OUT  
NO SCALE

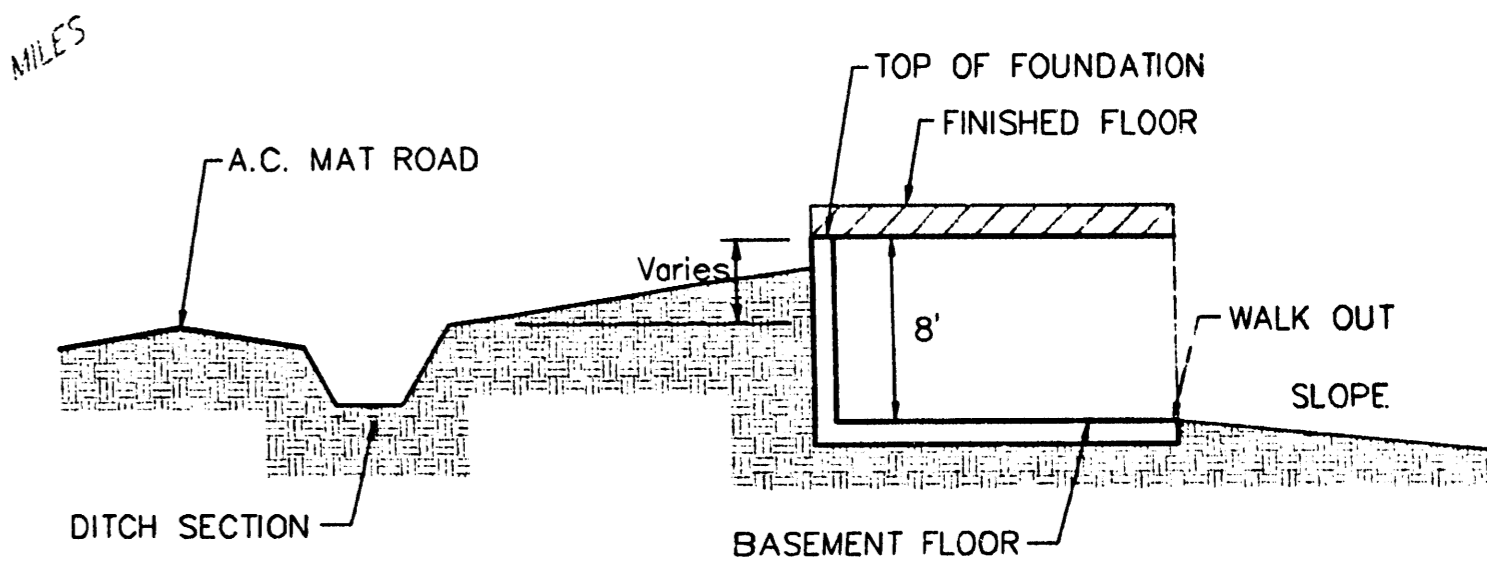

TYPICAL WALK OUT  
NO SCALE


BENCHMARK:  
TOP OF 1" IRON, 12" DEEP, E1/4 COR.,  
SEC. 27, T16N-35R-2W  
ELEV. = 1386.53 M.S.L.  
(200.13 CITY DATUM)

Revised Lot 12, Blk A to W.O. 7/23/03 by AEG  
Revised 7/8/02 by AEG per NBW

<b>REECE FARMS ESTATES</b>			
<b>GRADING PLAN</b>			
WICHITA, KANSAS			
<b>BAUGHMAN COMPANY P. A.</b>			
ENGINEERING, SURVEYING, & PLANNING			
316-262-7271 • 315 ELLIS • WICHITA, KANSAS 67211			
PROJECT NUMBER			SHEET
316-262-7271			2
DESIGN	DRAWN	APPROVED	DATE
NBW	AHJ/UAB	NBW	6/15/98
SCALE		1" = 60'	
		3	

REECE FARMS ESTATES 97-109-EB33

MATCH LINE



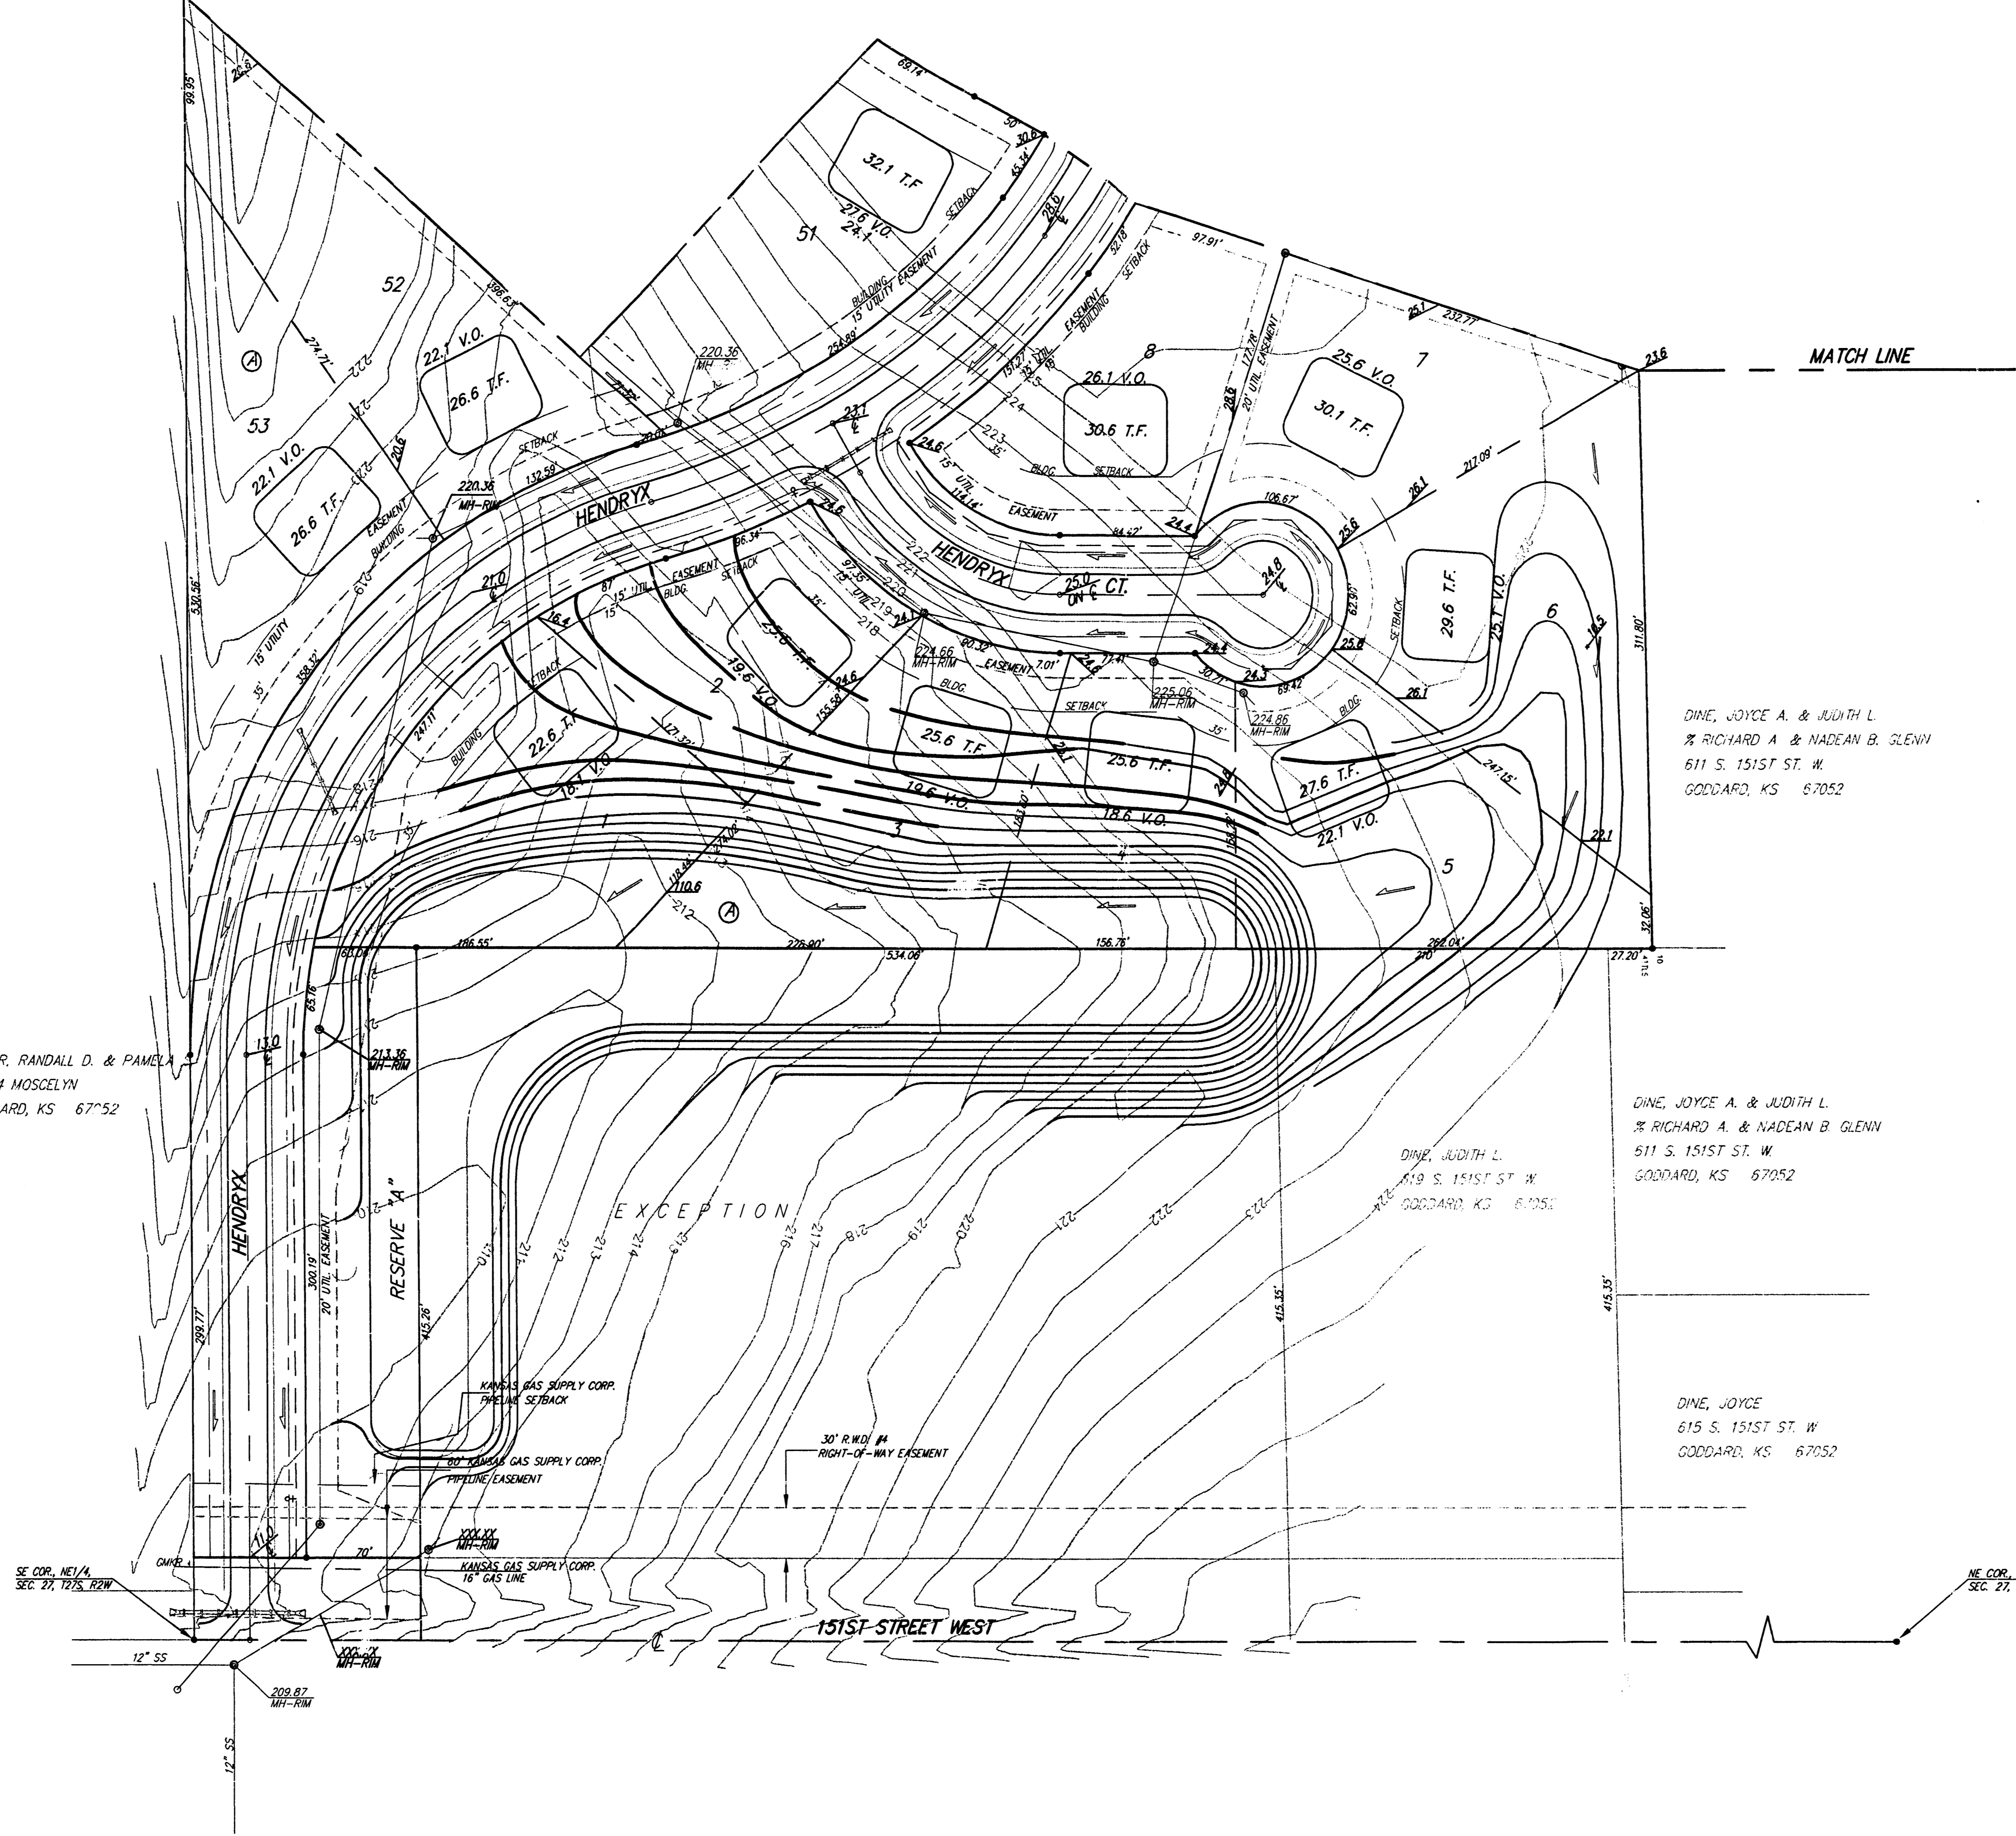


RAYER, RANDALL D. & PAMELA  
15534 MOSCELYN  
GODDARD, KS 67052


DINE, JOYCE A. & JUDITH L.  
RICHARD A. & NADAN B. GLENN  
611 S. 151ST ST. W.  
GODDARD, KS 67052

DINE, JOYCE A. & JUDITH L.  
RICHARD A. & NADAN B. GLENN  
611 S. 151ST ST. W.  
GODDARD, KS 67052

DINE, JOYCE  
615 S. 151ST ST. W.  
GODDARD, KS 67052

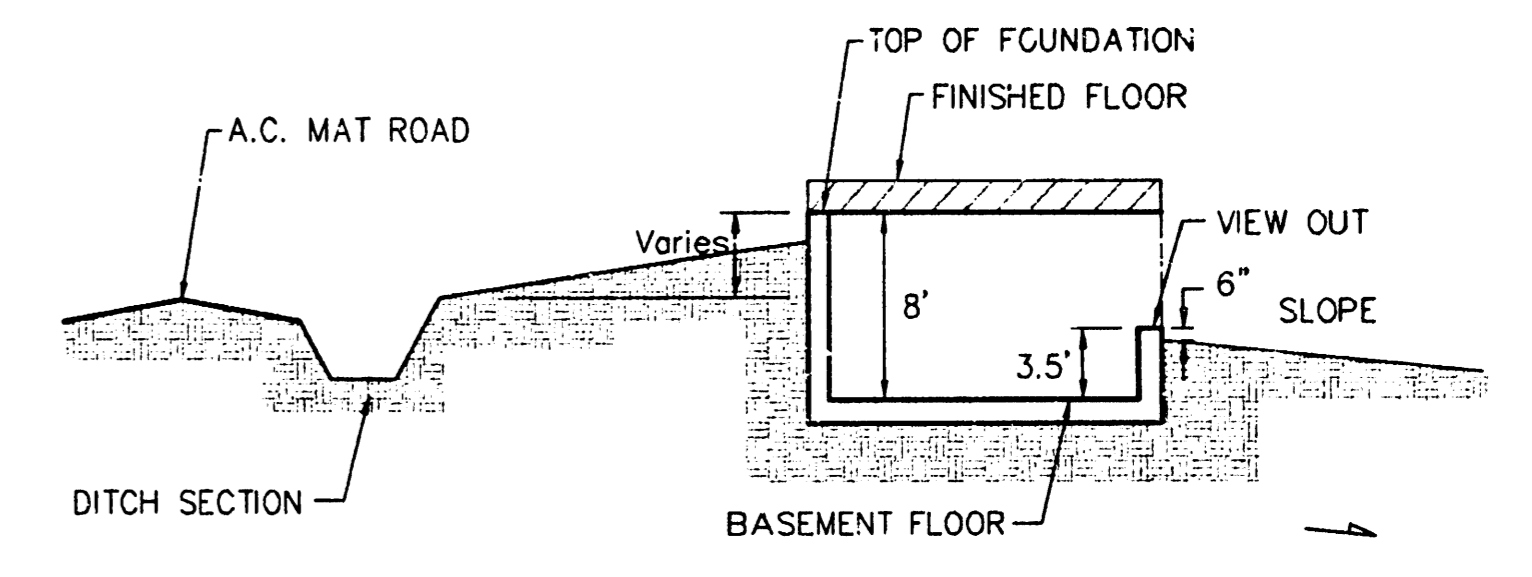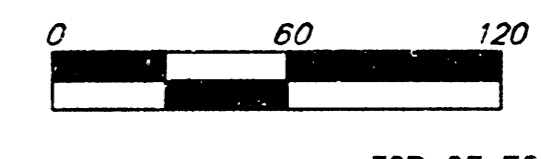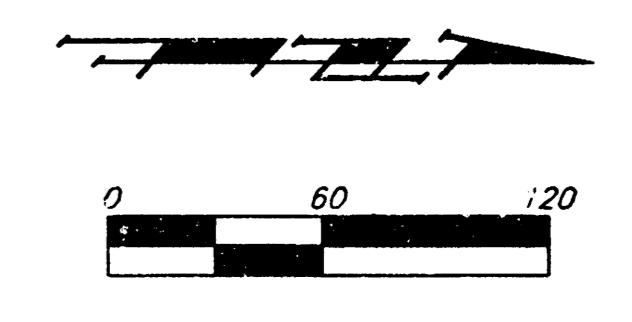

TYPICAL VIEW OUT  
NO SCALE

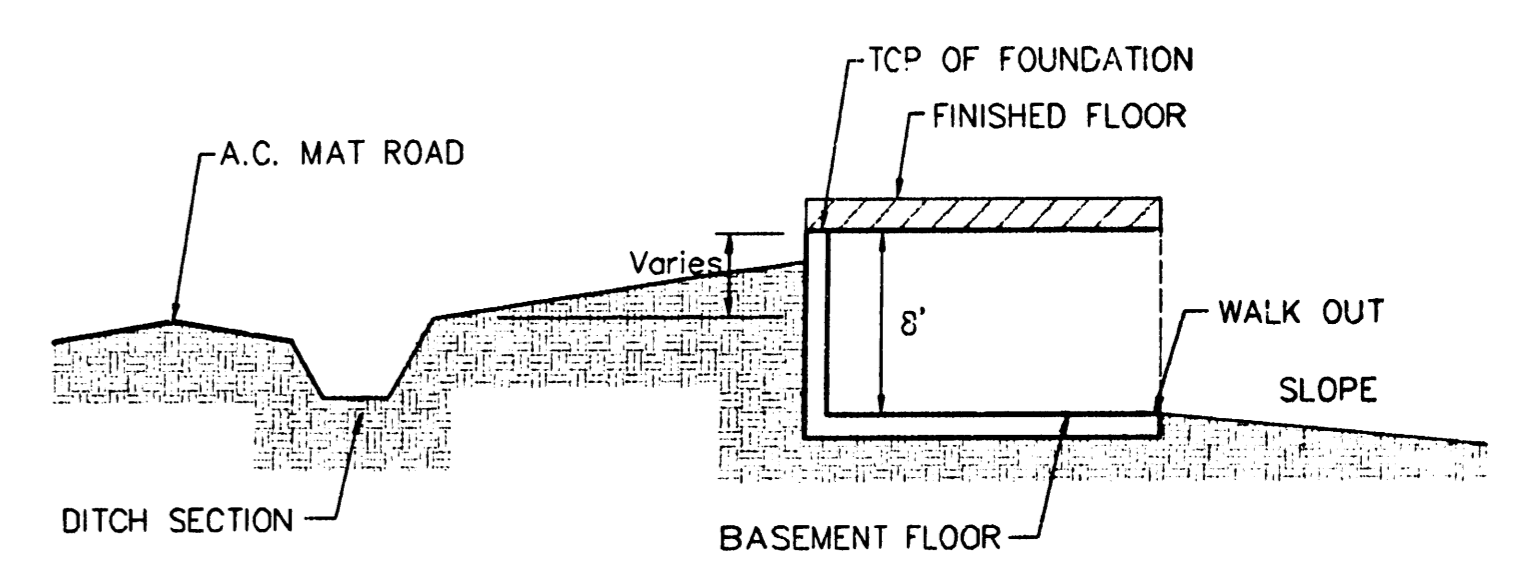

TYPICAL WALK OUT  
NO SCALE

BENCHMARK:  
TOP OF 1\"/>

MINIMUM BUILDING PAD ELEVATION FOR LOWEST OPENING TO THE STRUCTURES			
LOT	BLOCK	ELEVATION	
		CITY DATUM	MSL
1-22	B	228.6	1416
19-28	A	223.6	1411
1,3,4,5	A	222.6	1410

**REECE FARMS ESTATES**  
**GRADING PLAN**  
WICHITA, KANSAS

**BAUGHMAN COMPANY P. A.**  
ENGINEERING, SURVEYING, & PLANNING  
316-262-7271 • 315 ELLIS • WICHITA, KANSAS 67211

DESIGN NBW	DRAWN AHH/JAB	APPROVED NBW	DATE 6/15/98	SCALE 1"=60'	PROJECT NUMBER 316-262-7271	SHEET <b>3</b>	OF <b>3</b>
---------------	------------------	-----------------	-----------------	-----------------	--------------------------------	-------------------	----------------

97-09-1831  
REECE/CR