



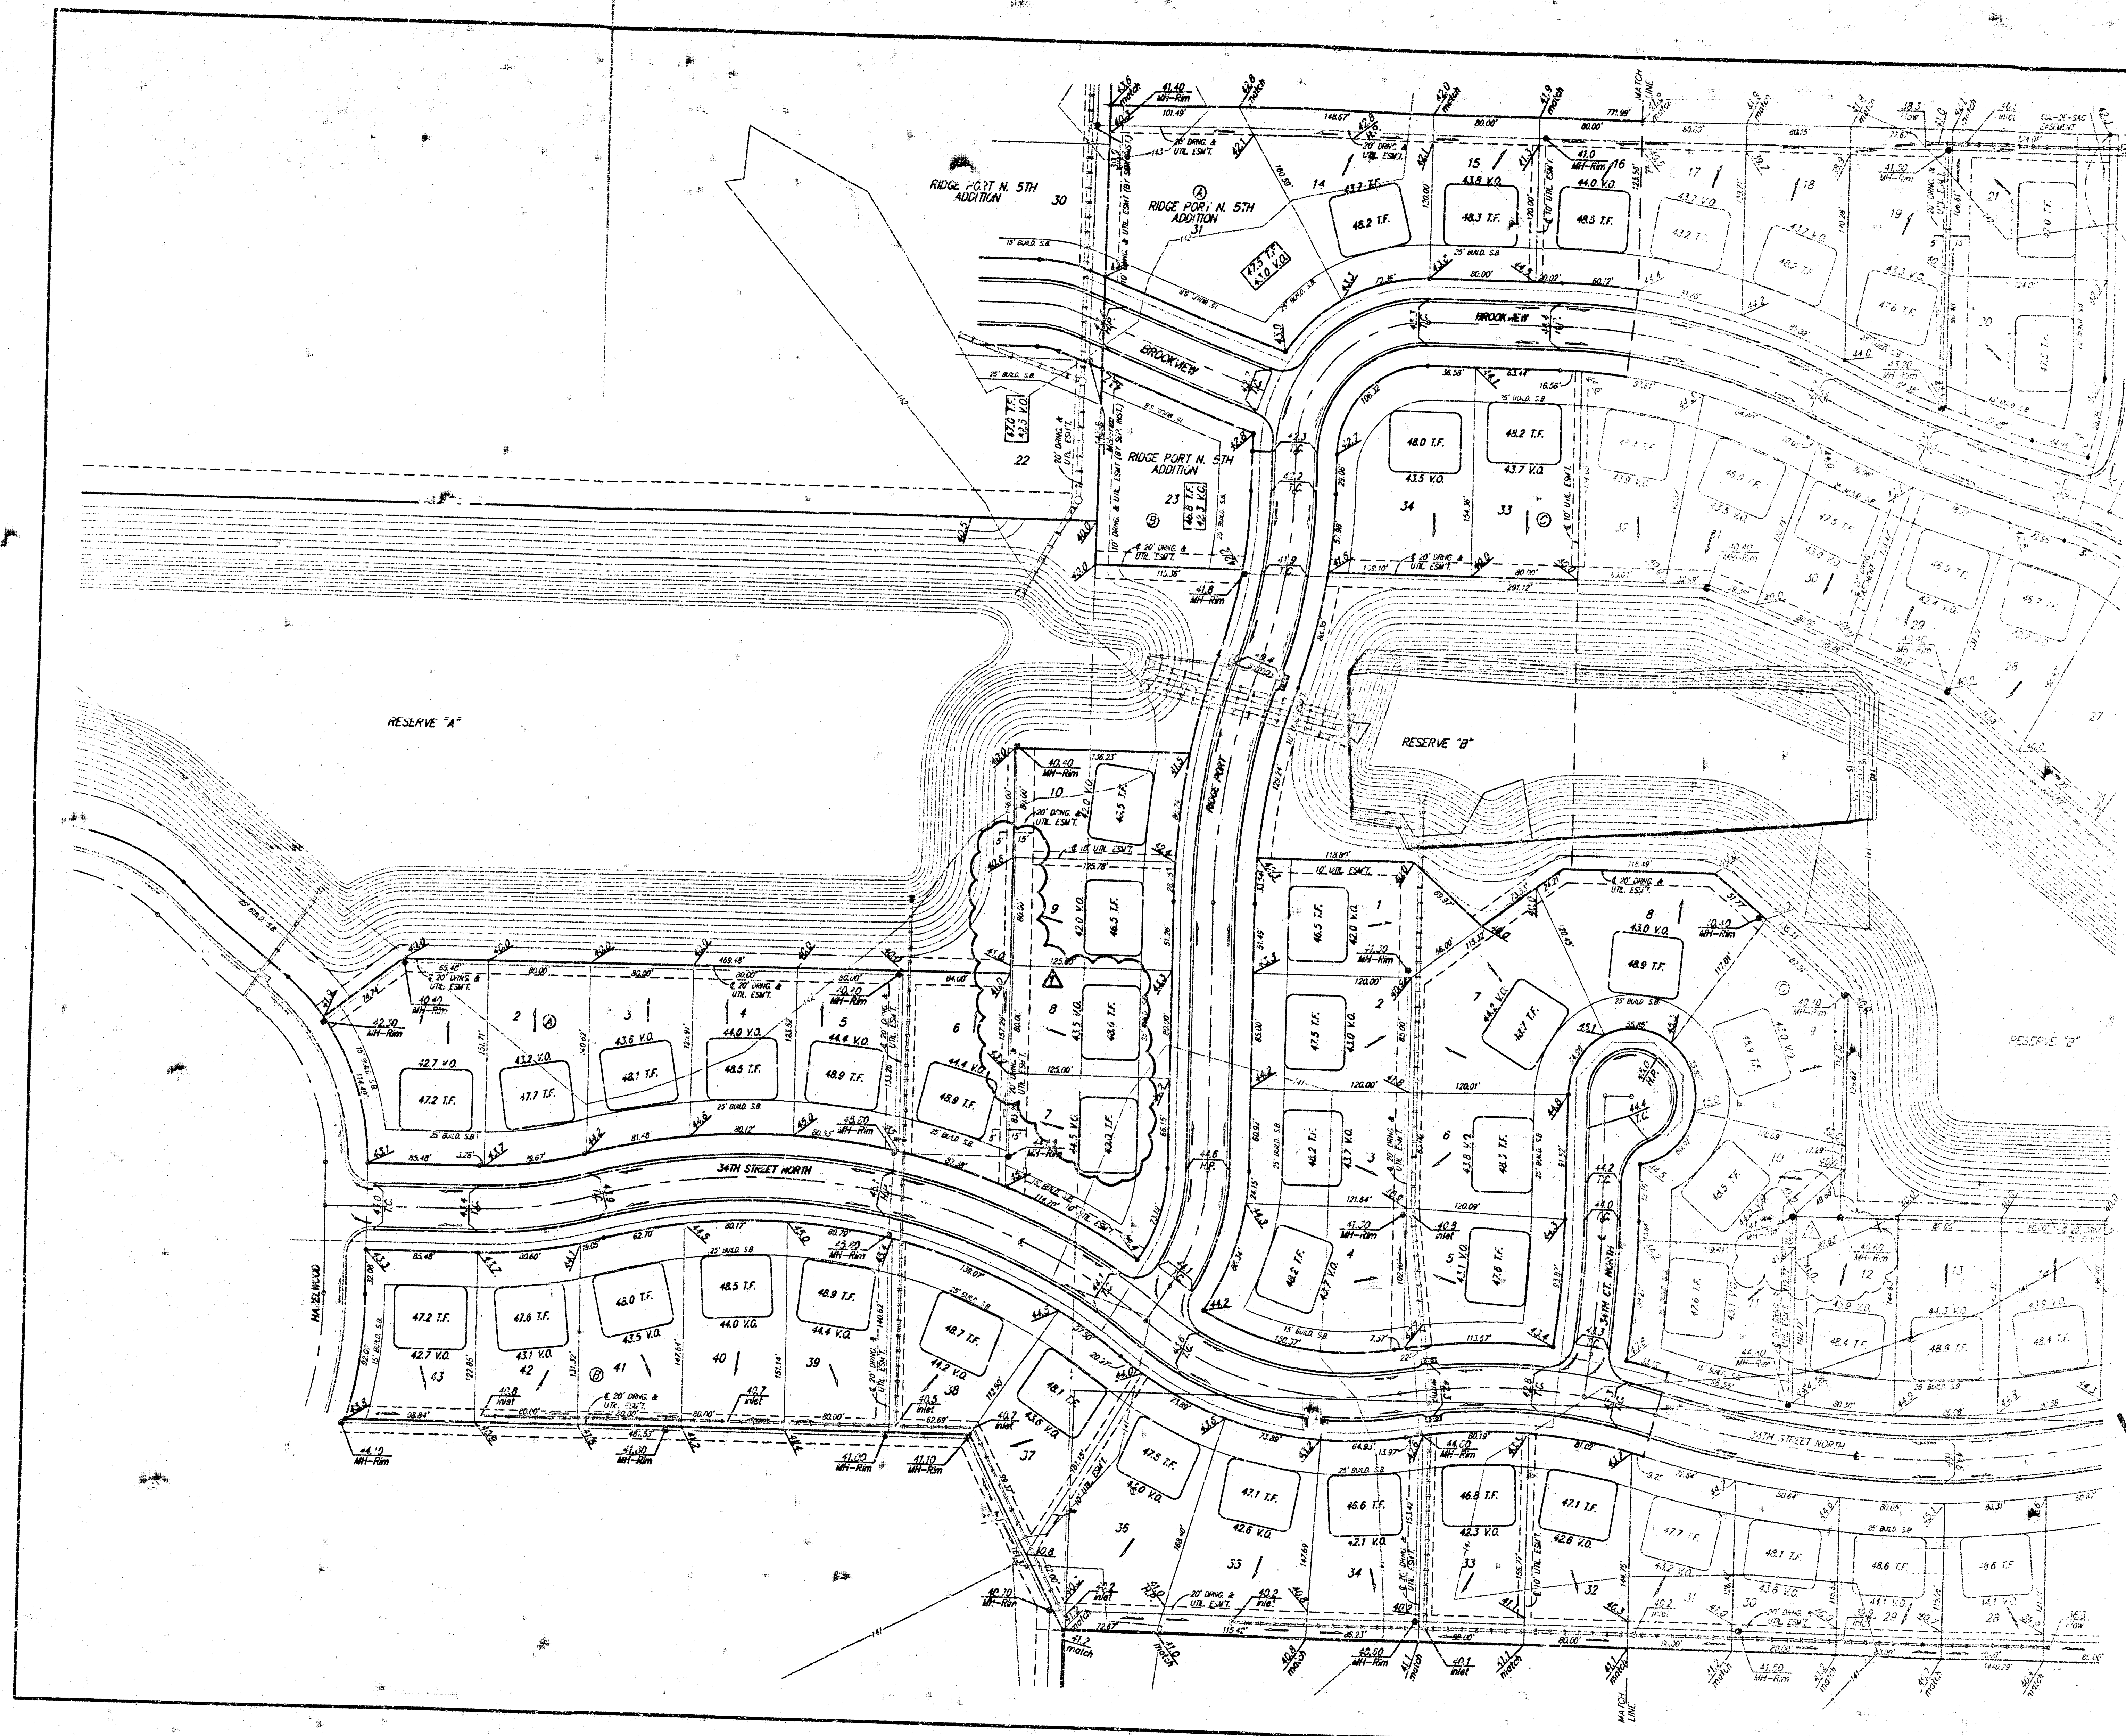

SCALE: 1" = 50'
 1" = 100'

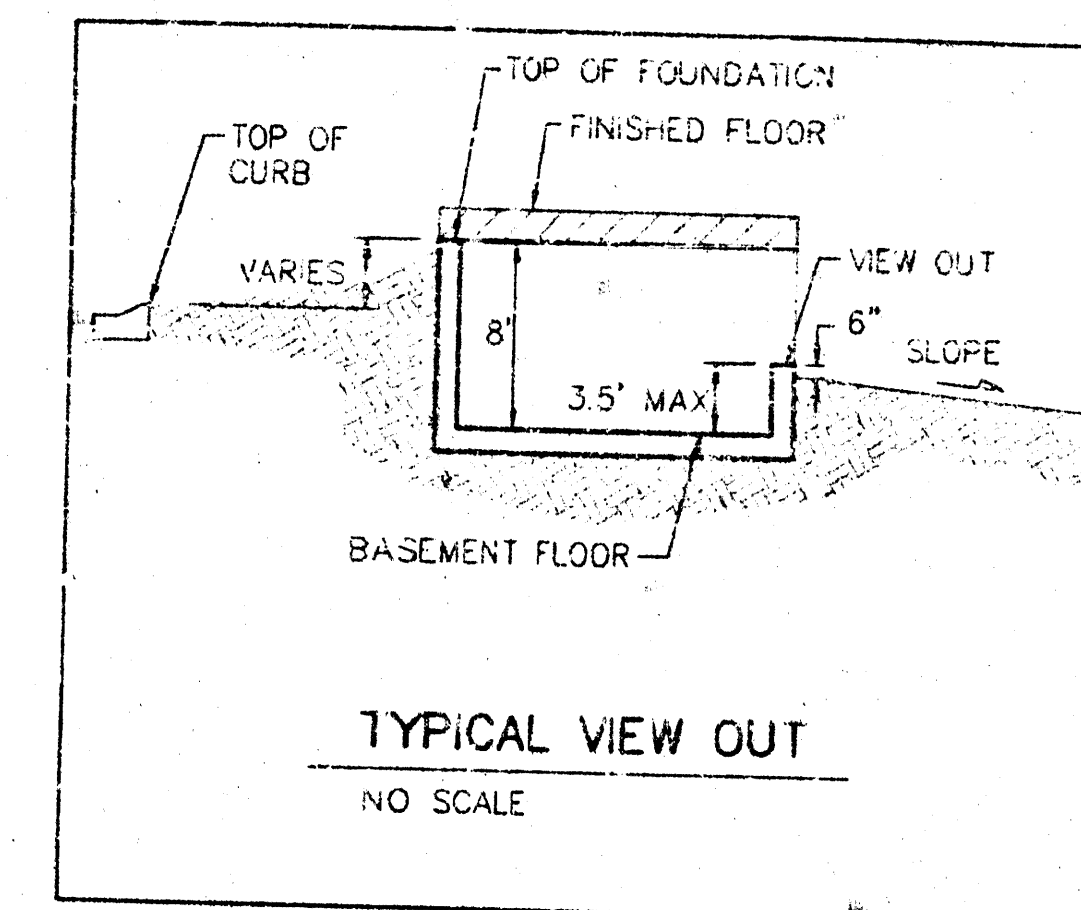

NOTE:
 Proposed top of foundation elevations are shown on plans. Contractor to set finish floor elevation.
 All street elevations shown on plans are for top of curb (full height).
 View-out elevations are denoted as XXX V.O.
 Additional fill or deep footings may be required for pad elevations denoted with an asterisk (*)

BENCHMARK:
 City Disc at the SW Corner of R.C.B.C. for Big Slough AR
 Ridge Road
 Elev = 144.22 City Datum (1331.62 NGVD)


**APPROVED
 DRAINAGE PLAN**

NOTE:
 A master grading plan has been developed for this subdivision and is on file with the City of Wichita, Kansas. All drainage easements, rights-of-way or easements shall remain at established grades or as modified with the approval of the city engineer of the City of Wichita, Kansas. No obstructions which impede the flow of this drainage system shall be allowed.


- REVISD 11/27/02 by AEG - Rapid of Lots to Ridge Port N. 5th
- REVISD 7/24/02 by AEG per NEW - top of foundations
- REVISD 4/10/02 by CNK per NEW - grades and SMS alignment
- REVISD 4/5/02 by AEG per NEW

RIDGE PORT NORTH 4TH ADDITION			
GRADING PLAN			
WICHITA, KANSAS			
BAUGHMAN COMPANY P.A.			
ENGINEERING, SURVEYING, & PLANNING			
313-262-7271 • 315 ELLIS • WICHITA, KANSAS 67201			
PROJECT NUMBER			
DILSON	DRAWN	APPROVED	DATE
	ELS		3/12/2001
SCALE			NOTED
			1
			2

RED'D IN ENGINEERING & OCT 15 2001

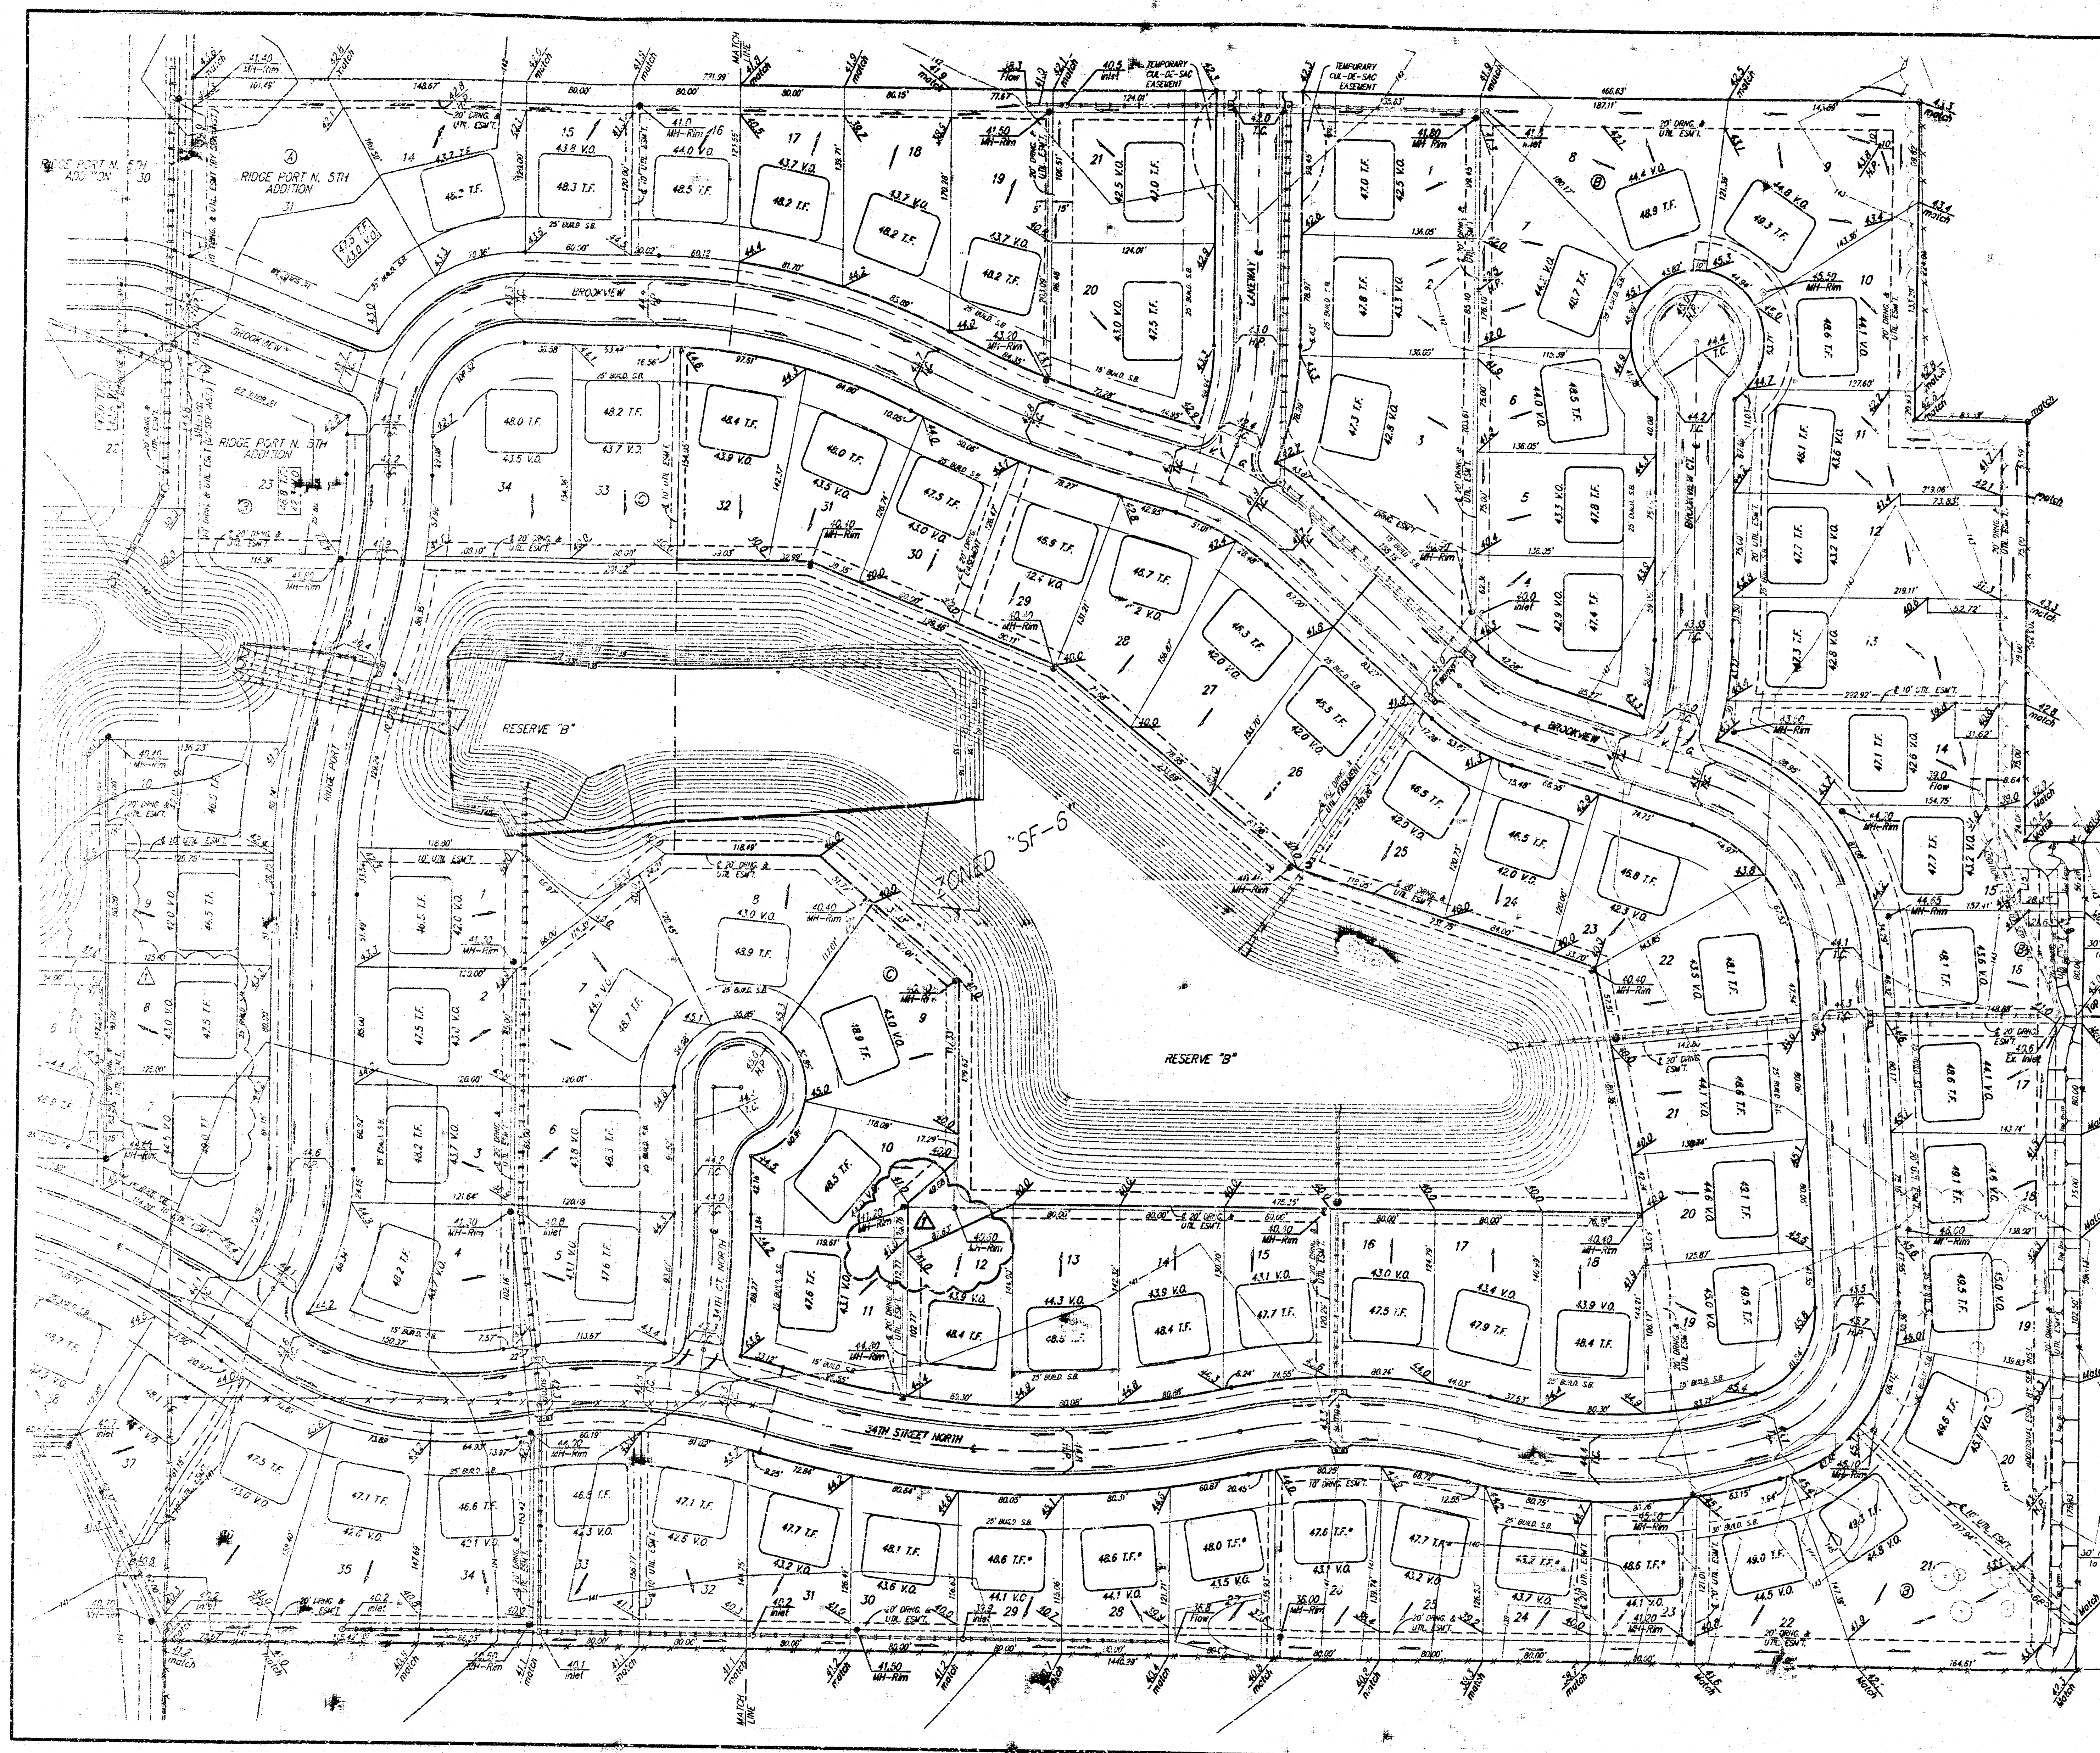

SCALE: 1" = 60'
• = Iron

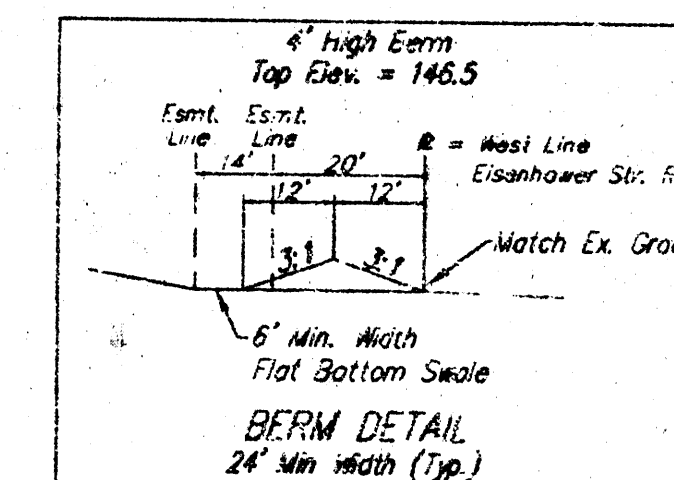

- REVISION 11/25/02 by AEG - berm and grades along west line and Haplet of Lora to Ridge Port N. 5th
- REVISION 7/24/02 by AEG per NEM - top of foundations
- REVISION 4/10/02 by GGT per NEM - grades and SMS equipment
- REVISION 4/5/02 by AEG per NEM

RIDGE PORT NORTH 4TH ADDITION
GRADING PLAN
 WICHITA, KANSAS

BAUGHMAN COMPANY P.A.
 ENGINEERING, SURVEYING, & PLANNING
 316-262-7271 • 315 ELLIS • WICHITA, KANSAS 67211

PROJECT NUMBER: _____

DESIGN	DRAWN	APPROVED	DATE	SCALE	SHEET
	BLG		3/12/2001	NOTED	29