


SCALE: 1" = 60'  
• = Iron

APPROVED  
DRAINAGE PLAN

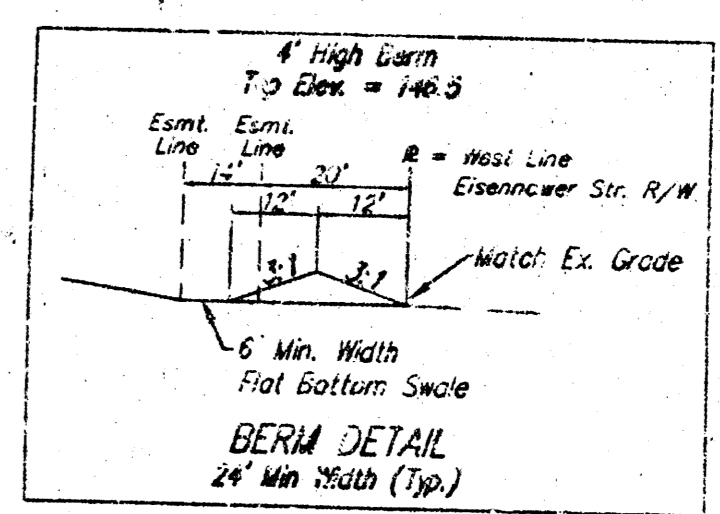

- REVISION 8/15/13 by AEG - T.F. & V.O. for Lot 13, Block C
- REVISION 11/25/12 by AEG - berm and grades along east line adjacent to Lot 13 to Ridge Port N. 5th
- REVISION 7/24/12 by AEG per NEM - top of foundations
- REVISION 4/10/12 by UNK per NEM - grades and SMS alignment
- REVISION 4/9/12 by AEG per NEM

**RIDGE PORT NORTH 4TH ADDITION**  
**GRADING PLAN**  
WICHITA, KANSAS

**BAUGHMAN COMPANY P.A.**  
ENGINEERING, SURVEYING, & PLANNING  
310-282-7271 • 310-282-7272 • WICHITA, KANSAS

PROJECT NUMBER		SHEET	
DESIGN	DRAMA	APPROV'D	DATE
BLG		3/12/2011	SCALE
			NOTED

SHEET 2 OF 2