SAND
(Drainage)

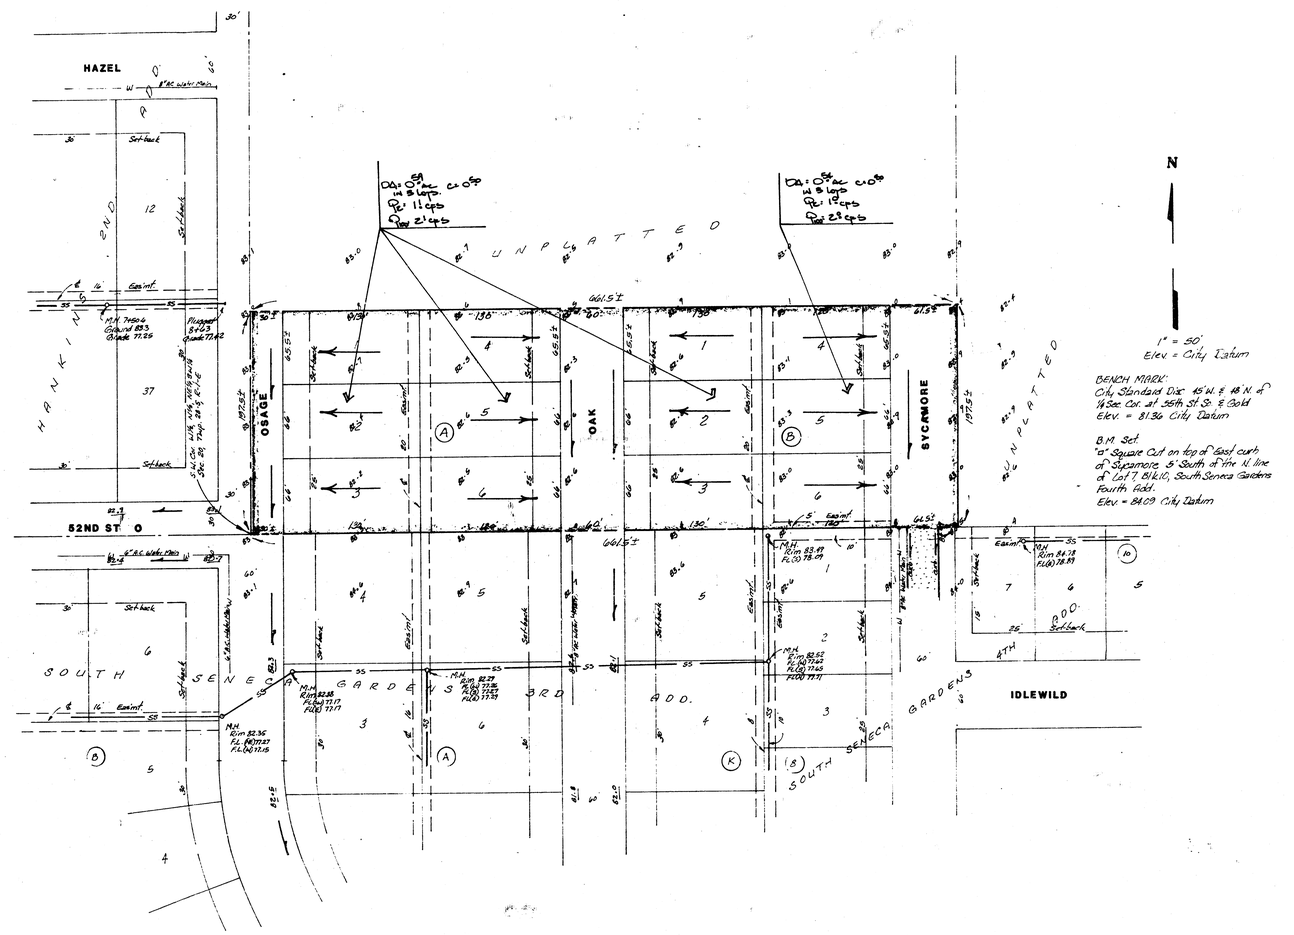

PRELIMINARY PLAT

SAND ADDITION

PART OF THE SW1/4 OF SEC 20 TWP 28-S R-1-E

GEORGE D HORN

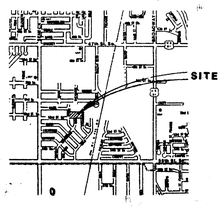

VICINITY PLAT

N. BRENT WOOTEN
LICENSED
6470
KANSAS
PROFESSIONAL ENGINEER

DRAINAGE CONCEPT

11/6/87

BAUGHMAN COMPANY, P.A.
SURVEYING & ENGINEERING
316/262-7271 • 315 ELLIS • WICHITA, KANSAS 67211

4 Nov 87

GENERAL NOTE

The residential lots will be developed to drain to the streets as indicated on the plan. Osage and Oak are both sand and gravel street and dicheas which drain south presently. Sycamore is paved and drains south also to storm sewers in the area.